



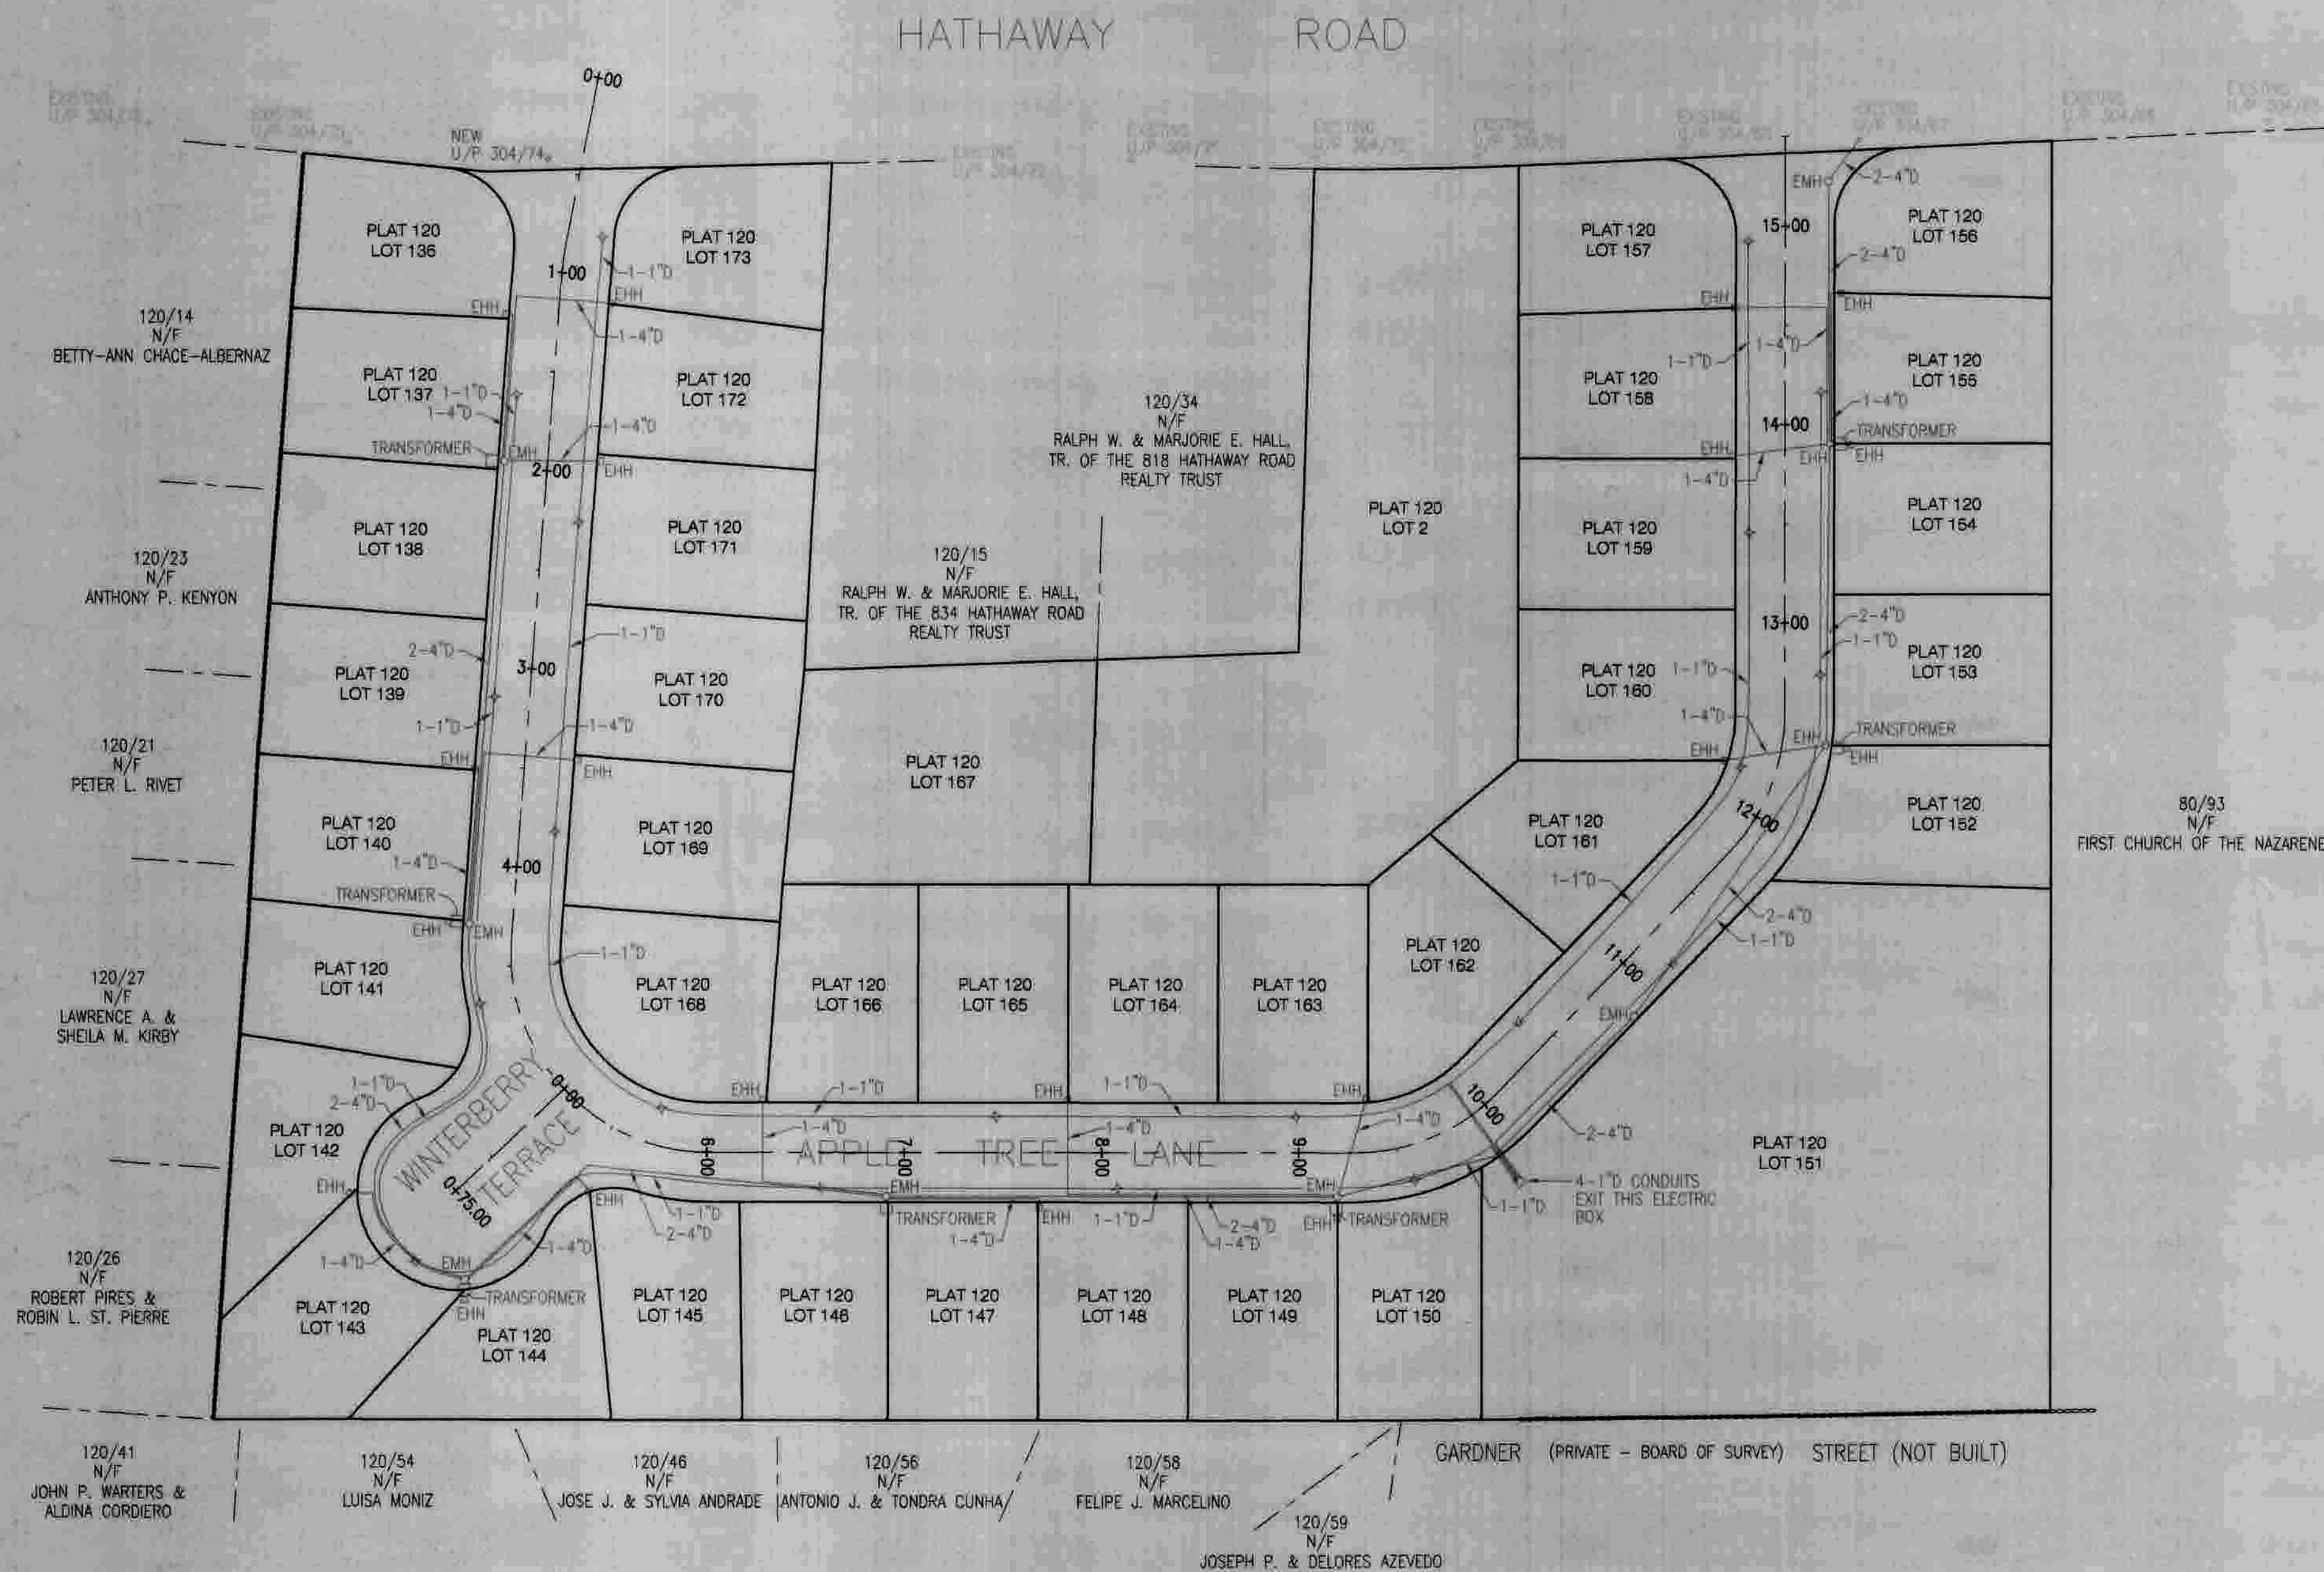

AS-BUILT
APPLE TREE LANE/WINTERBERRY TERRACE - STREET LIGHTING

FROM HATHAWAY ROAD 1,490 FEET TO TERMINUS

SCALES
HORIZONTAL: 1" = 60'
CONSTRUCTED BY: J.B. LANAGAN & ASSOCIATES
CONSTRUCTION COMPLETED: DECEMBER 2010

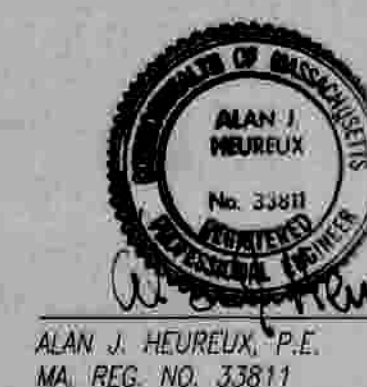

ALAN J. HEUREUX, P.E.
MA REG. NO. 33811

DATE
July 7, 2011

STREET LIGHTING RECORD PLAN
APPLETREE LANE & WINTERBERRY TERRACE
HALL ESTATES, NEW BEDFORD, MA

PREPARED BY
Boucher & Heureux, Inc.
CIVIL ENGINEERS & LAND SURVEYORS

648 AMERICAN LEGION HIGHWAY, SUITE ONE
WESTPORT, MASSACHUSETTS 02790
COPYRIGHT © 2011 BOUCHER & HEUREUX, INC.