


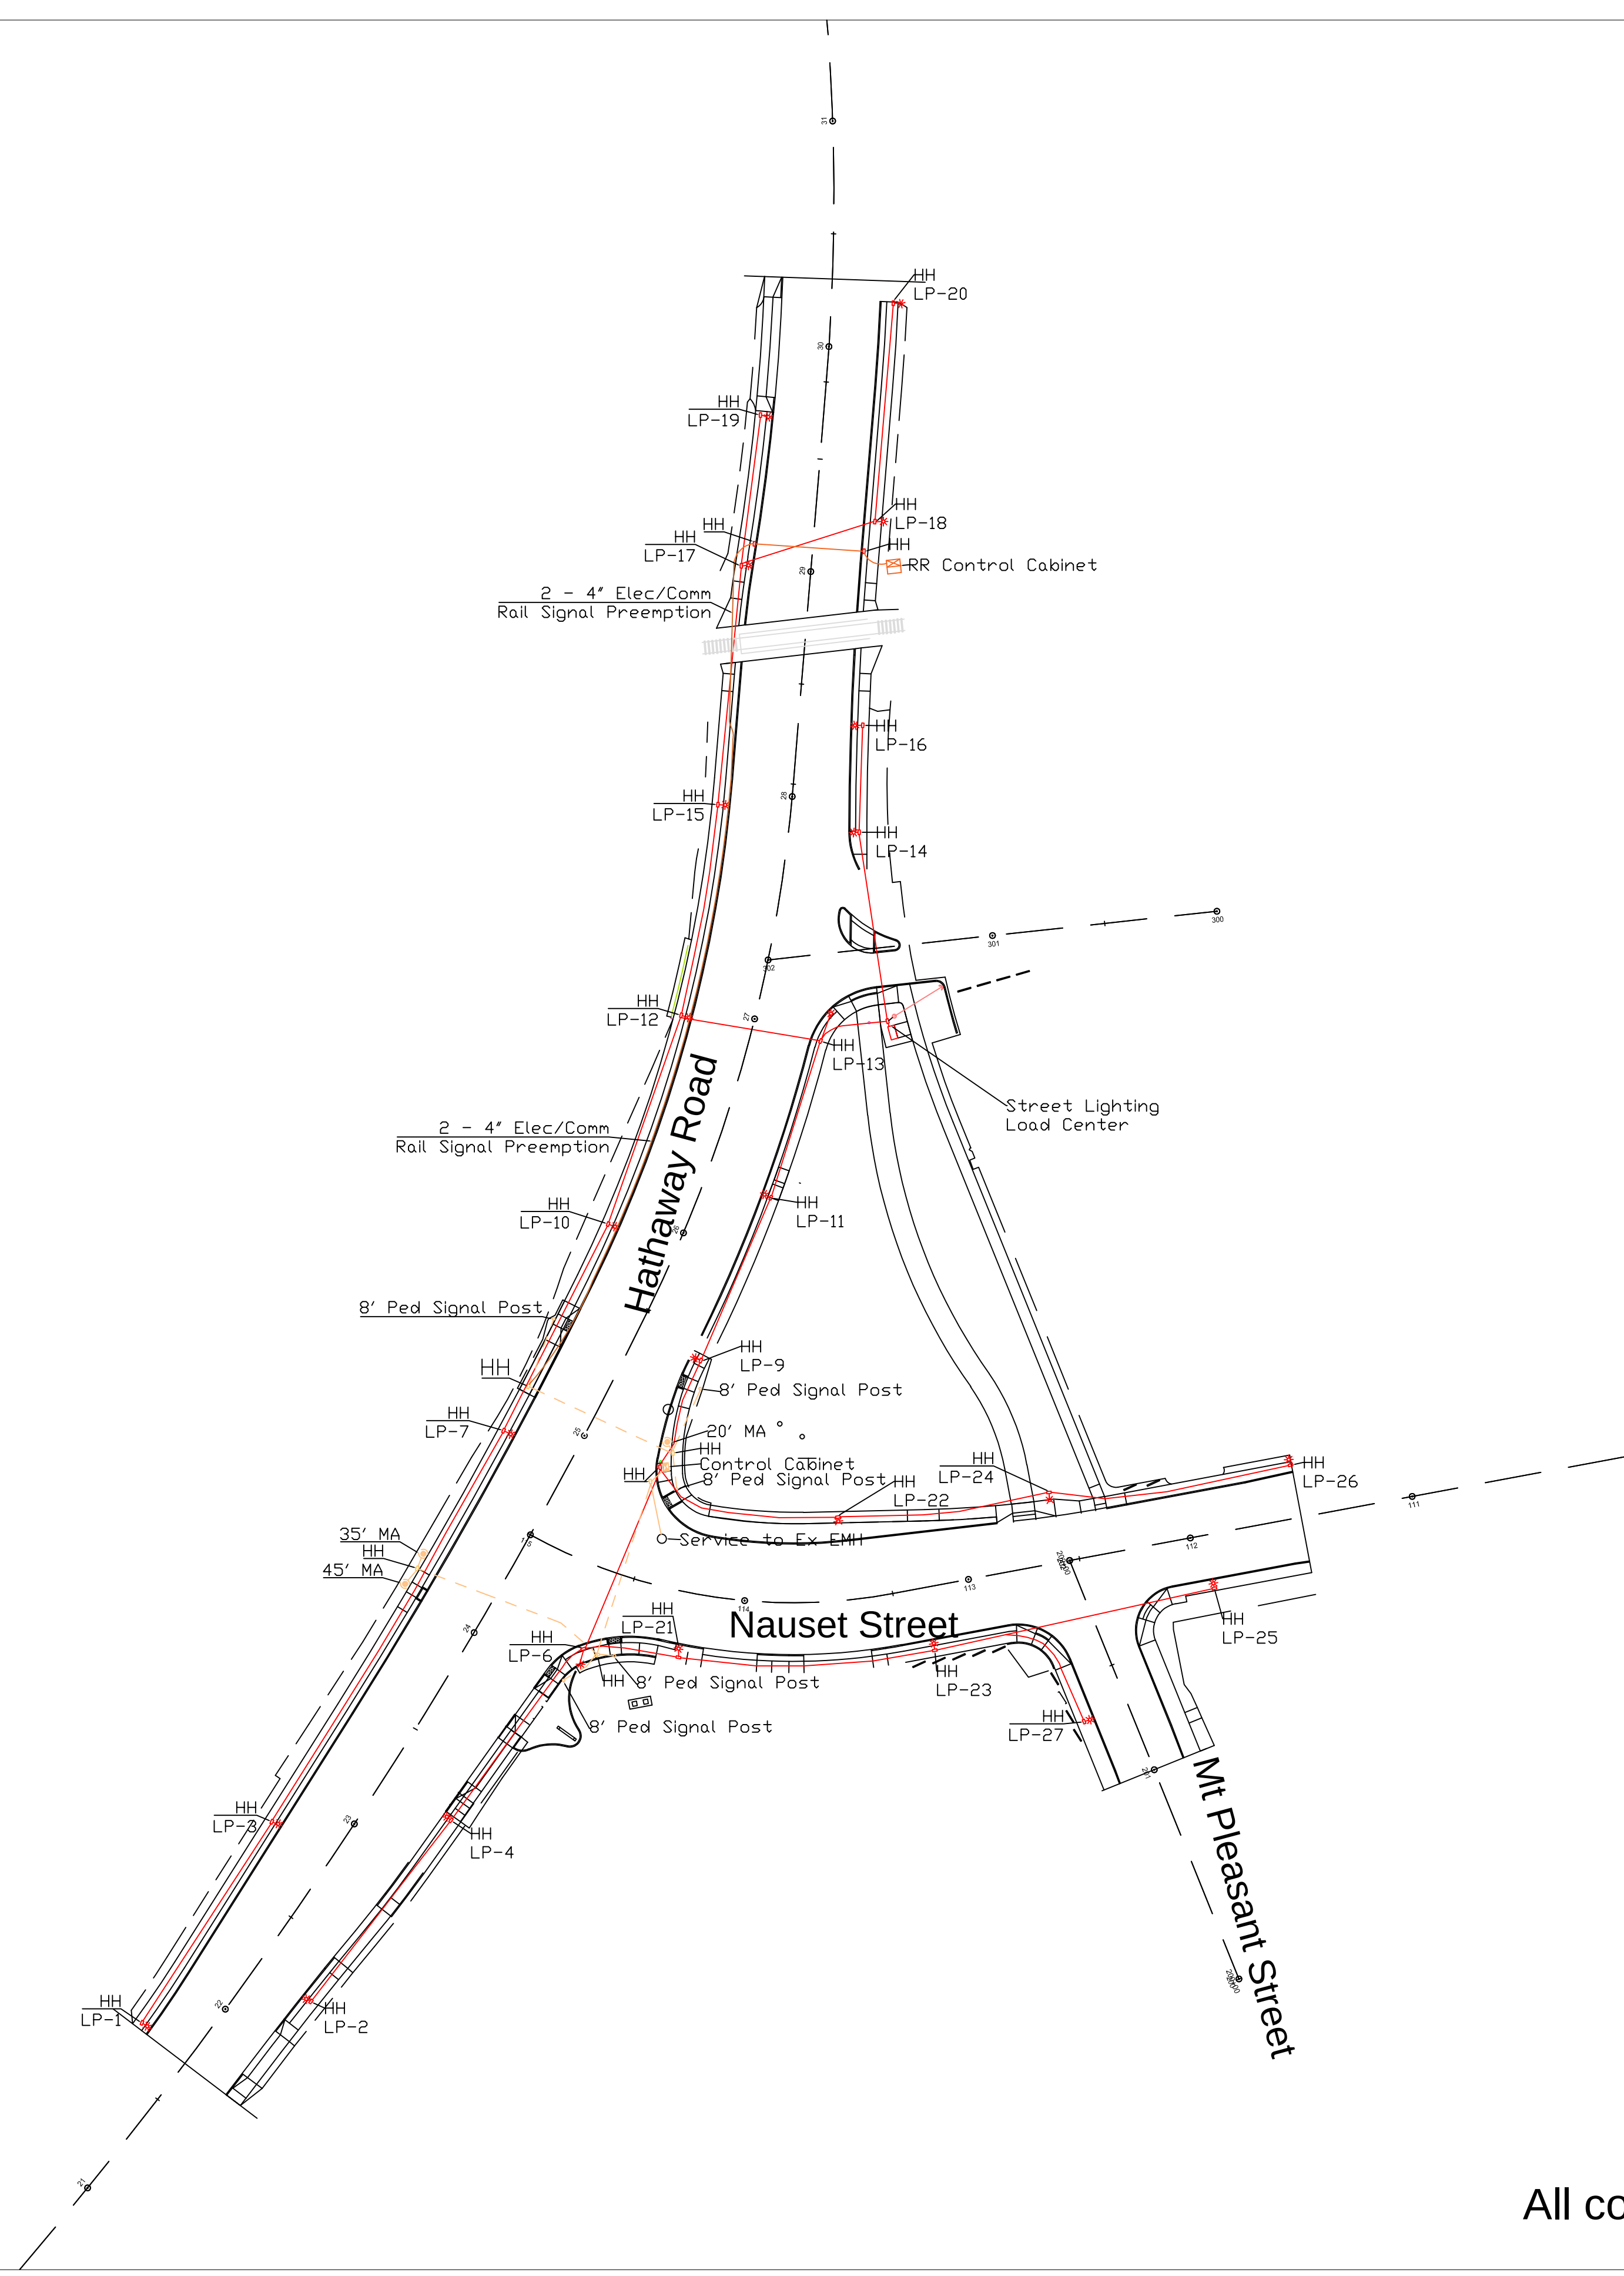

| CONDUIT AND WIRE LEGEND |                                   |
|-------------------------|-----------------------------------|
| NO.                     | DESCRIPTION                       |
| ①                       | 2"C., 2#8, 2#8 (RECEPTACLE), 1#8G |
| ②                       | 2"C., 2#8, 2#6 (RECEPTACLE), 1#6G |
| ③                       | 2"C., 2#8, 2#4 (RECEPTACLE), 1#4G |

All conduit 2.5' below finish grade

General Notes

Hathaway Road Electric Asbuilt


|     |                |      |
|-----|----------------|------|
| 1   | Electric       |      |
| No. | Revision/Issue | Date |

K.R.Rezendes, Inc.  
3 Sammys Lane  
Assonet, MA 02702

Project Name and Address  
Hathaway Road  
New Bedford, MA  
Contract # 110953

|                                 |             |
|---------------------------------|-------------|
| Drawing Set<br>Electric Asbuilt | Sheet<br>01 |
| Date<br>06/03/2023              |             |
| Scale<br>1:50                   |             |



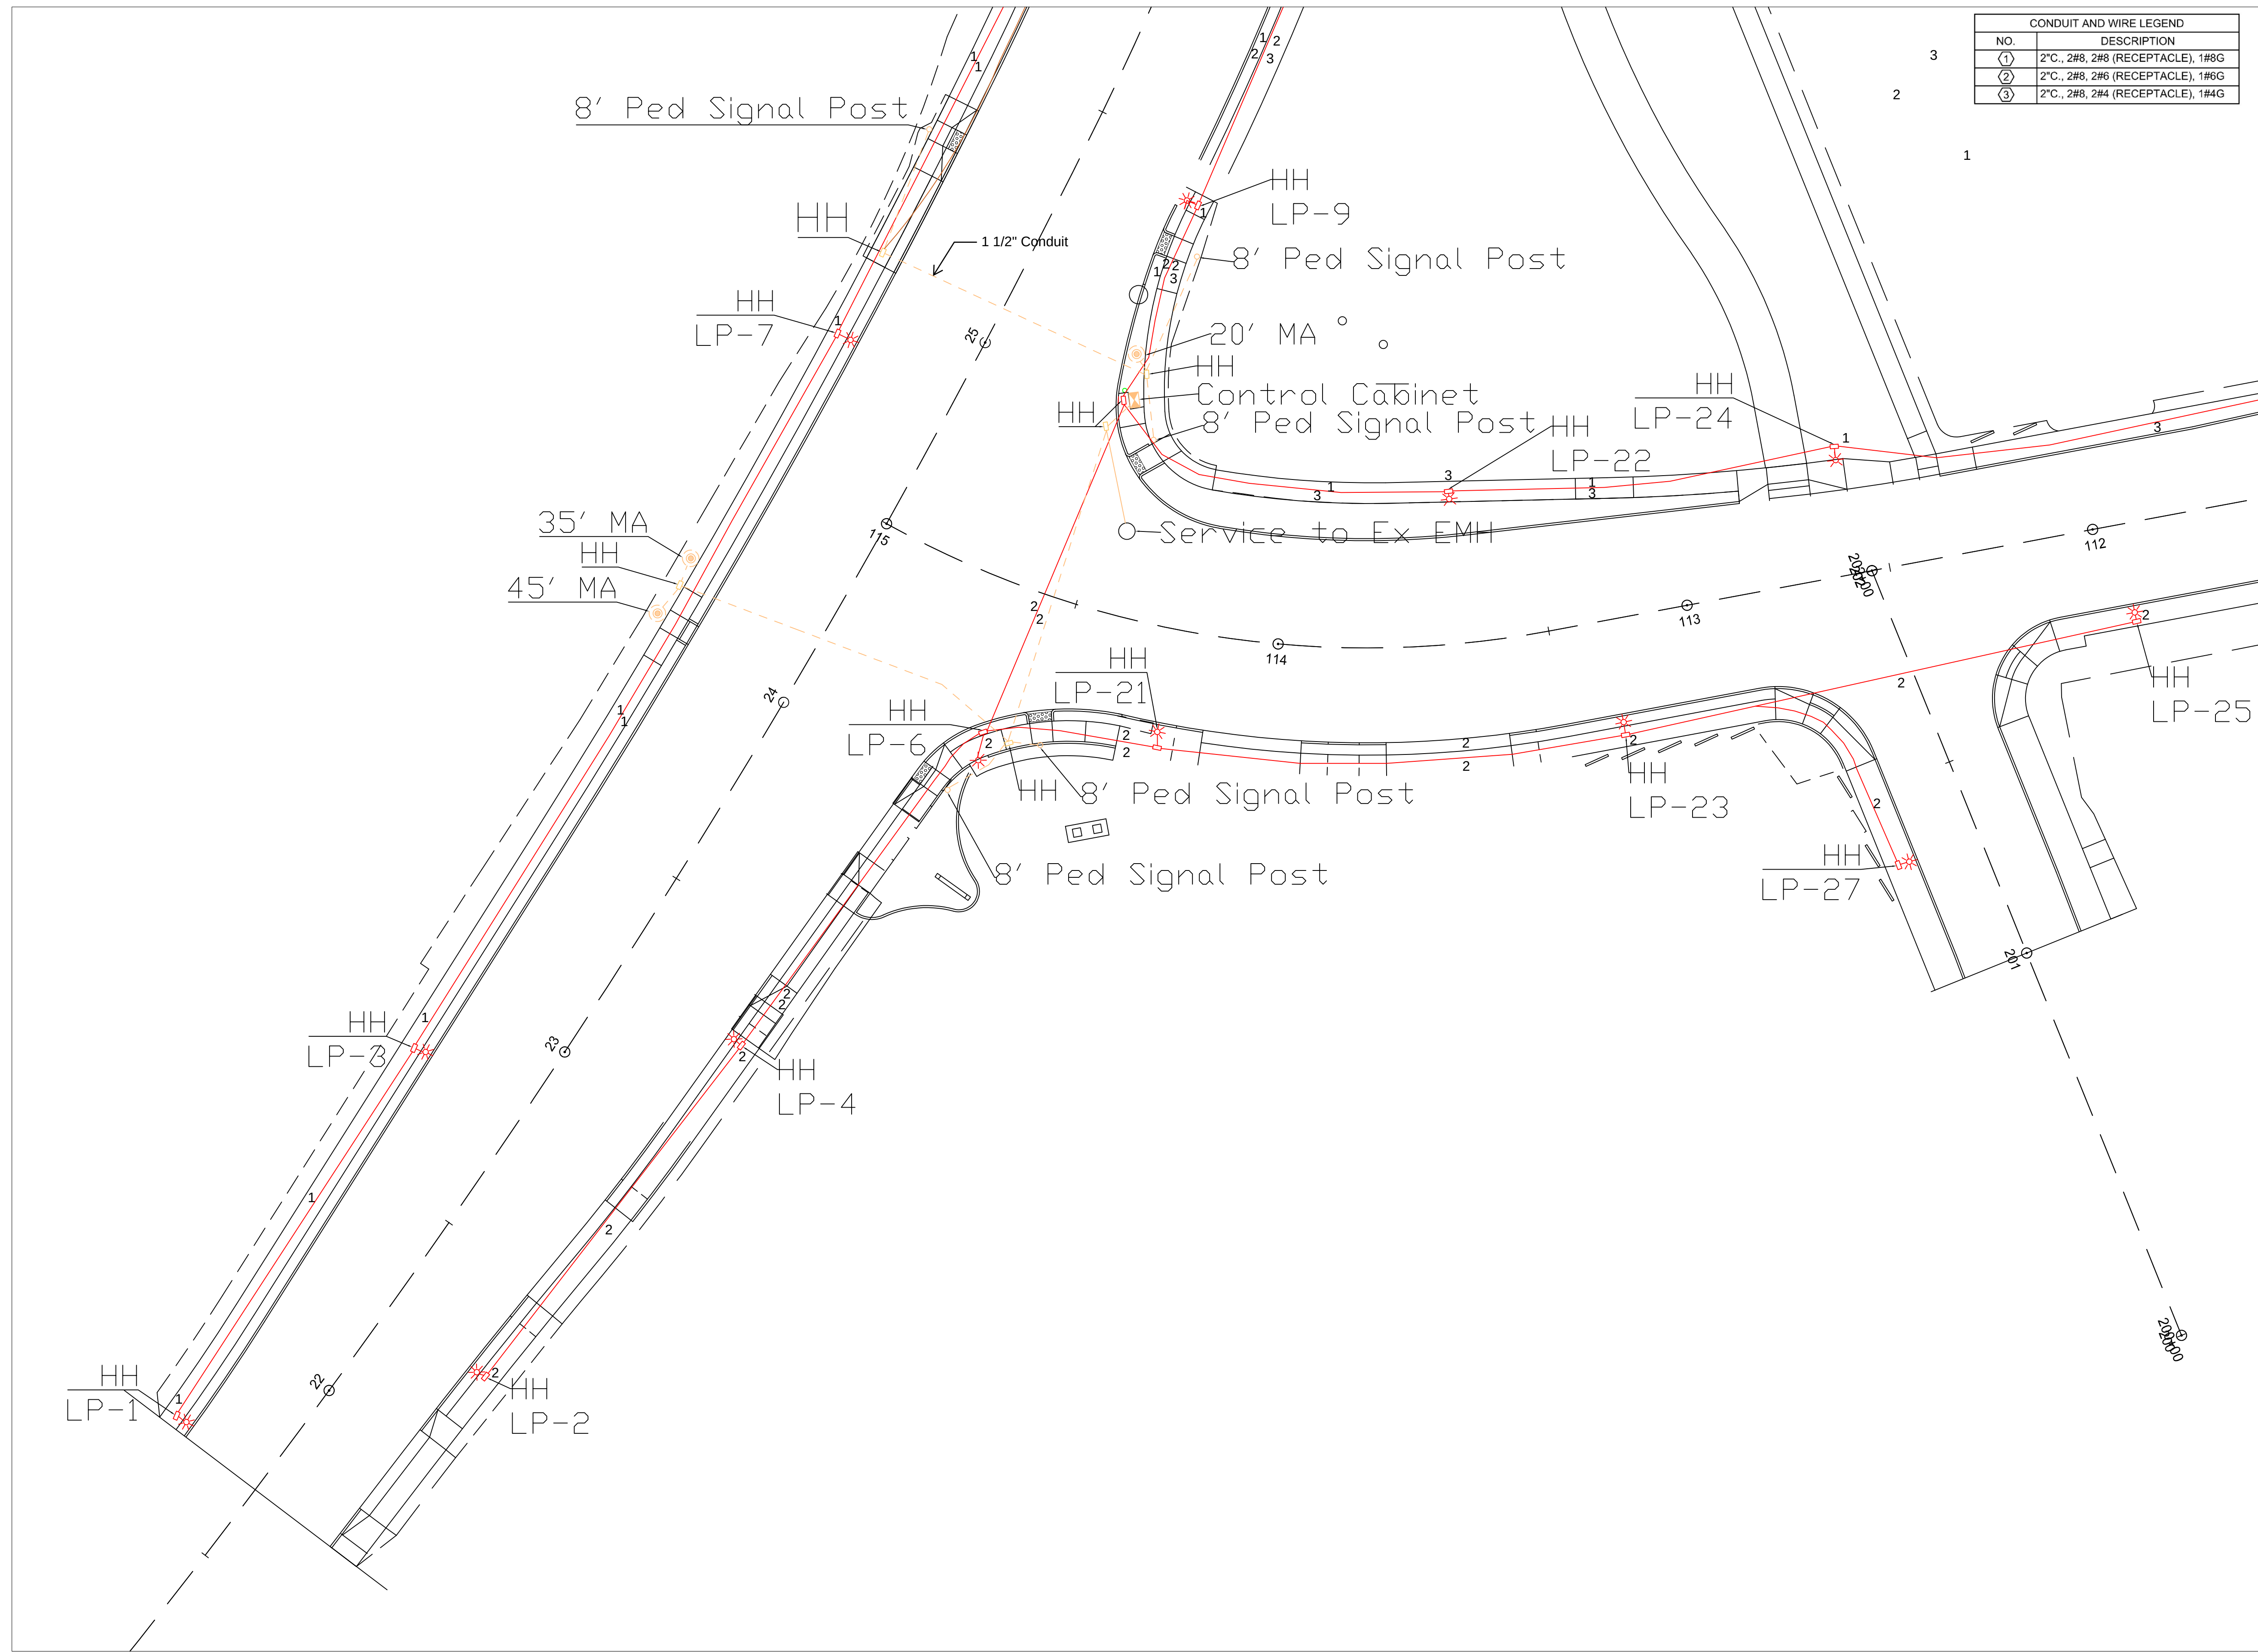

General Notes

Hathaway Road  
Electric  
Asbuilt


|     |                |      |
|-----|----------------|------|
| 1   | Electric       |      |
| No. | Revision/Issue | Date |

K.R.Rezendes, Inc.  
3 Sammys Lane  
Assonet, MA 02702

Project Name and Address  
Hathaway Road  
New Bedford, MA  
Contract # 110953

|                                 |             |
|---------------------------------|-------------|
| Drawing Set<br>Electric Asbuilt | Sheet<br>02 |
| Date<br>06/03/2023              |             |
| Scale<br>1:20                   |             |



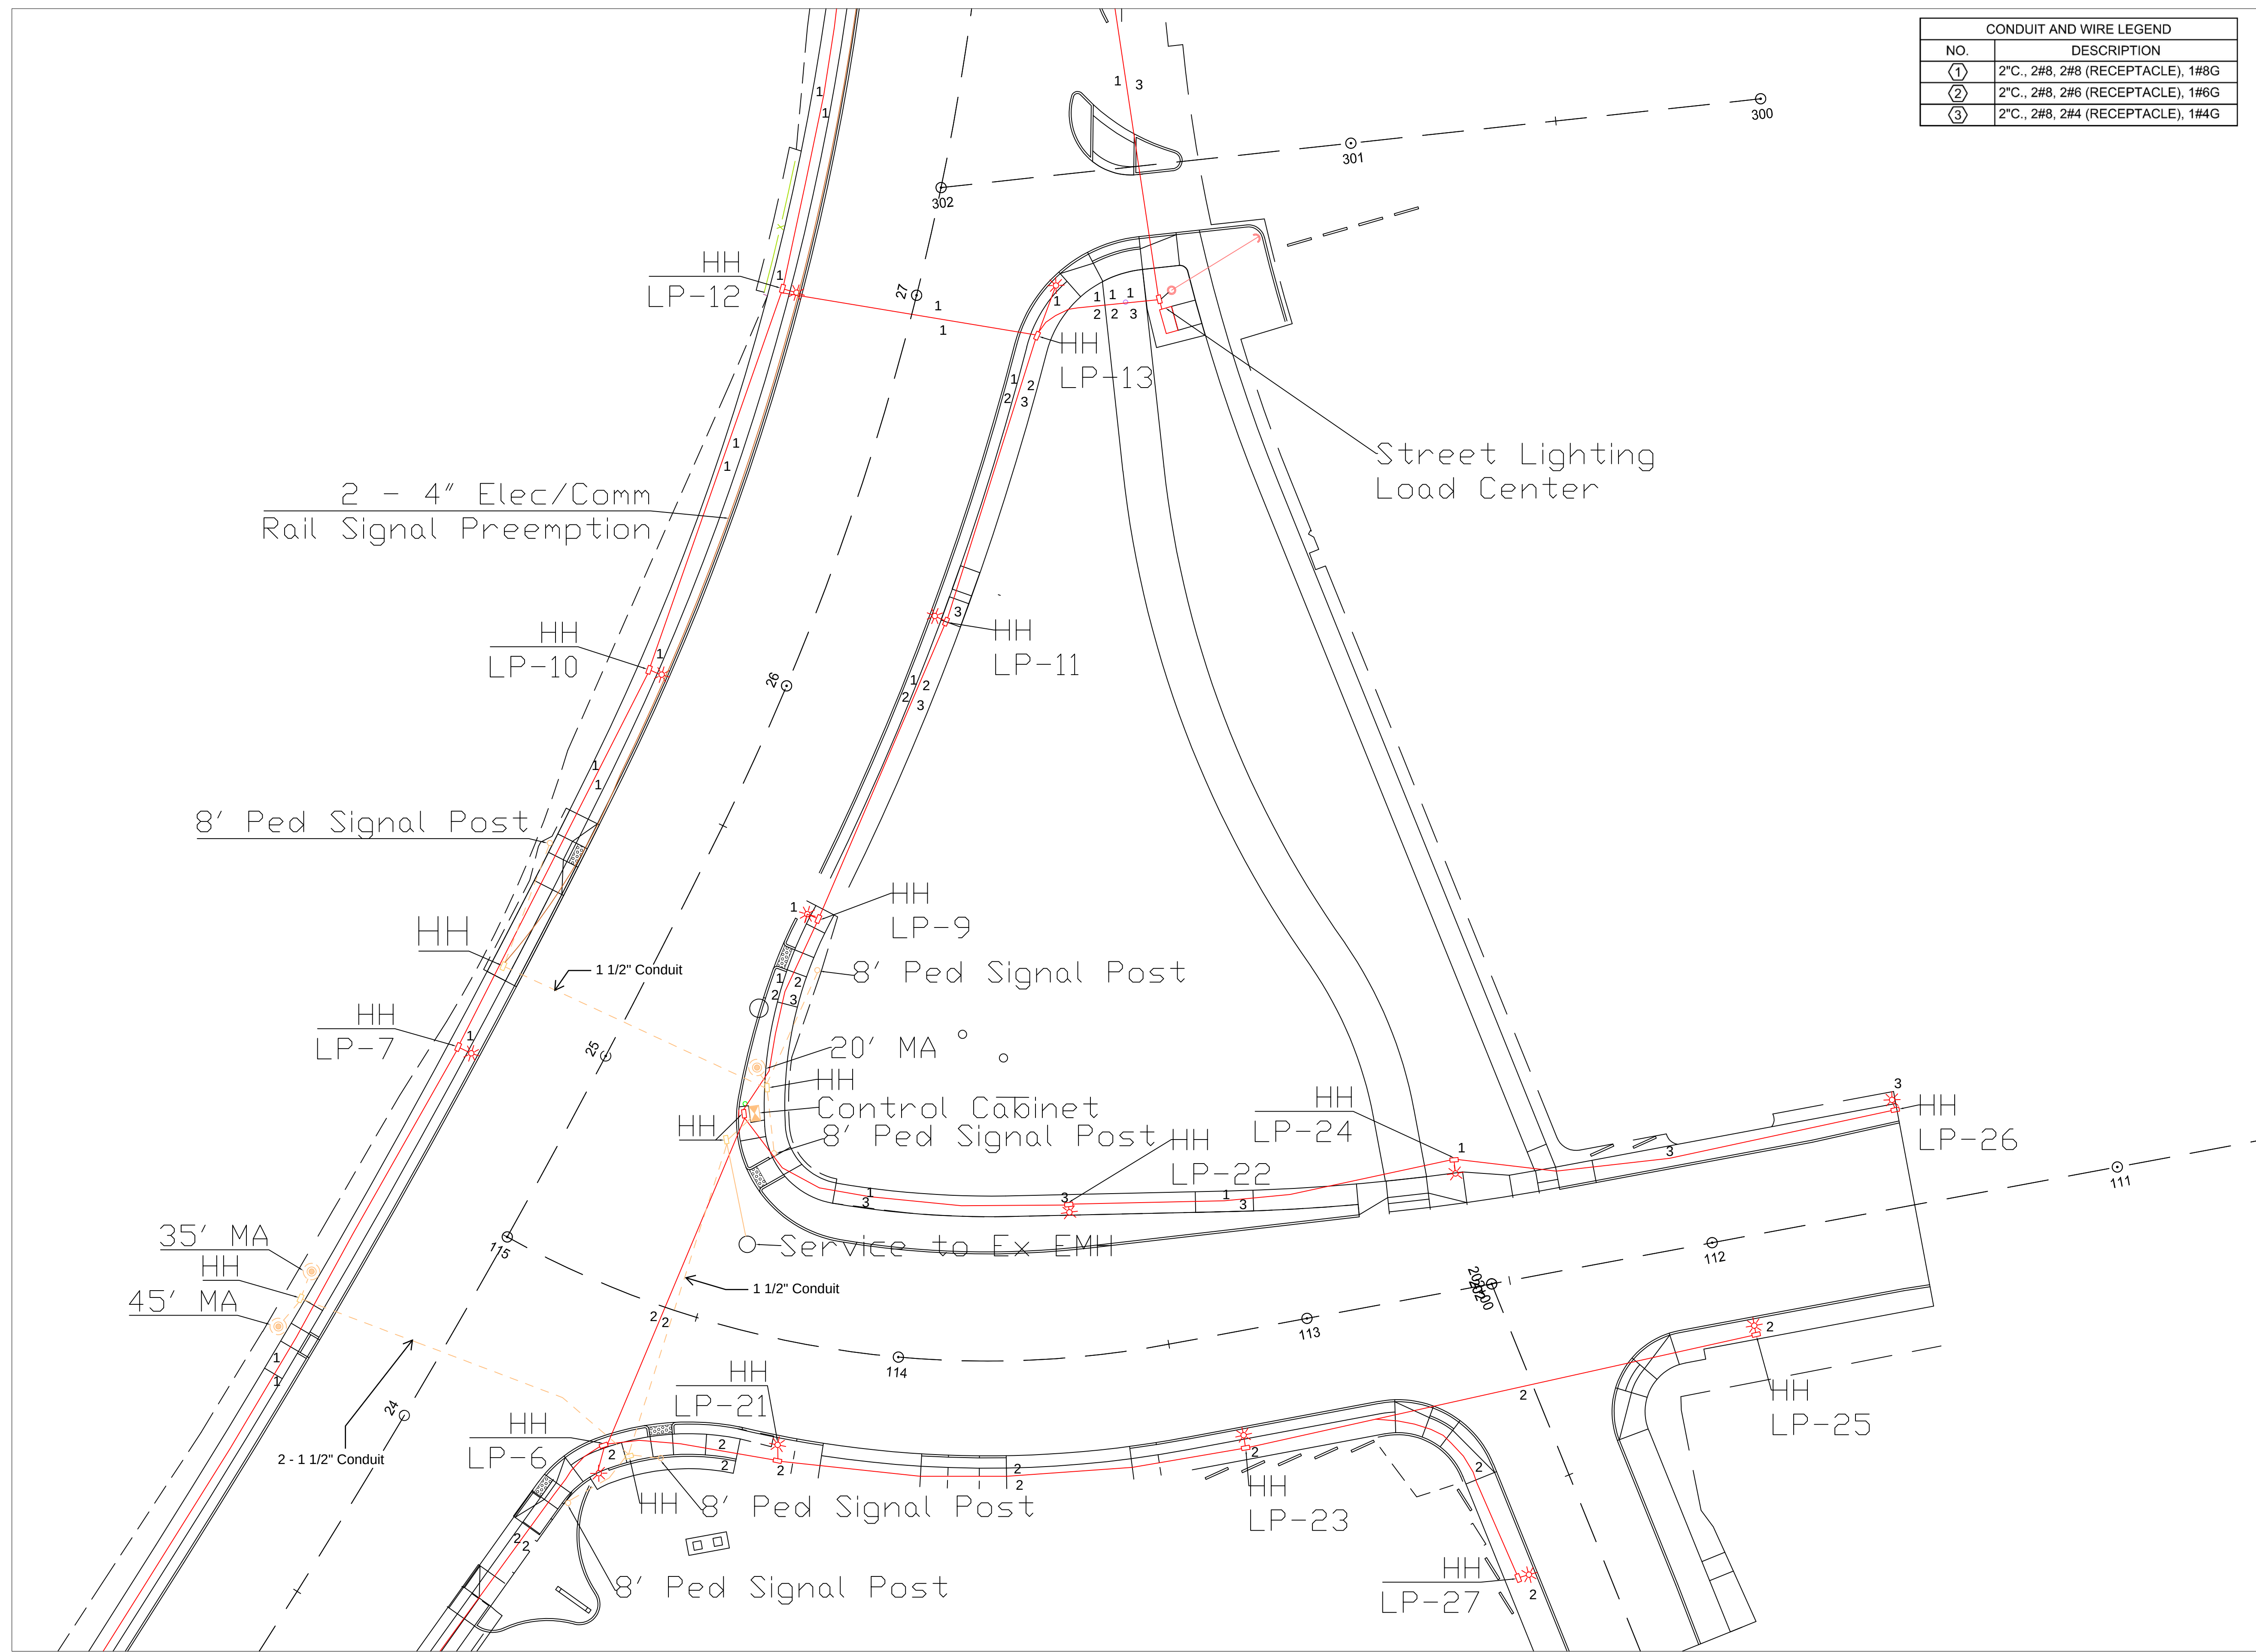

| CONDUIT AND WIRE LEGEND |                                   |
|-------------------------|-----------------------------------|
| NO.                     | DESCRIPTION                       |
| ①                       | 2"C., 2#8, 2#8 (RECEPTACLE), 1#8G |
| ②                       | 2"C., 2#8, 2#6 (RECEPTACLE), 1#6G |
| ③                       | 2"C., 2#8, 2#4 (RECEPTACLE), 1#4G |

General Notes

Hathaway  
Road  
Electric  
Asbuilt

|     |                |      |
|-----|----------------|------|
| 1   | Electric       |      |
| No. | Revision/Issue | Date |

K.R.Rezendes, Inc.  
3 Sammys Lane  
Assonet, MA 02702


Project Name and Address  
Hathaway Road  
New Bedford, MA  
Contract # 110953

Drawing Set  
Electric Asbuilt  
Date  
06/03/2023  
Scale  
1:20

Sheet

03



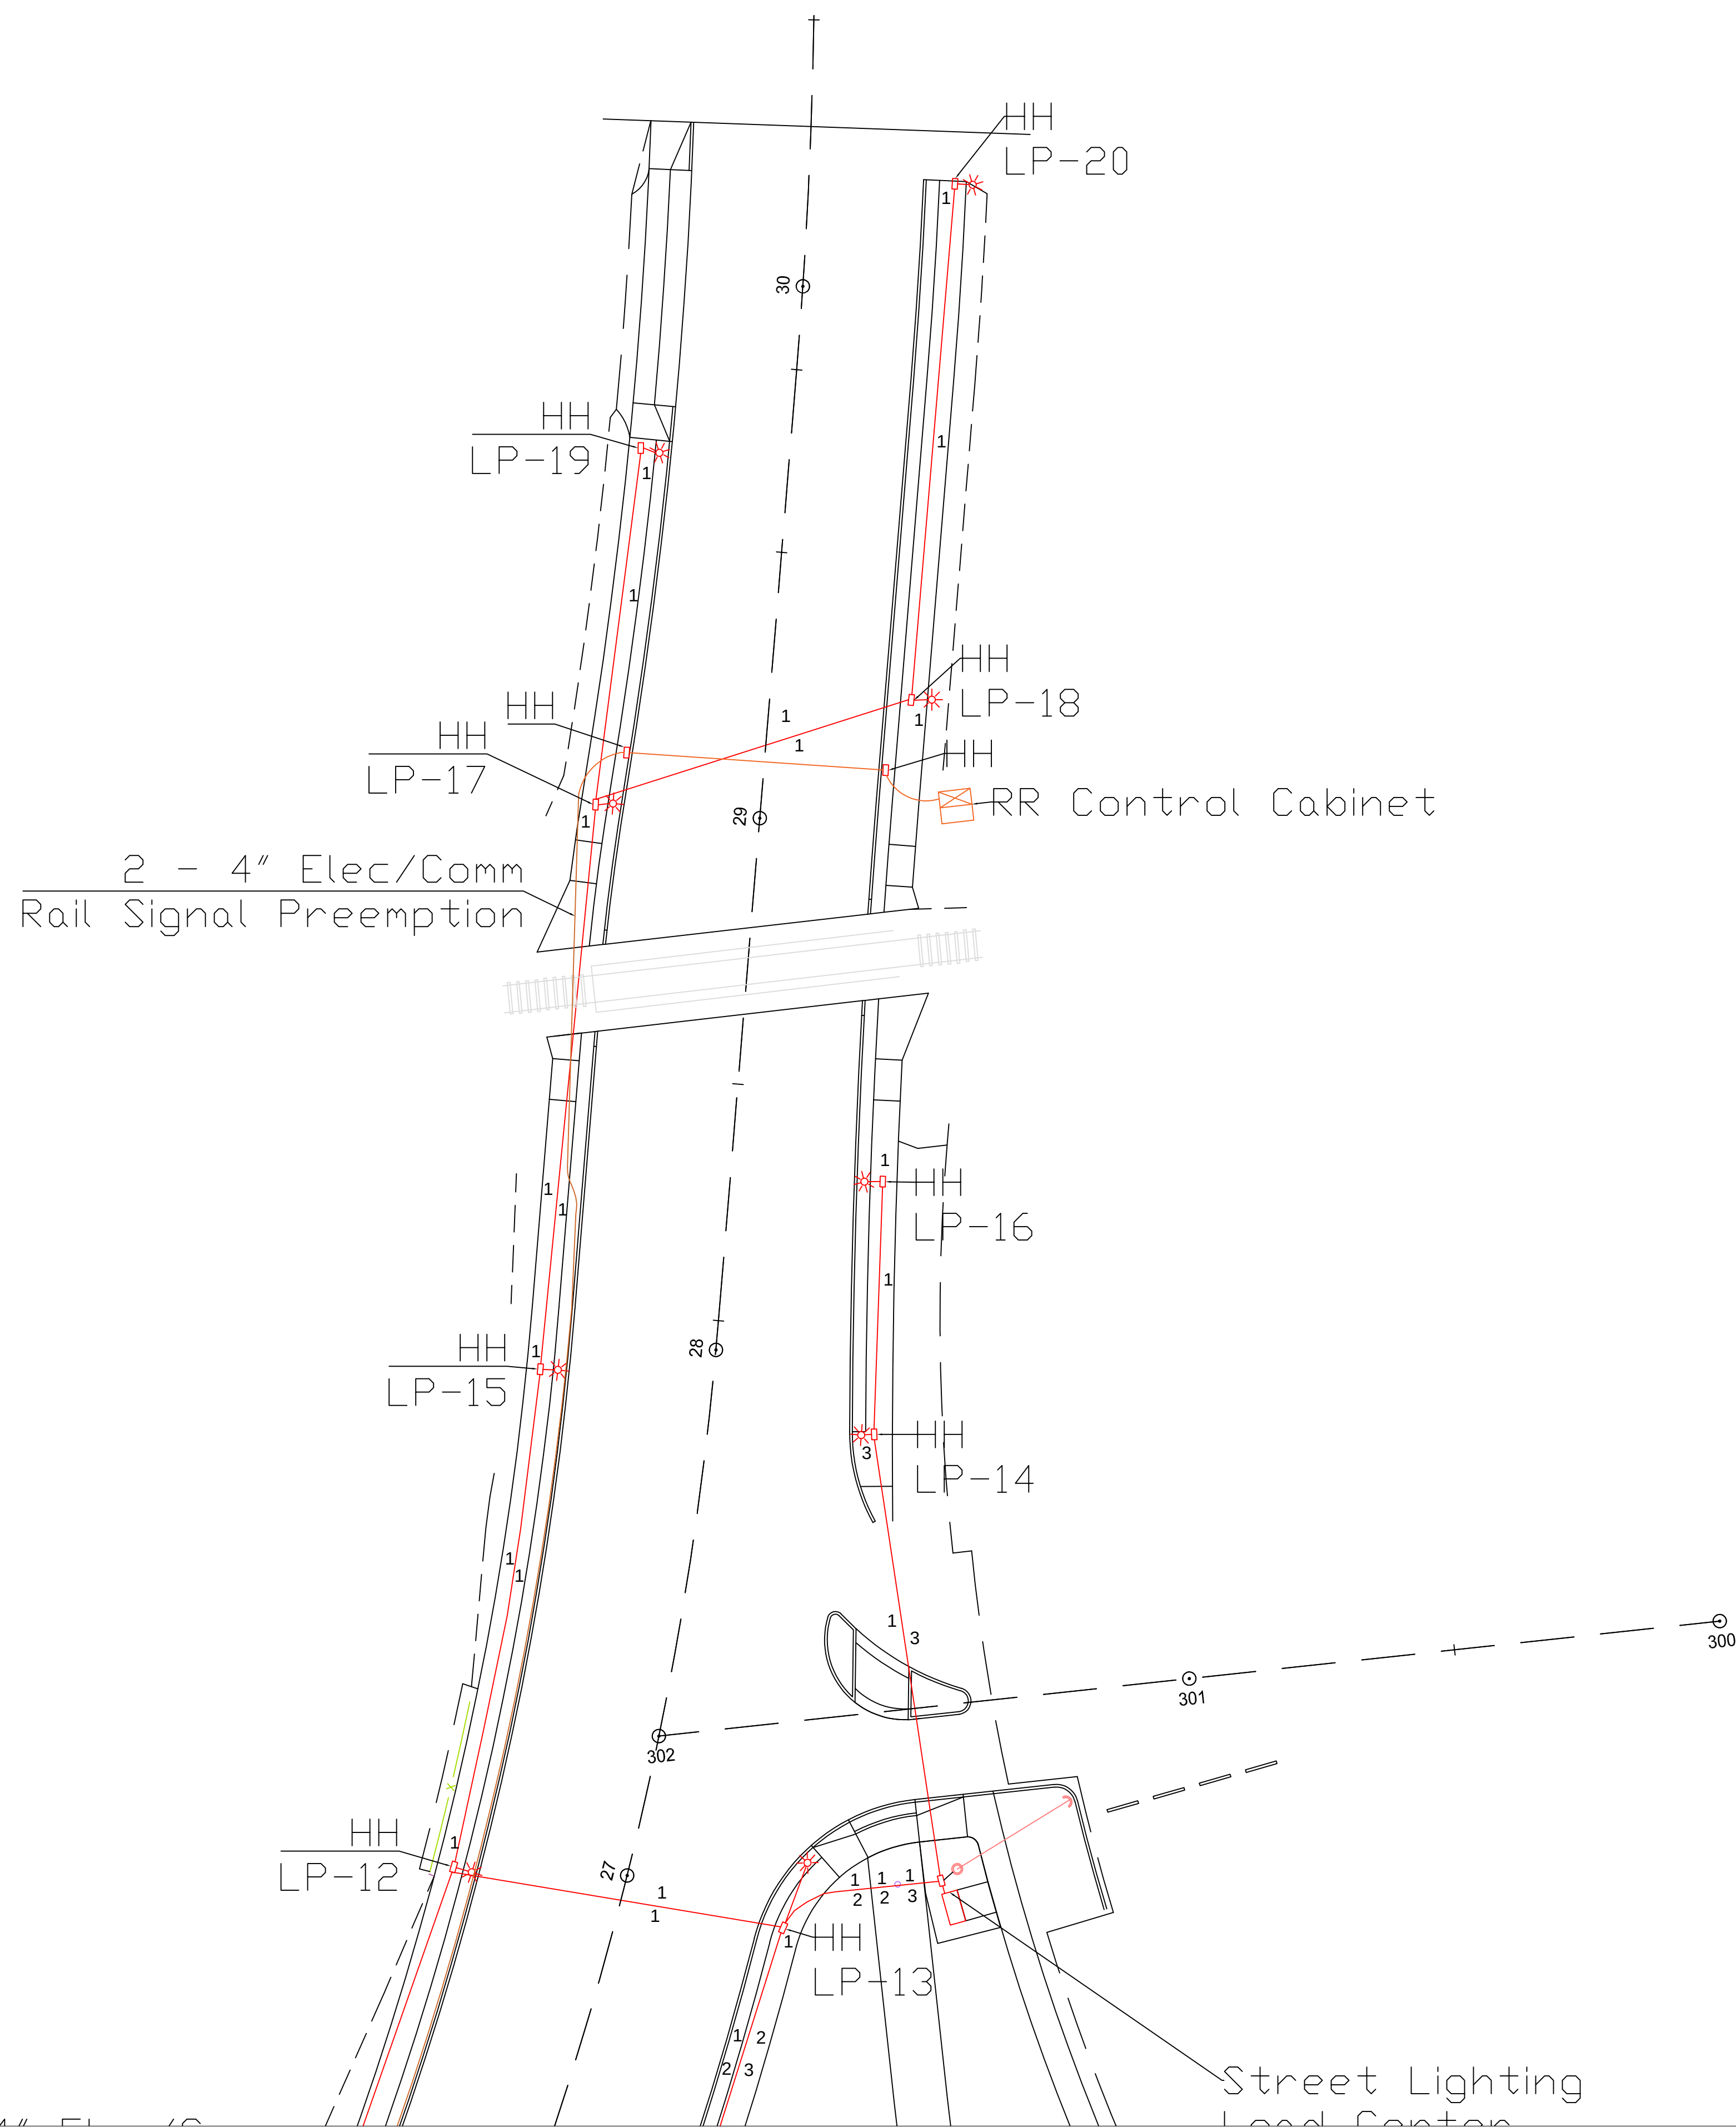

| CONDUIT AND WIRE LEGEND |                                   |
|-------------------------|-----------------------------------|
| NO.                     | DESCRIPTION                       |
| ①                       | 2"C., 2#8, 2#8 (RECEPTACLE), 1#8G |
| ②                       | 2"C., 2#8, 2#6 (RECEPTACLE), 1#6G |
| ③                       | 2"C., 2#8, 2#4 (RECEPTACLE), 1#4G |

General Notes

Hathaway  
Road  
Electric  
Asbuilt

|     |                |      |
|-----|----------------|------|
| 1   | Electric       |      |
| No. | Revision/Issue | Date |

K.R.Rezendes, Inc.  
3 Sammys Lane  
Assonet, MA 02702

Project Name and Address  
Hathaway Road  
New Bedford, MA  
Contract # 110953

Drawing Set  
Electric Asbuilt

Date  
06/03/2023

Scale  
1:20

Sheet

04