

BROCK

AVE

RODNEY FRENCH  
COVE RD


BLVD

357

HARMONY

ST

MCGURK ST

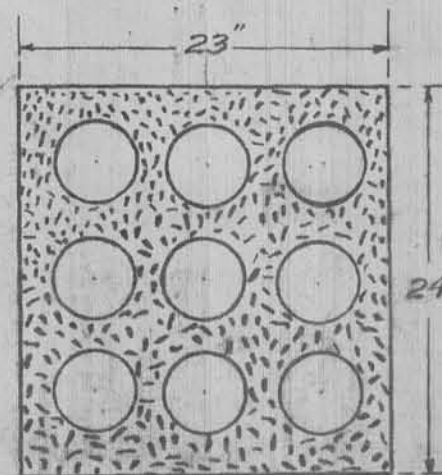

SECTION  
THRU CONDUIT

9-4" FIBRE DUCTS  
AVERAGE COVER - 24 inches

RECORD  
PLAN NO. E2323  
SCALE: 1 IN. = 20 FEET.

Note: All ducts are 4"  
Except as noted