

BROCK

AVE

429

427


BUTLER ST
SHEET

CLARA ST

NORMAN ST

SHEET

428

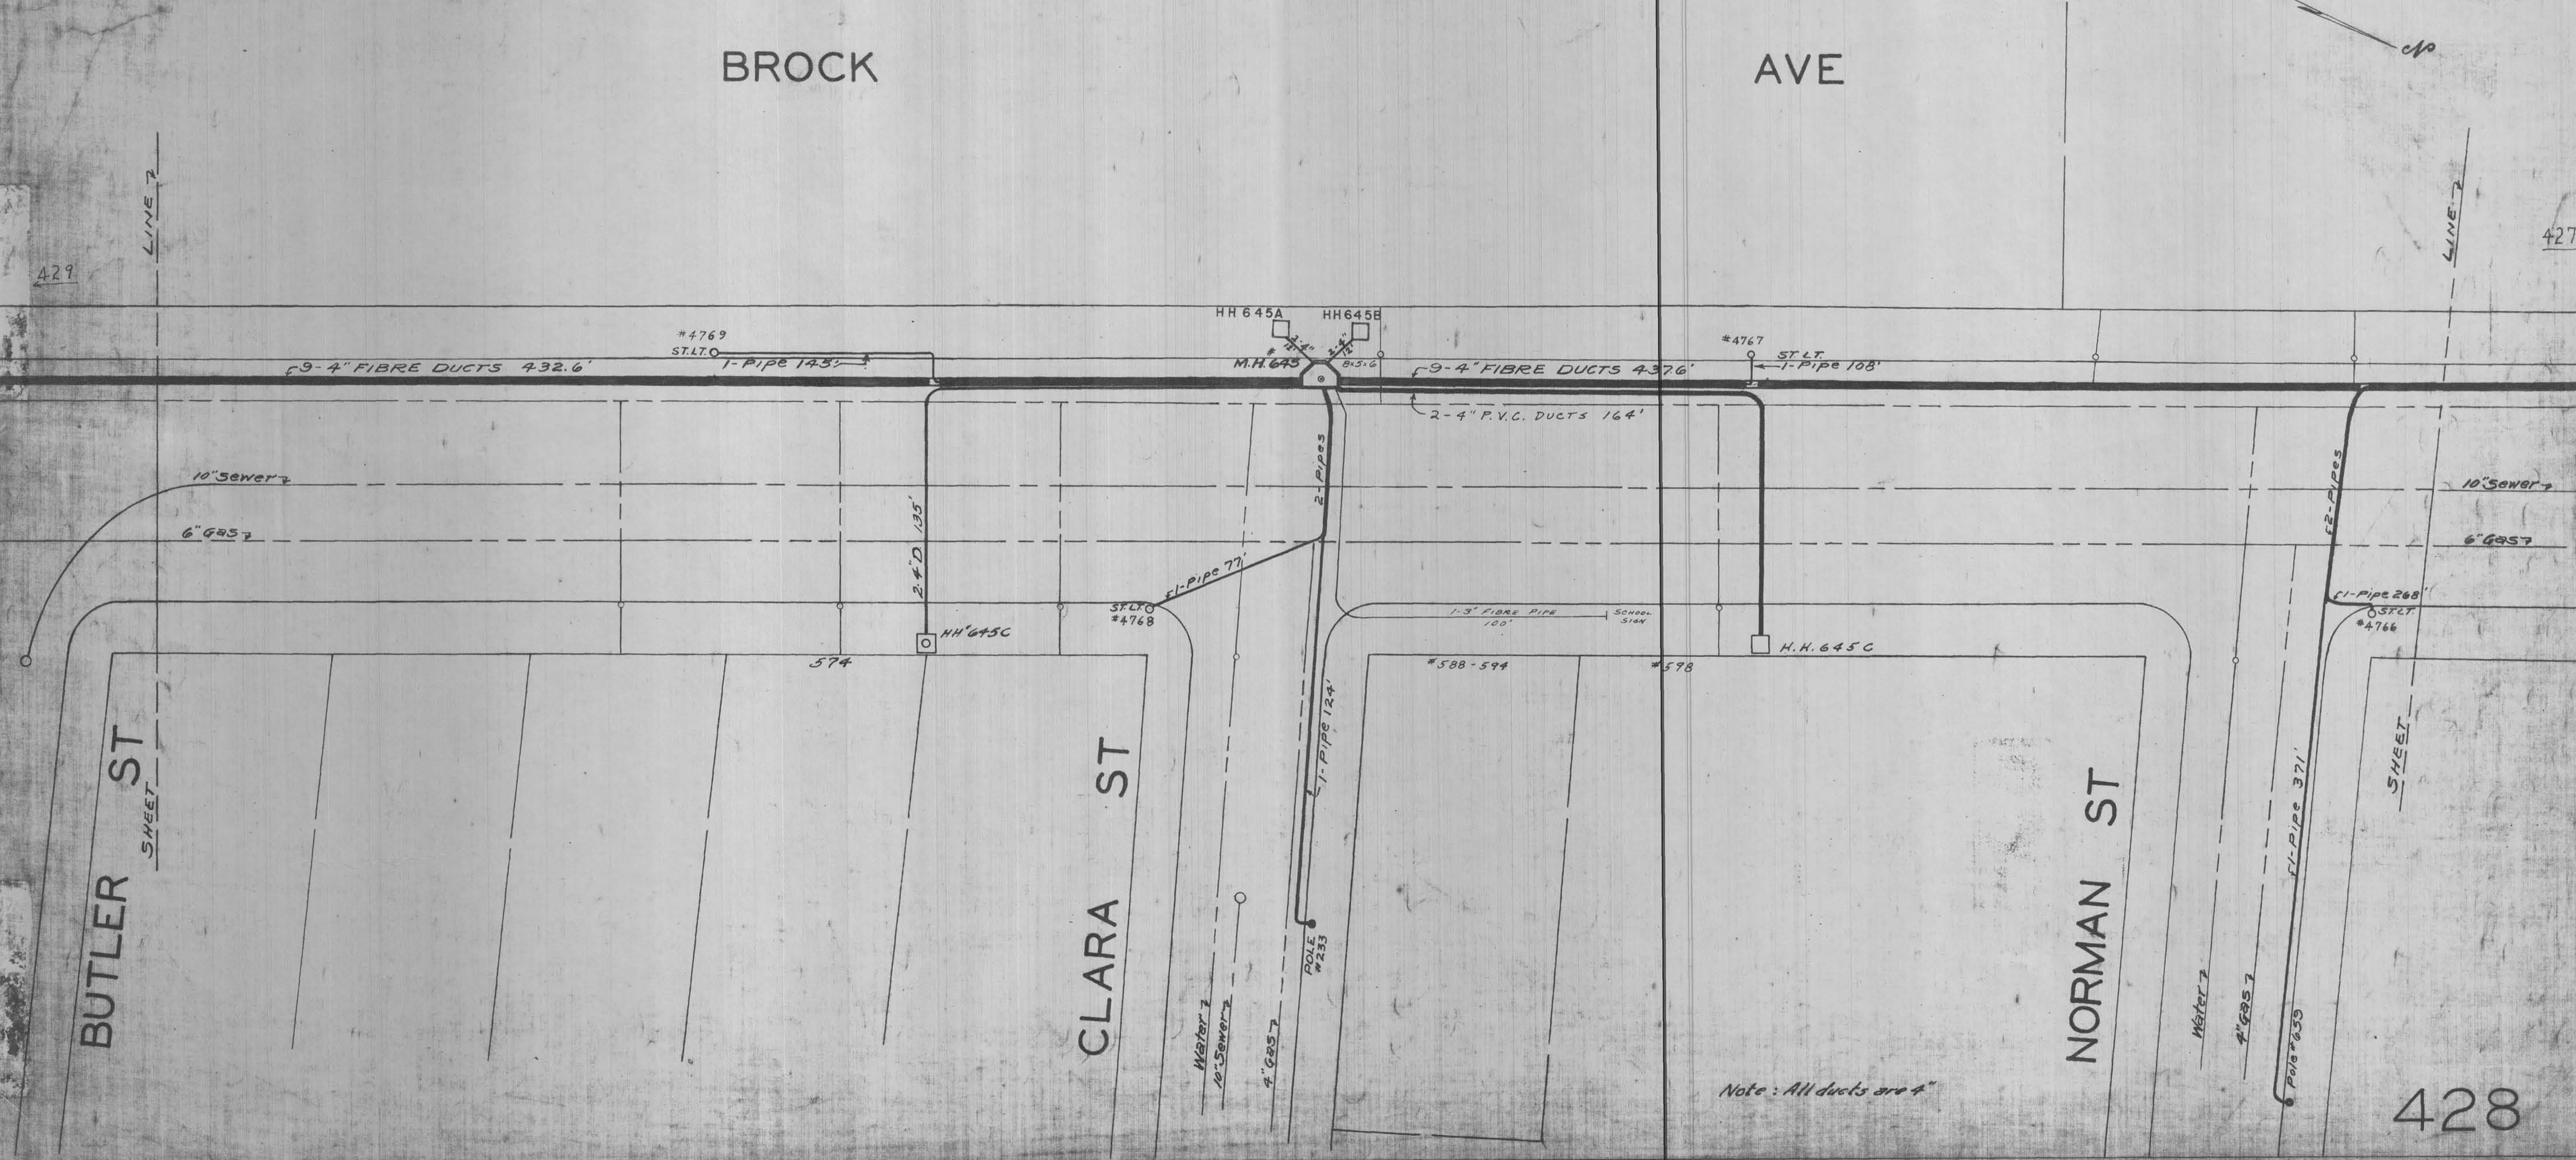

Note: All ducts are 4"