


BROCK

AVE

ST

PLAN No. E2323

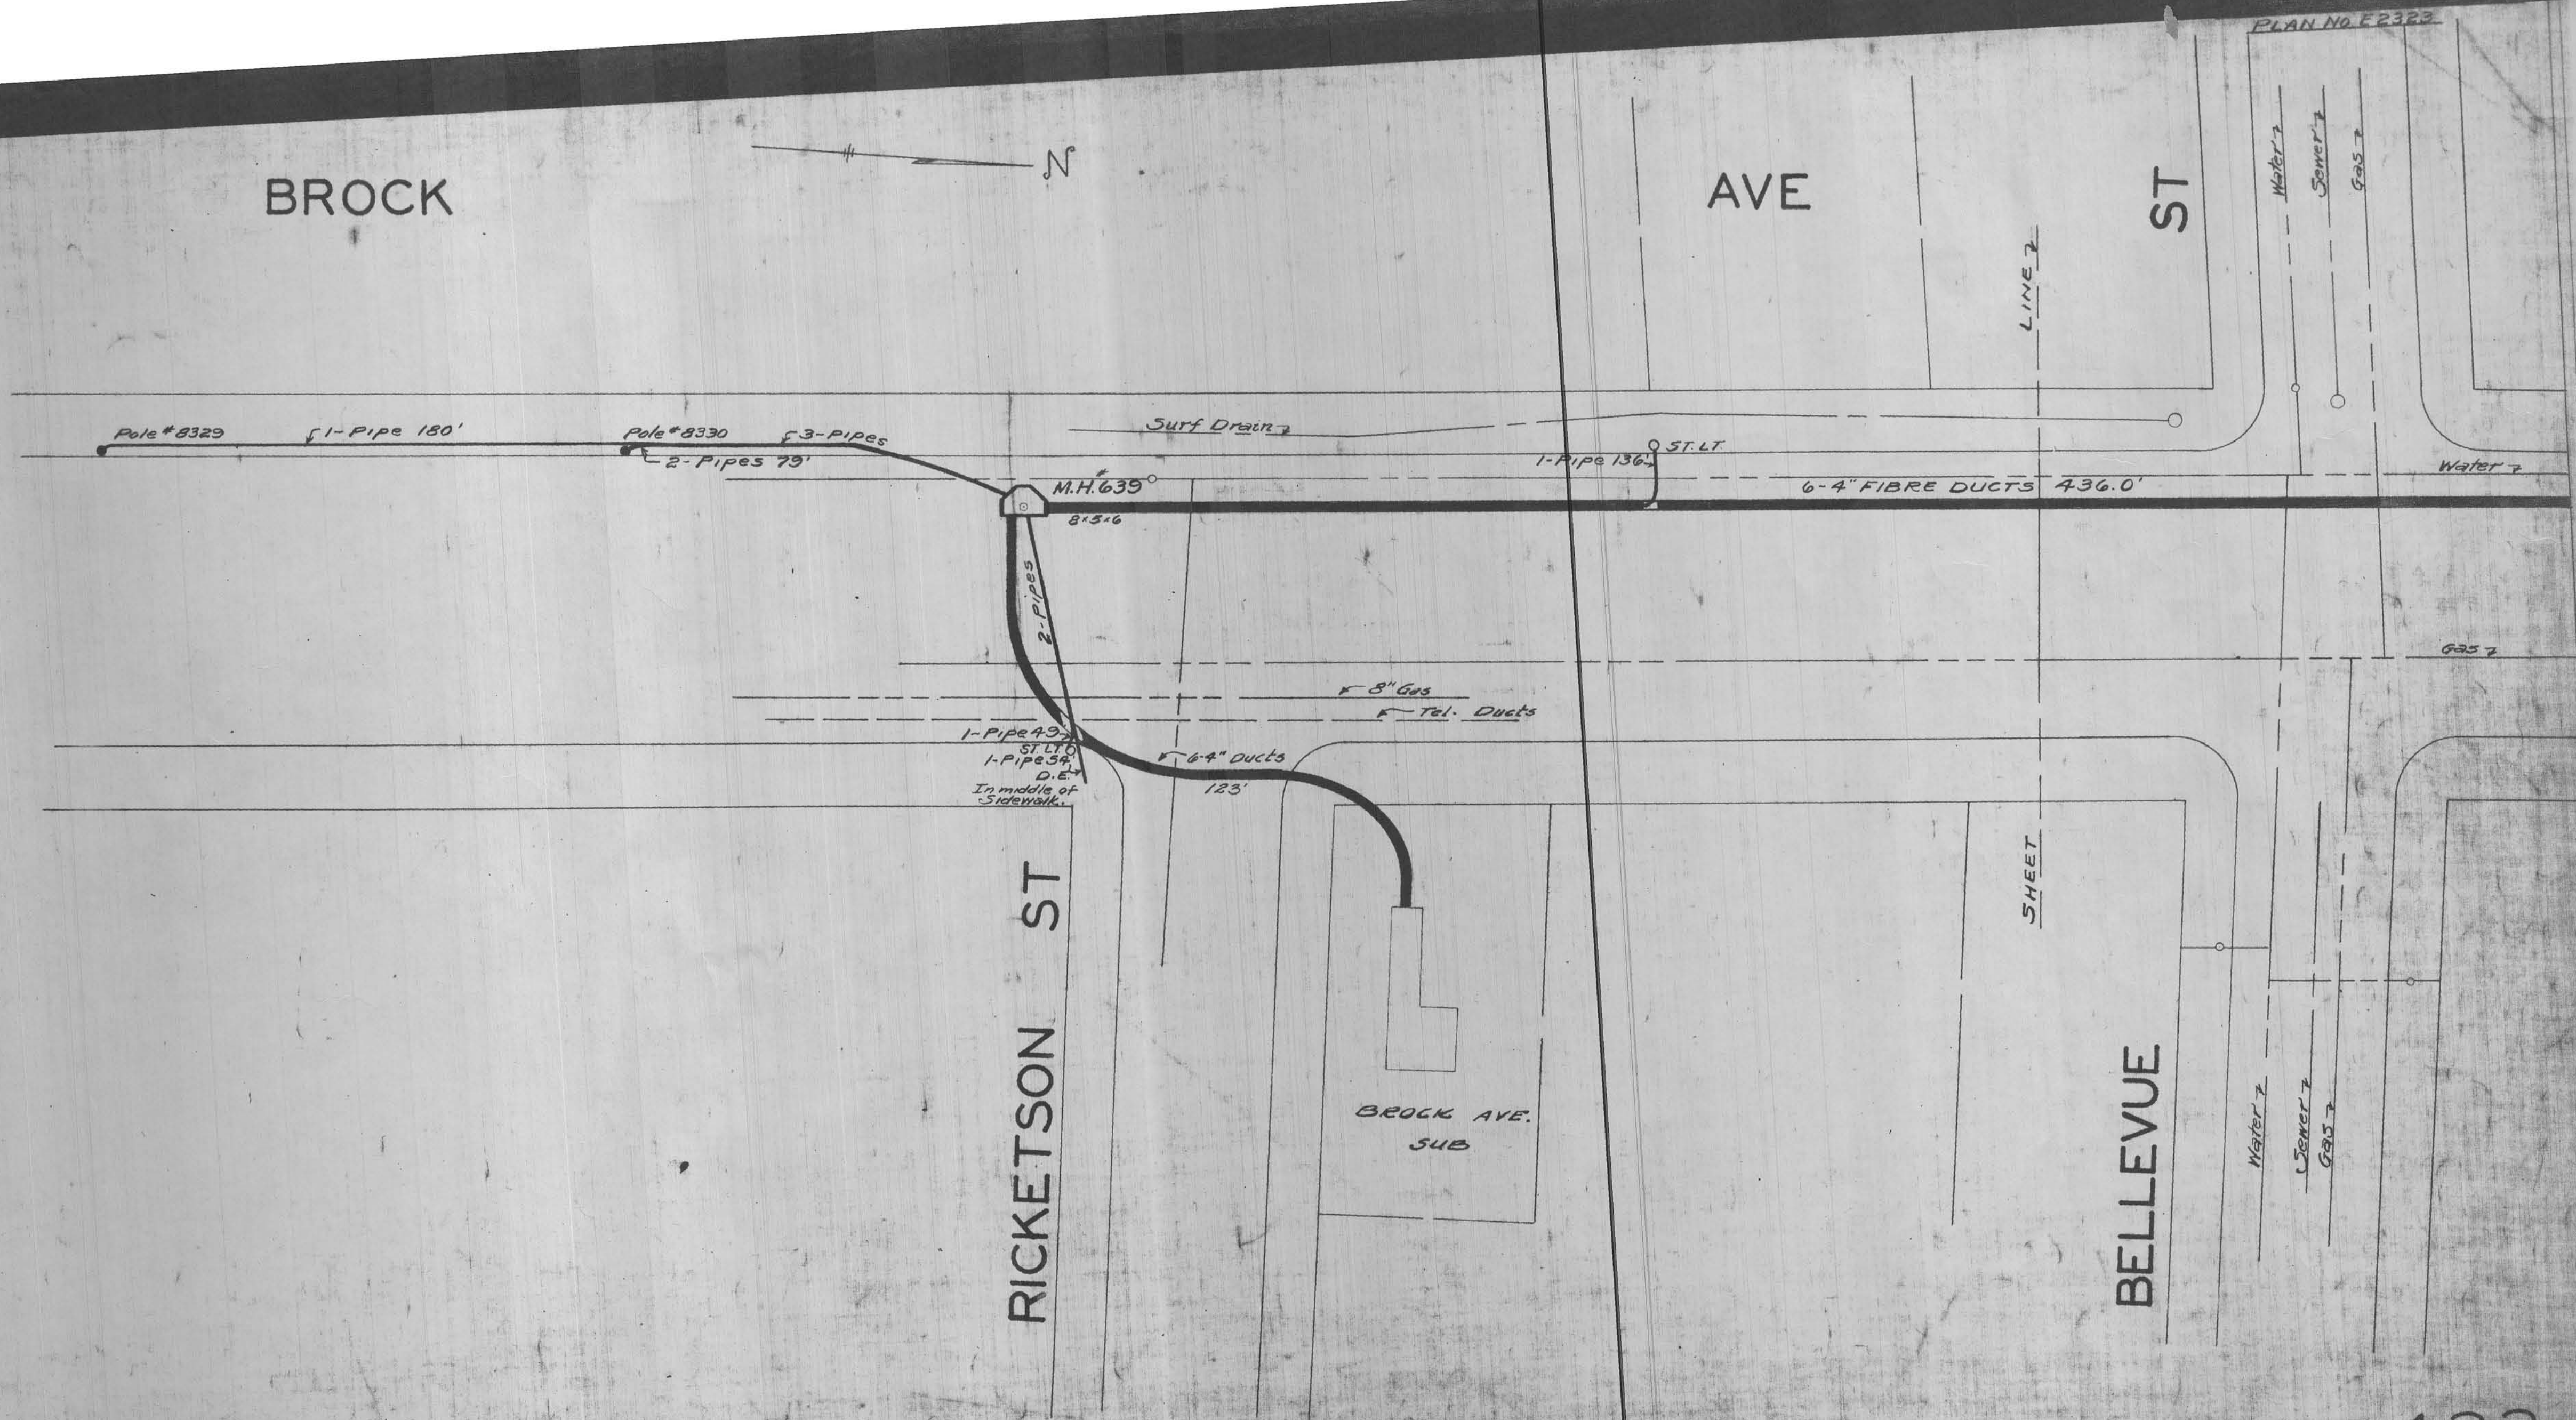

Note: All ducts are 4"