


CITY OF NEW BEDFORD
ROUTE 18 RECONSTRUCTION

STATE	FED. AID PROJ. NO.	SHEET NO.	TOTAL SHEETS
MASS.	HP-0028(145)	72	161
PROJECT FILE NO.		602857	

RAMP AND BRIDGE
CONDUIT ROUTING

RECORD SET

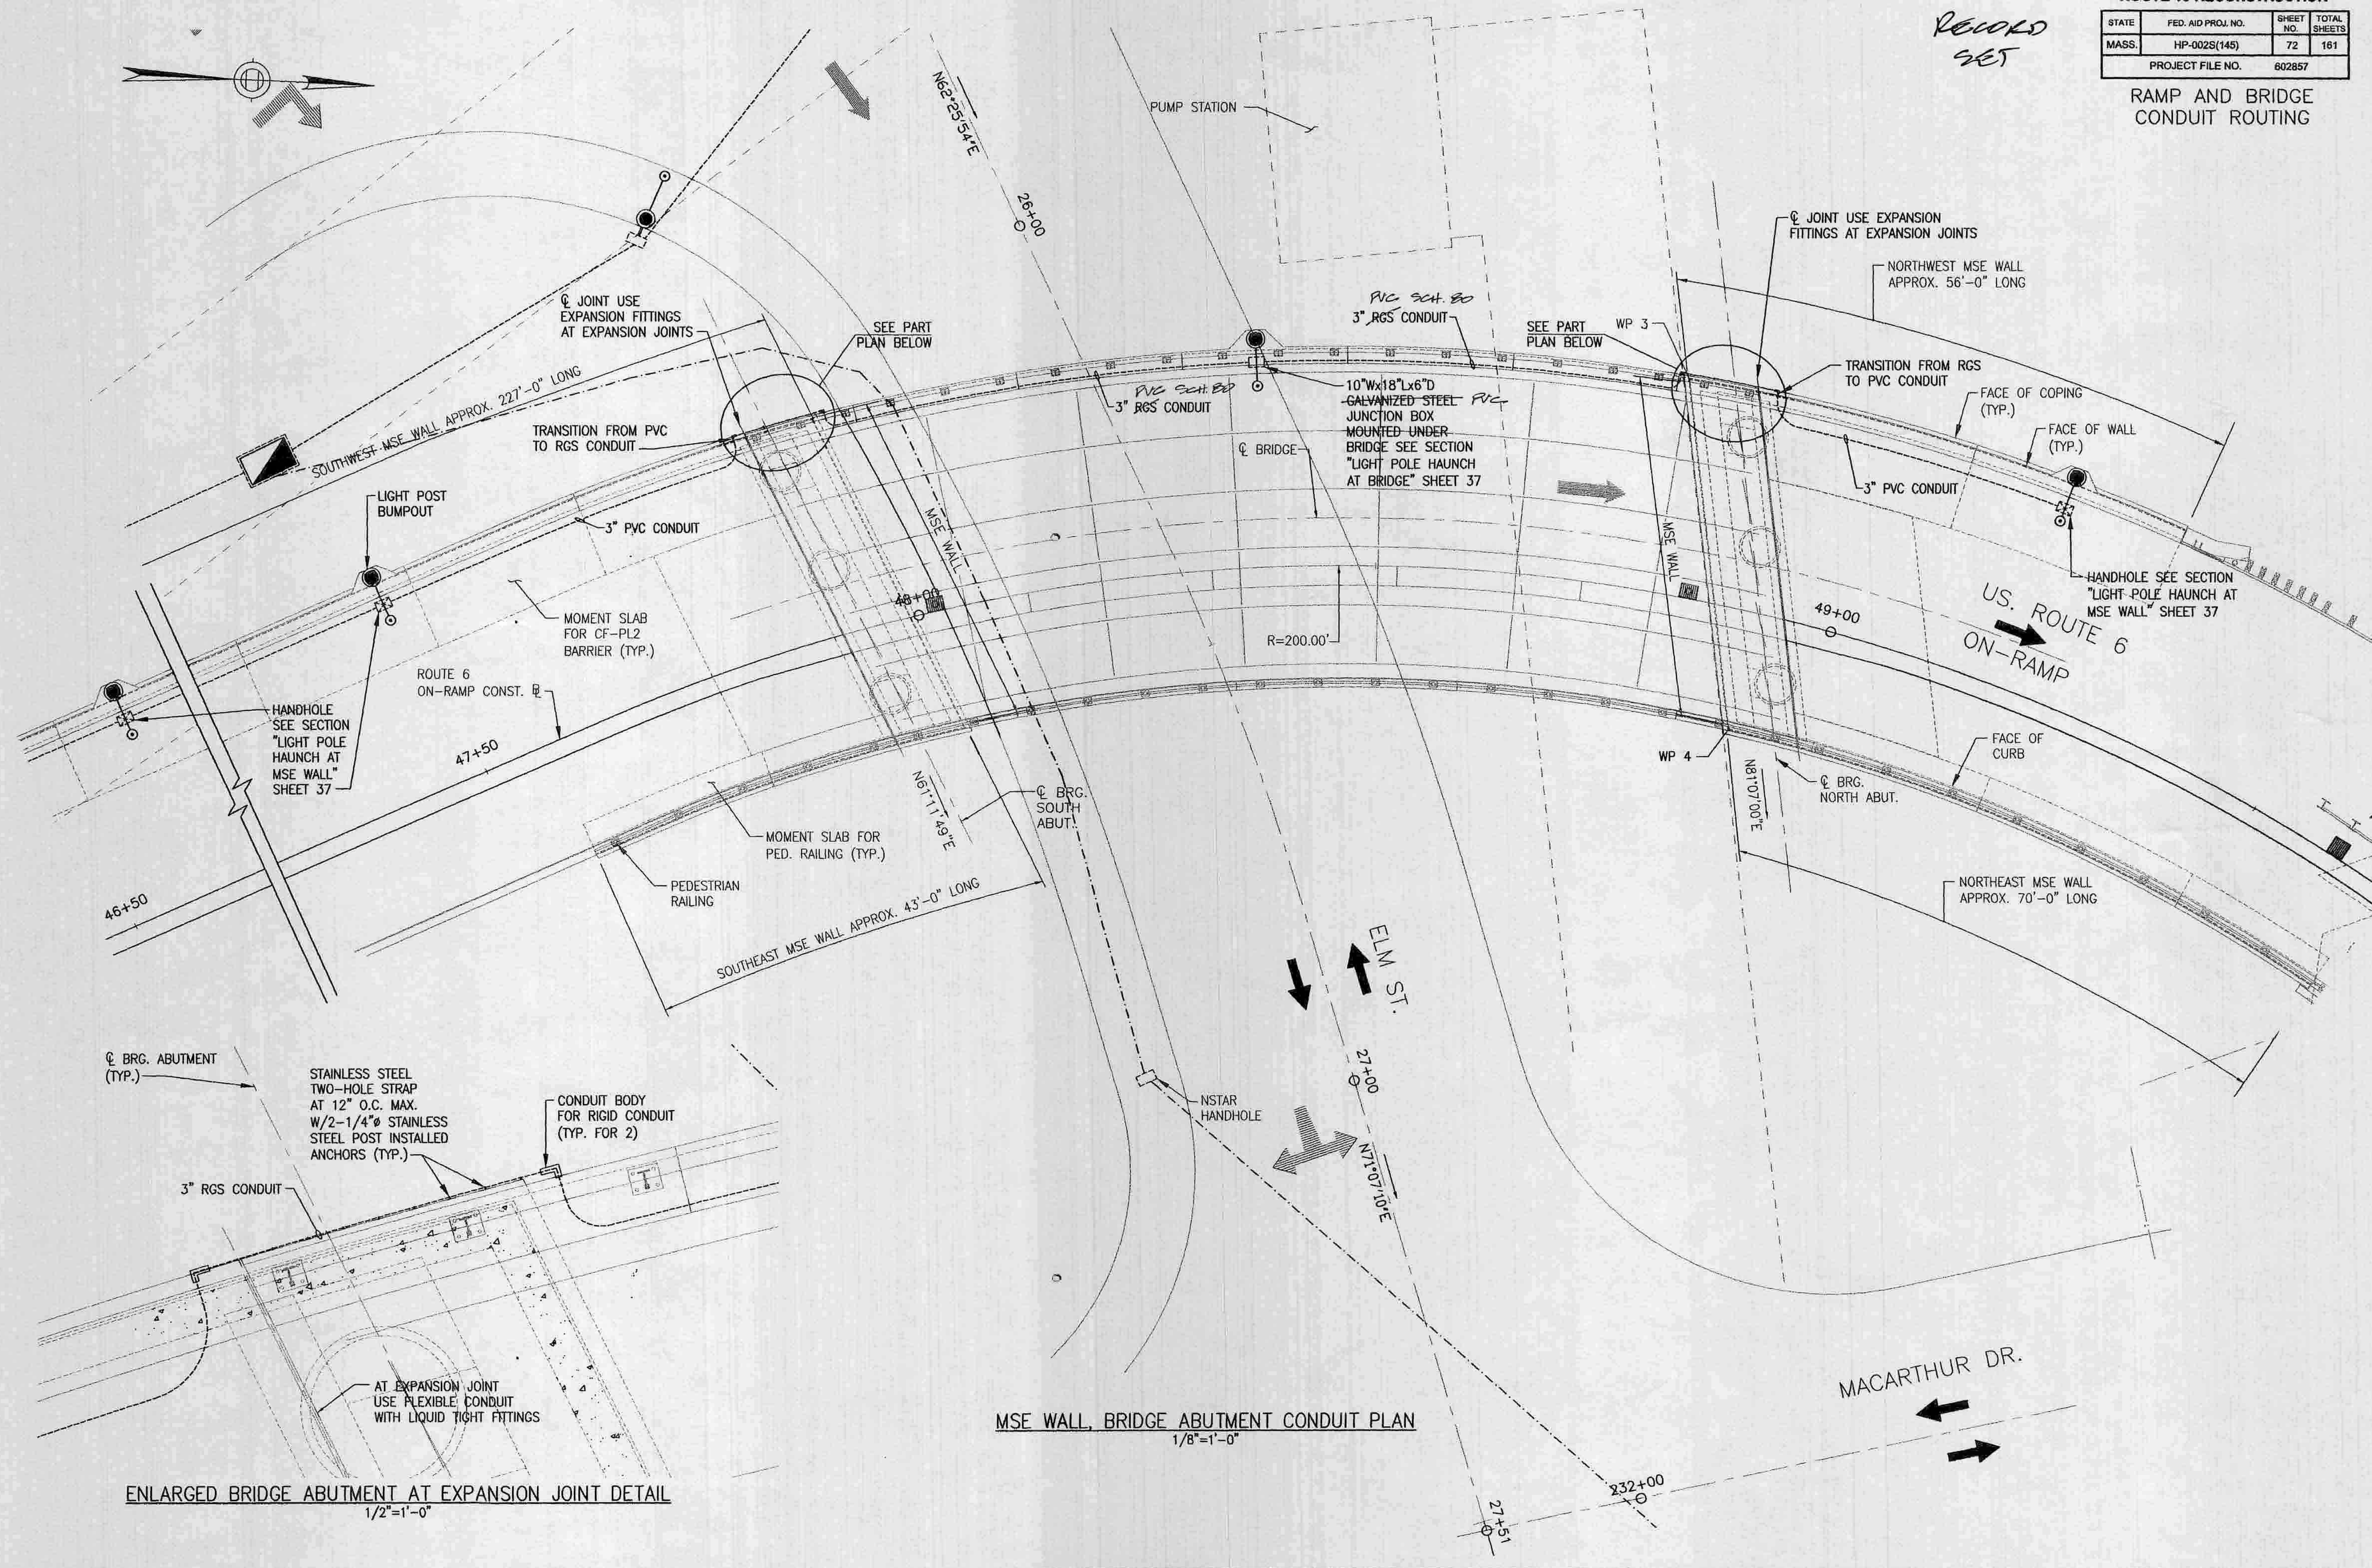

MSE WALL, BRIDGE ABUTMENT CONDUIT PLAN
1/8" = 1'-0"