


NEW BEDFORD
COGGESHALL ST./RIVERSIDE DR./I-195 RAMPS

STATE	FED. AID. PROJ. NO.	FISCAL YEAR	SHEET NO.	TOTAL SHEETS
MASS.			1	2

PERMIT NO. 5-2009-0175

TRAFFIC SIGNAL PLAN

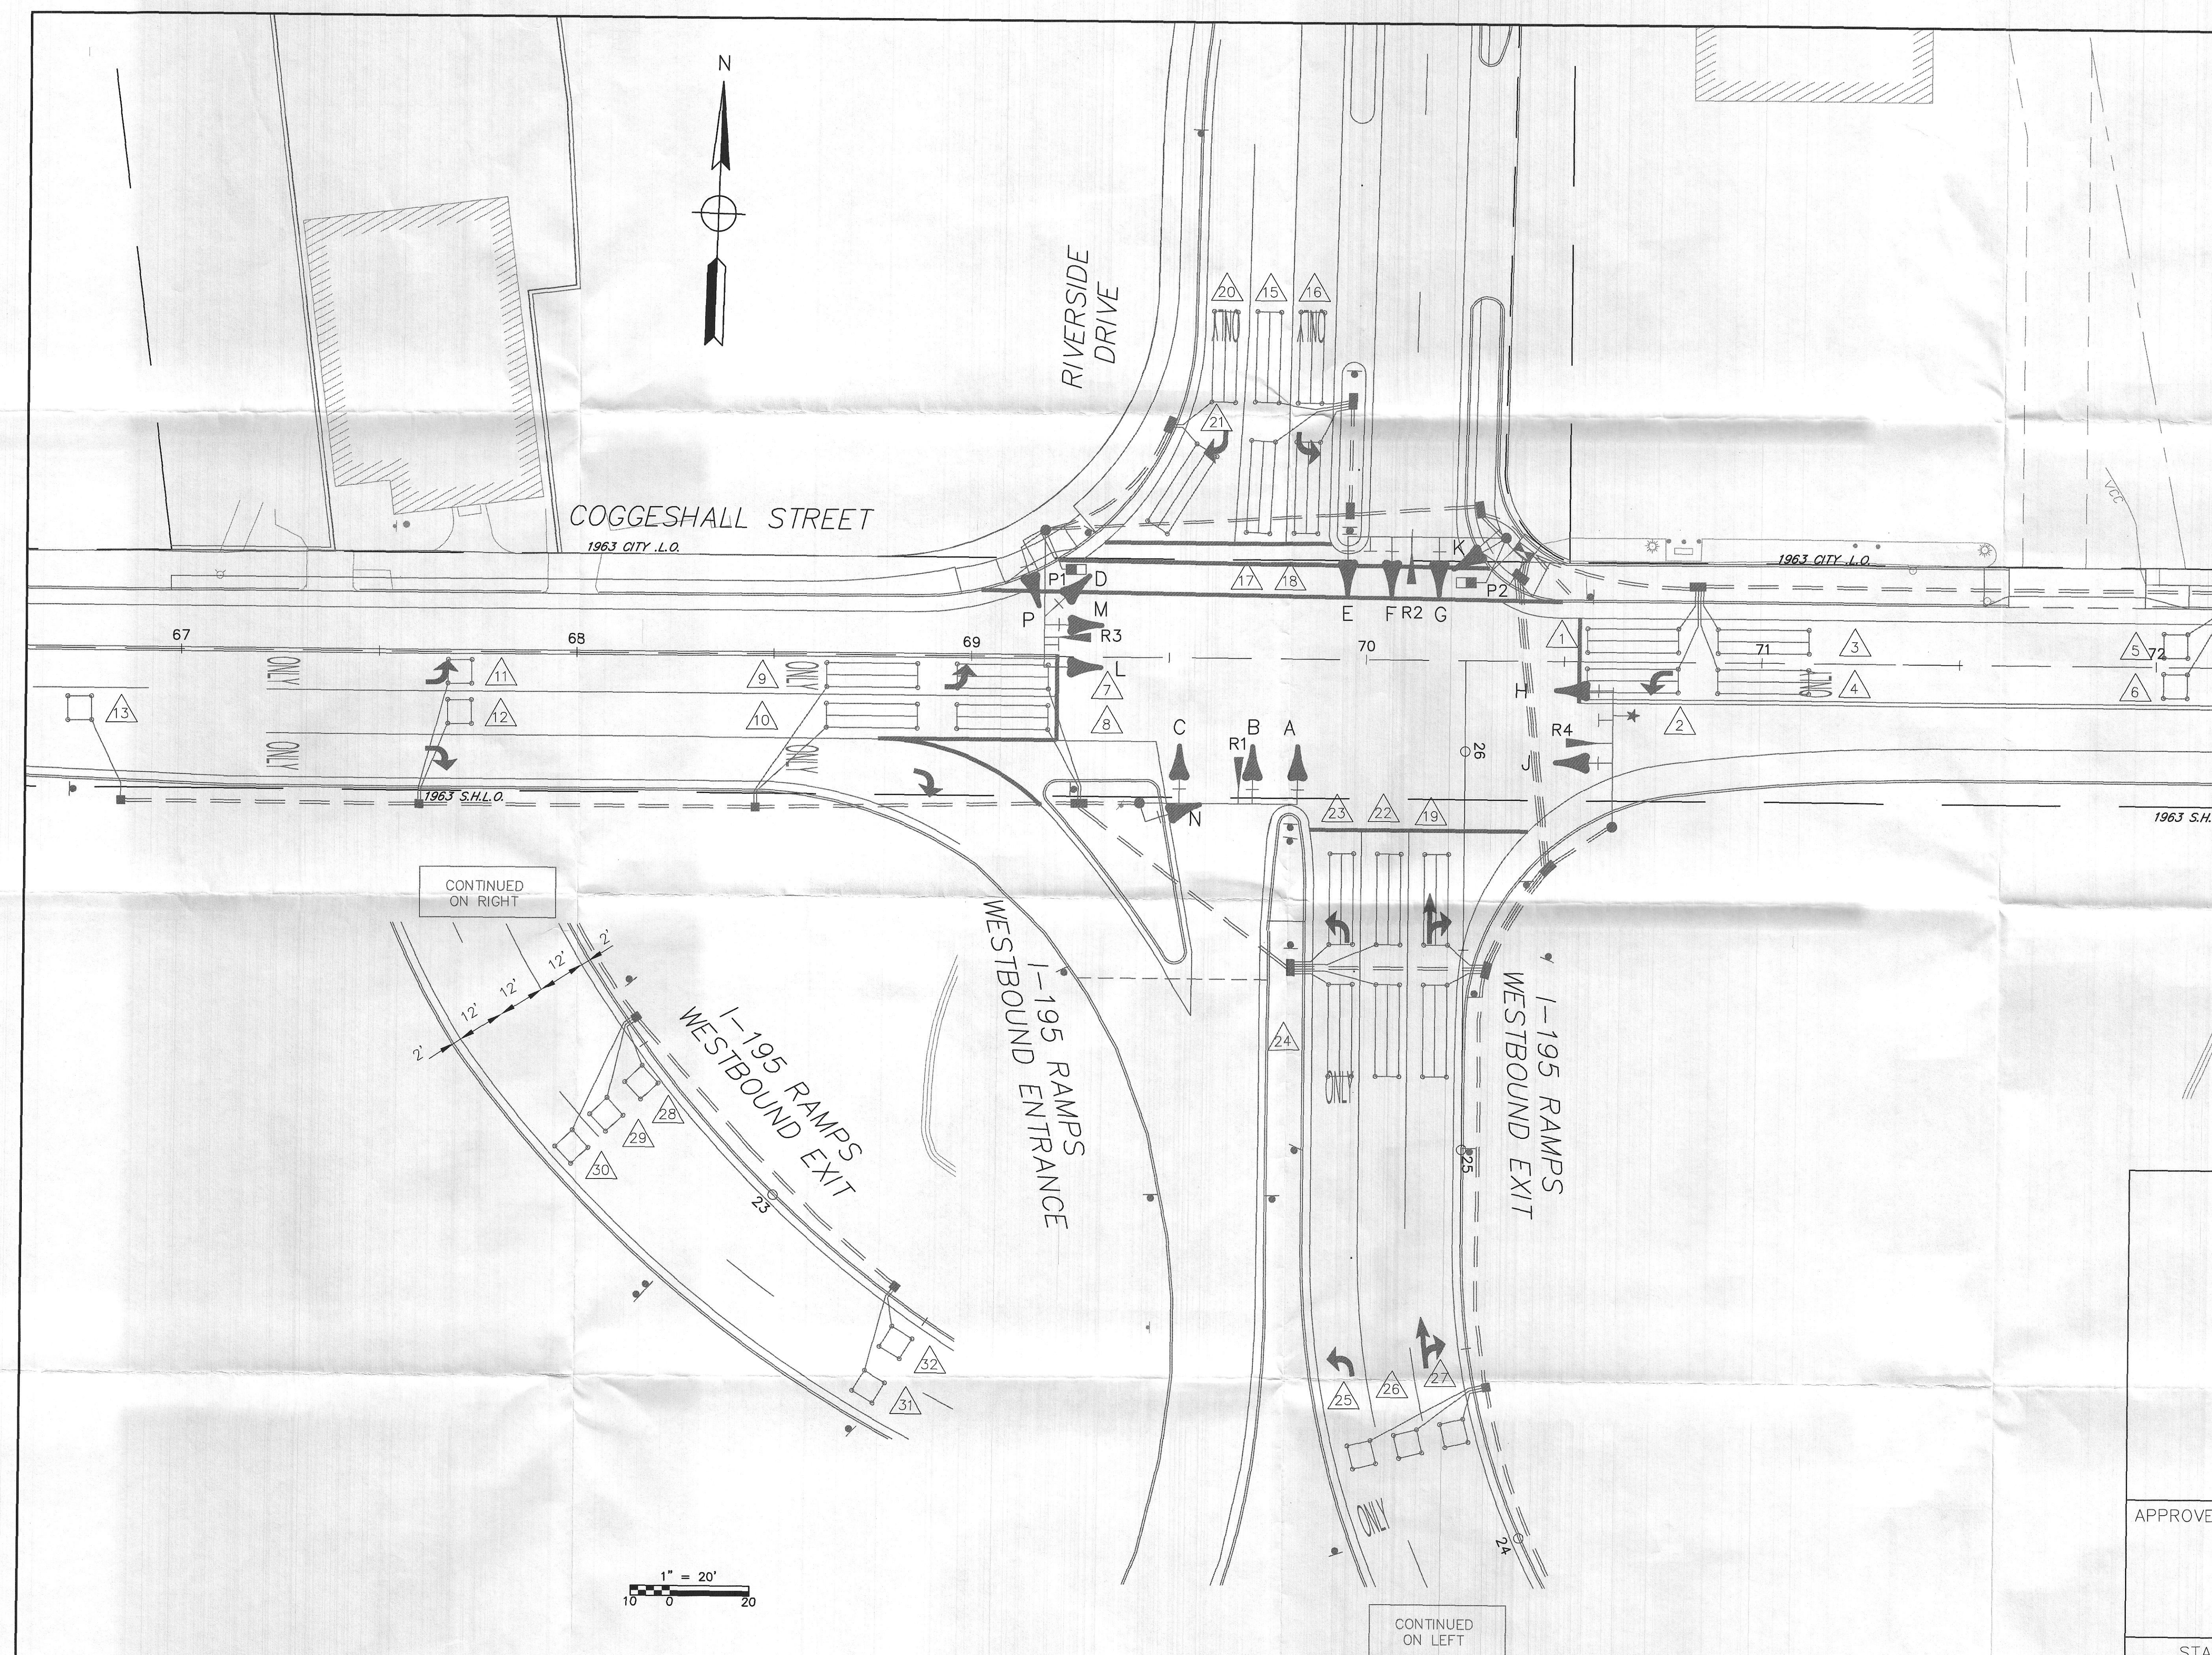

LEGEND

- SIGNAL CONTROLLER
- VEHICULAR SIGNAL
- FIRE PRE-EMPTION RECEIVER
- FIRE PRE-EMPTION STROBE LIGHT
- PEDESTRIAN SIGNAL
- PEDESTRIAN PUSH BUTTON
- PULL BOX

APPROVED BY:

STATE TRAFFIC ENGINEER

DATE