

REFERENCE:
FROM Location 1
TO Intersection of Mill St. and Rockdale Ave.

SKETCH SHEET


AS BUILT TRAFFIC SIGNALS

CONTRACT NO. 69938 PAGE
ITEM NO. ITEM
PAGE OF PAGES

- ✓1) MAST ARM @ STA 105+88, 83' LT
- ✓2) MAST ARM @ STA 106+60, 19' LT
- ✓3) MAST ARM @ STA 105+92, 15' RT
- ✓4) PULL BOX @ STA 106+60, 16' LT
- ✓5) HAND HOLE @ STA 106+60, 21' RT
- ✓6) CONTROL CAB. @ STA 301+24 LT
- ✓7) HAND HOLE @ STA 106+91, 17' RT
- ✓8) PULL BOX @ STA 106+94, 16' RT
- ✓9) PULL BOX @ STA 301+64, 22' LT
- ✓10) PULL BOX @ STA 300+35, 33.5' RT
- ✓11) PULL BOX @ STA 300+56, 38' RT
- ✓12) PULL BOX @ STA 105+92, 95' LT
- ✓13) PULL BOX @ STA 105+89, 20' RT

809.3 - Seven Electrical Conduits TYPE NM-B Plastic (44)

MA 2 to PB 4	2.0'	PB 13 to MA 3	2.0'
PB 4 to HH 5	36.0'	PB 13 to PB 12	48.0'
HH 5 to PB 8	33.0'	PB 12 to MA 1	2.0'
MA 5 to CC 6	10.0'	PB 12 to PB 11	20.0'
MA 5 to PB 13	78.0'	PB 11 to PB 10	20.0'
CC 6 to PB 9	40.0'		
CC 6 to HH 7	38.5'		
		Total	327.5 ft

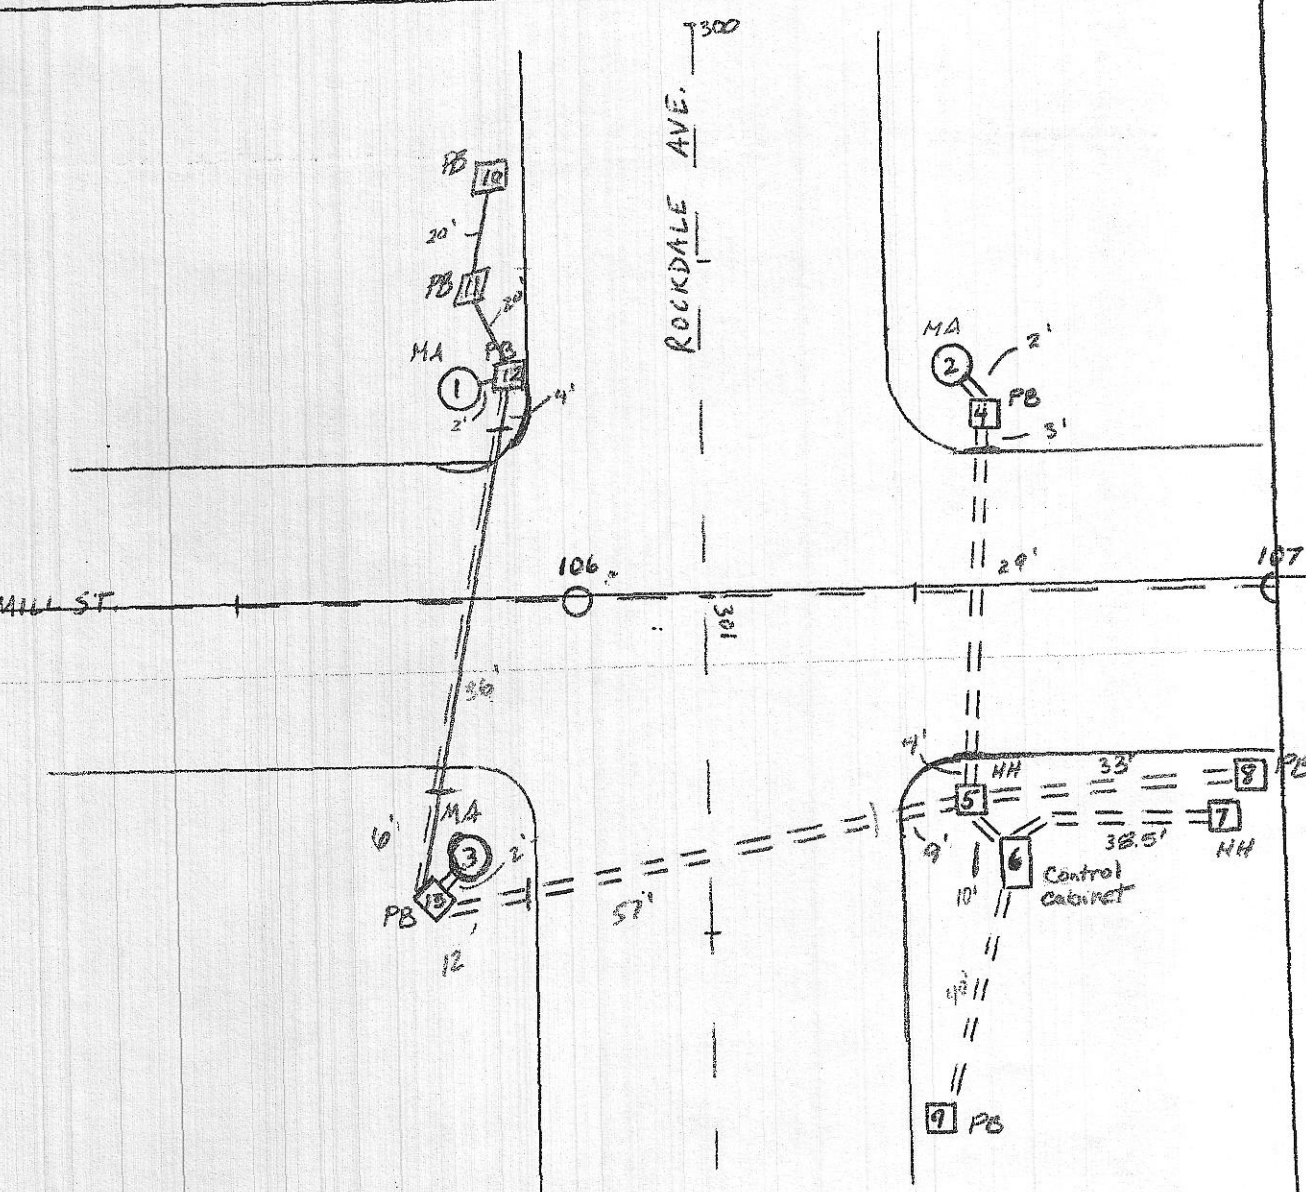

TOWN New Bedford Date 2/21/14 Signature

TOWN Date Signature