


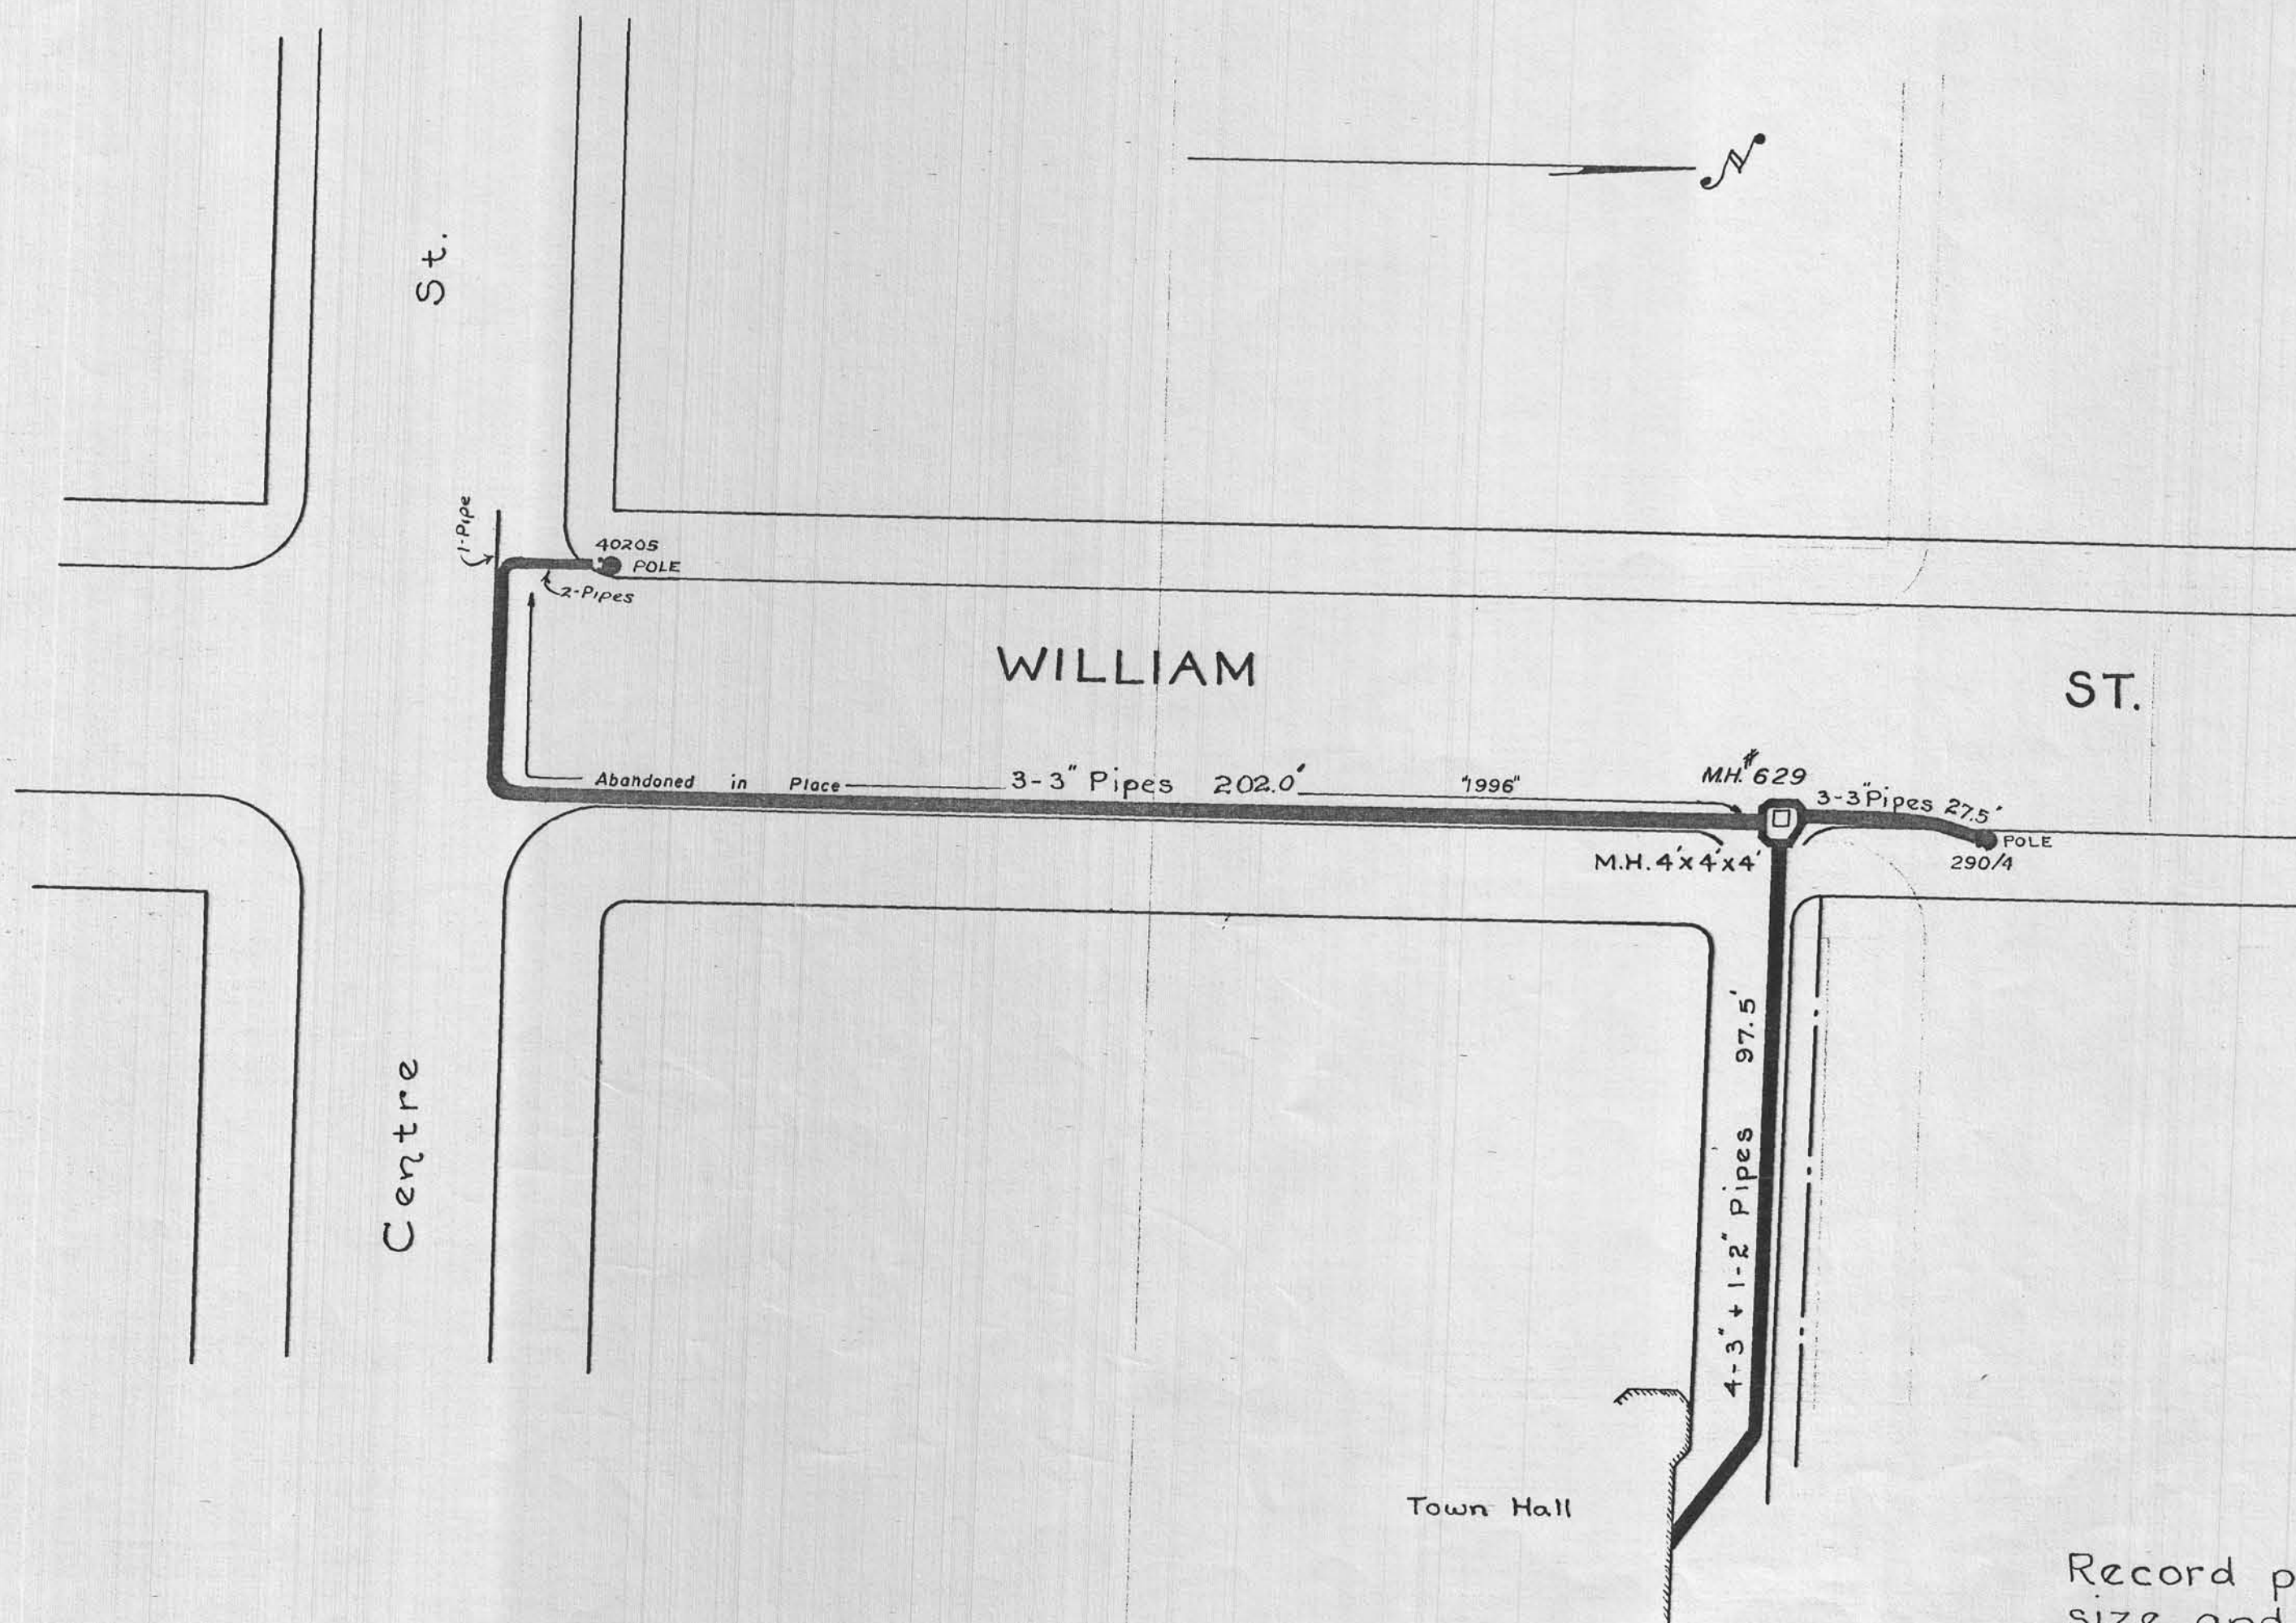

Record plan showing locations,
size and numbers of ducts; and
location and size of manhole in
FAIRHAVEN, MASS.

N.B.G. & E.L. Co.

Mar. 20, 1930.

For grant see Plan No. E.96.F

(CORRECTED 7-11-46-)

3.3.3