

HYDRANT

2-0477

Water: Form #4

Cottage st. S.W. Cor. Bay st.

St.

Make

Am-Darl

Pattern

B-62-B

Set

Feb. 27, 1996

Size

5 1/4"

Bell

6"

Valve

Nozzles

1S 2H

Nt. Pressure

72 lbs.

from On S. line Bay

St.

ft.


E from W line Cottage st.

St.

6.8 ft.

D-63

OPEN TO THE RIGHT

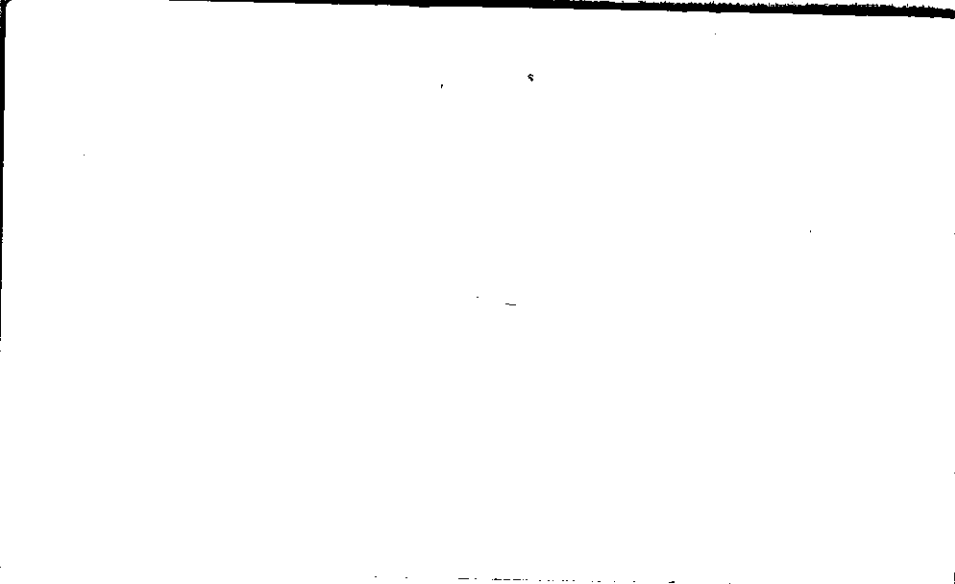

HYDRANT

2-0477

W SIDE COTTAGE STREET

S X Bay St.

Make: U.S.P. Metropolitan 250

Size: 5 1/4"

Set: July 1995

Nozzles: 1S 2H

Nt. Pressure: lbs.

S from S line Bay St.

.8 ft.

E from W line Cottage St.

5.2 ft.

Gate: 7.4 ft.

Record Drawing No. 1994-3-11 C.O. 1

OPEN TO THE RIGHT

