



CITY OF NEW BEDFORD
MASSACHUSETTS
ENGINEERING - 508-979-1550

APPLICATION FOR
CONSTRUCTION OF
PAVED
SIDEWALK/DRIVEWAY

Application No. 11214

Expires: 3/9/17

Date: 3/9/16

Property Owner: Moniz Holdings LLC Tel: 508-717-1518

Address: 19 Anthony Ln New Bedford Ma 02740
street city state zip code

The above hereby requests permission to construct a paved: Cement driveway / ☒ sidewalk located at
Armsby (SS) 200' E X Metcalf St, plot 127E, lot 393 in accordance with the

terms and conditions set forth herein, and the Ordinances of the City of New Bedford.

Sidewalk	Dimensions	Driveway	Width (ft)
☐ Bituminous Concrete	☐	☒ Residential	<u>10 x 16</u>
☐ Concrete Full Width	☐	☐ Commercial	☐
☐ Concrete Ribbon	☐	☐ Relocation/Widening	☐
☐ Curb Needed	☐	☐ Curb Removal	☐
☐	☐	☒ Concrete	<u>10 x 16</u>
☐	☐	☐ Bituminous Concrete	☐

Bonded Contractor: R.J. Canessa Tel: _____

Traffic Commission: _____ Approved _____ Rejected _____ Date _____

Signature _____

Building Dept. _____ Approved (New Building) _____

Per Dr. 3/18/2016 OK Approved - Bldg. Permit# B-16-20
MKS Rejected

Signature Danny Romanowicz

Engineering Department _____ Approved _____ Rejected _____ Date _____

Signature _____


Permit/Inspection fee of \$150.00 must accompany this application.

SPECIAL REQUIREMENTS: Contractor to call 24 hrs. in advance for pre-inspection (prior to pouring)
If curbing is removed, it must be returned within 24 hrs to the D.P.I. Yard
1105 Shawmut Ave., New Bedford

PAID: 150.-

Signature Manuel H. Silva Property Owner
Supervising Civil Engineer

BY: David Lopez

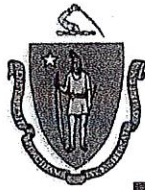

Commonwealth of Massachusetts

CITY OF NEW BEDFORD

City Hall, Room 308, 133 William Street New Bedford, MA 02740 (508) 979-1540



FOUNDATION PERMIT

2/22/2016

No. **B-16-20**

MSBC Sect. 111.8 - Any permit issued shall be deemed abandoned and invalid unless the work authorized by it shall have been commenced within six (6) months after its issuance.

FEE PAID \$100.00

This certifies that Paul D. Bennett

owner/contractor has permission to:

SS

ARMSBY ST

on: Foundations Only 1-2 Family - 100.00

Providing that the person accepting this permit shall in every respect conform to the terms of application therefore on file in this office; to the provisions of the statute of the Commonwealth and to the by-laws of the City of New Bedford relating to the inspection, erection, enlarging, altering, raising, moving, repairing, or tearing down of a building.

Permit is issued subject to the following special requirements: (Restrictions)



Wiring Inspector



Plumbing Inspector



Building Inspector

YOUR AREA INSPECTOR IS: Thomas Welch

Tel. (508) 979-1540 Between 8:00am - 9:00am

**NOTICE: NOTIFY INSPECTOR 48 HOURS IN
ADVANCE OF APPLYING SHEATHING OR LATHING**

OCCUPANCY PERMIT REQUIRED BEFORE OCCUPANCY

No Building or Structure shall be used or occupied until the Certificate of Use and Occupancy shall have been issued by the Building Commissioner - MSBC, Sect. 120.1


This Card Must Be Displayed in a Conspicuous Place on the Premises and Not Torn Down or Removed Until Completion of Work

SUBJECT TO MASSACHUSETTS
STATE BUILDING CODE

Danny D. Bonowicz

Building Inspector


Plan Review Comments:

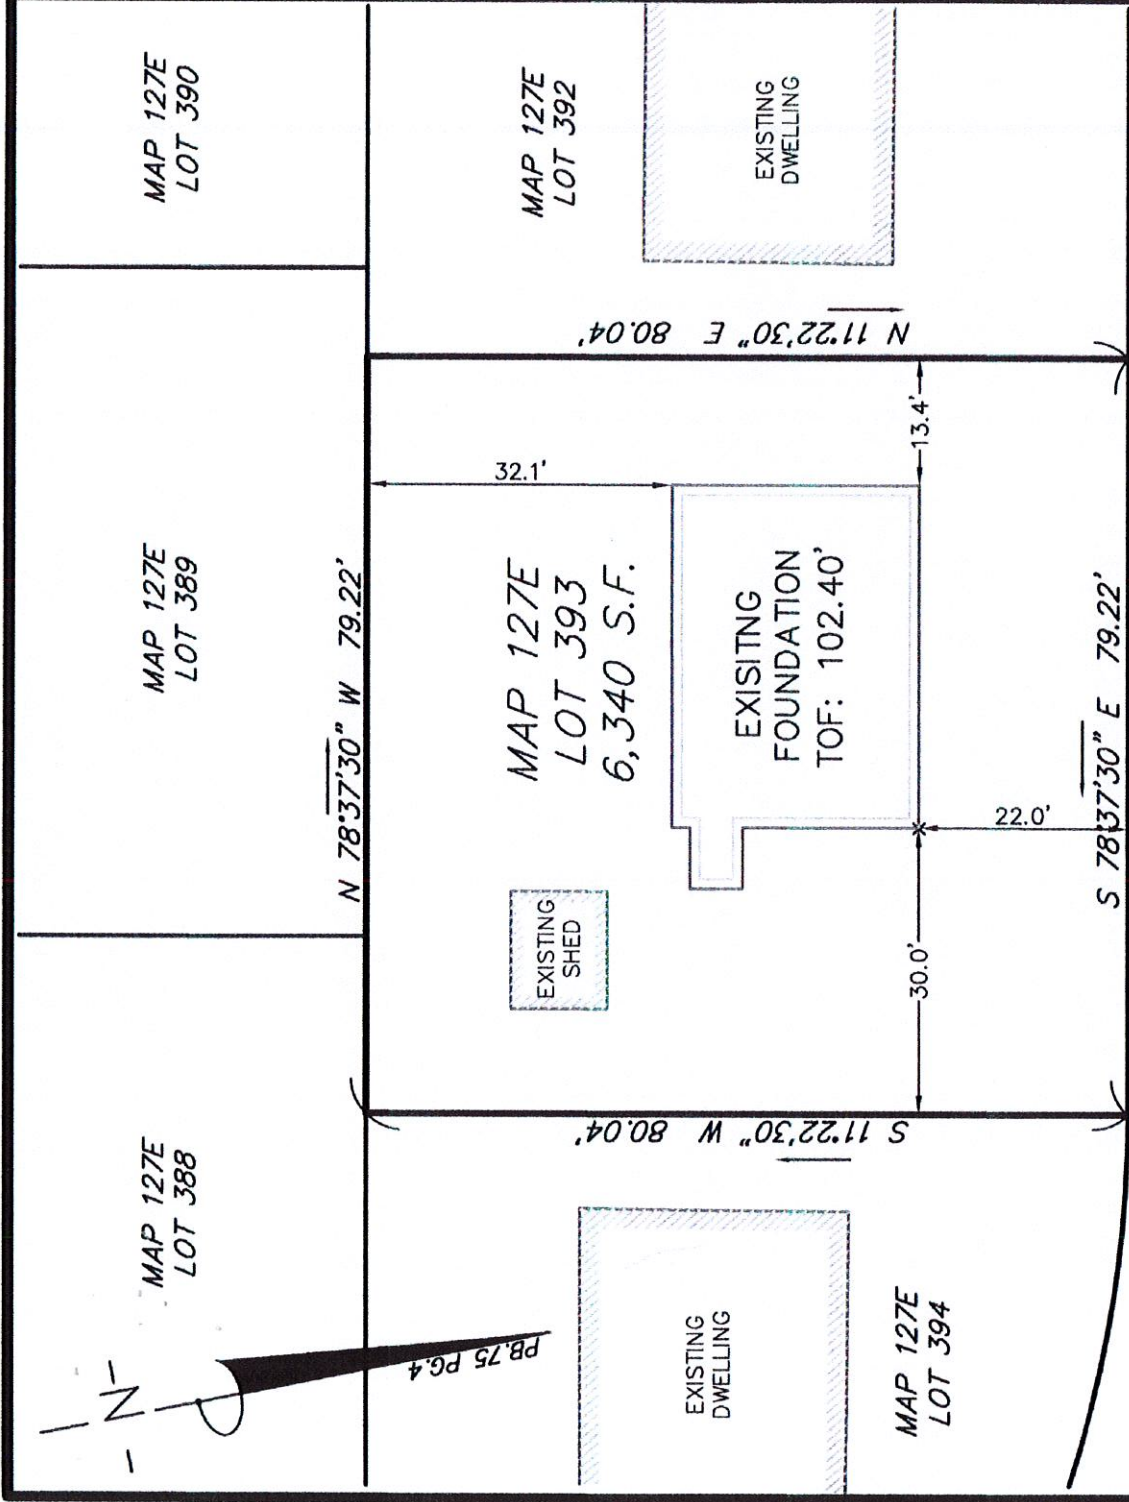

ARMSBY STREET

AS-BUILT FOUNDATION PLAN - MAP 127E LOT 393

ARMSBY STREET
IN
NEW BEDFORD, MA

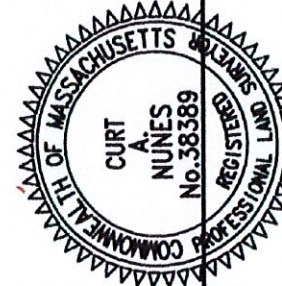


I CERTIFY THAT THE FOUNDATION SHOWN
HEREON, AS BUILT, CONFORMS TO THE CITY
OF NEW BEDFORD ZONING SETBACK
REQUIREMENTS, AND THAT SAID FOUNDATION,
AS BUILT, DOES NOT LIE IN A F.I.R.M. FLOOD
HAZARD ZONE.

PROFESSIONAL LAND SURVEYOR
DATE 3/9/16

DATE: MARCH 9, 2016
SCALE: 1" = 20'

ROMANELLI ASSOCIATES INC.
PROFESSIONAL LAND SURVEYORS
1162 Rockdale Ave. New Bedford, MA 02740
Phone (508) 995-0100 - (508) 995-6678
WWW.ROMANELLI-INC.COM

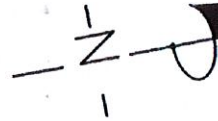


MAP 127E
LOT 388

MAP 127E
LOT 389

MAP 127E
LOT 390

PROPOSED RECHARGER 330
CULTEC DRYWELL 2 UNITS WITH
12" STONE ON SIDES & 6" STONE
BELOW (14.5' x 6.25')

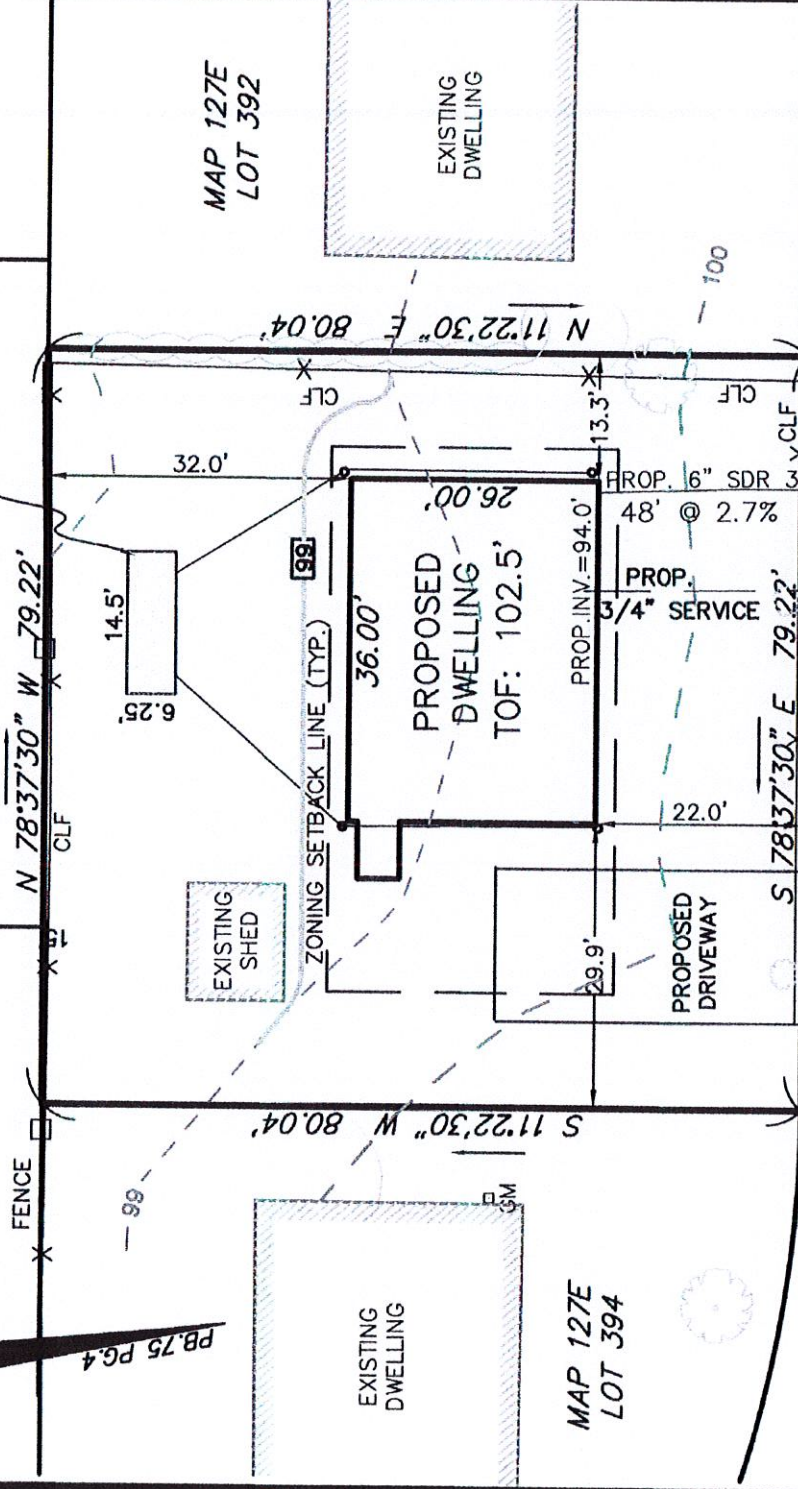

EDGE OF PAVEMENT

EXISTING WATER LINE

ARMSBY STREET

S

S

W

S

S

S

EXISTING 8" SEWER LINE S=2.6%

GAS


GAS

GAS

EDGE OF PAVEMENT

BUILDING PERMIT PLAN - MAP 127E LOT 393

ARMSBY STREET IN NEW BEDFORD, MA

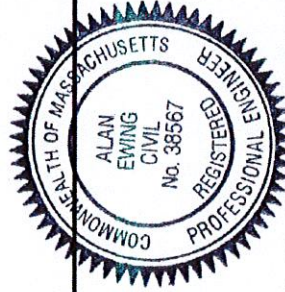


THIS PLAN IS BASED ON AN INSTRUMENT
SURVEY PERFORMED BY ROMANELLI
ASSOCIATES, INC. ON 12/20/15.

Alan Ewing
PROFESSIONAL ENGINEER

DATE

DATE: FEB. 16, 2016

SCALE: 1" = 20'

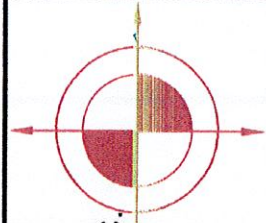

ROMANELLI ASSOCIATES INC.

PROFESSIONAL LAND SURVEYORS

1162 Rockdale Ave. New Bedford, MA 02740

Phone (508) 995-0100 - (508) 995-6678

WWW.ROMANELLI-INC.COM

JN 15-137