



CITY OF NEW BEDFORD

MASSACHUSETTS

ENGINEERING - 508-979-1550

APPLICATION FOR
CONSTRUCTION OF
PAVED
SIDEWALK/DRIVEWAY

Application No. 11331

Expires: 5/1/2018

Date: 5/11/2017

Property Owner: DPM Development Tel: (508) 993-0381

Address: 70 Lambert St Worcester MA 02745
street city state zip code

The above hereby requests permission to construct a paved: ☒ driveway / ☒ sidewalk located at
Worcester St (E.S.) 270' S x Bedford St, plot 127A, lot 301 in accordance with the
terms and conditions set forth herein, and the Ordinances of the City of New Bedford.

Sidewalk	Dimensions	Driveway	Width (ft)
☐ Bituminous Concrete	☒	☐ Residential	☐
☐ Concrete Full Width	☐	☐ Commercial	☐
☐ Concrete Ribbon	☐	☐ Relocation/Widening	☐
☐ Curb Needed	☐	☐ Curb Removal	☐
	☒	☐ Concrete	<u>18 ft Max 13'</u>
	☐	☐ Bituminous Concrete	☐

Bonded Contractor: ABLE Asphalt Tel: _____

Traffic Commission: _____ Approved _____ Rejected _____ Date _____

Building Dept.
Signature _____

Approved (New Building)

Approved - Bldg. Permit# _____

Rejected

Engineering Department
Signature _____

Approved _____ Rejected _____ Date 5/11/17
Signature Stephane Dupros (CT.)

Permit/Inspection fee of \$150.00 must accompany this application.

SPECIAL REQUIREMENTS: Contractor to call 24 hrs. in advance for pre-inspection (prior to pouring)
If curbing is removed, it must be returned within 24 hrs to the D.P.I. Yard
1105 Shawmut Ave., New Bedford

PAID: \$150.00

Stephane Dupros x. Roda Monje
Supervising Civil Engineer Property Owner
BY Chereli Tomas

127A-48

N/F
VILANRE
619 CHURCH ST

127A-47

N/F
PIRES
611 CHURCH ST

127A-45

N/F
MARK COSTA
LIVING TRUST
609 CHURCH ST



IP FD

106.16'
S 09°09'34" E

CBDH FD


127A-19

N/F
P & I REALTY
TRUST CORP.
104 WORCESTER ST

LOT 5
8,013± SF

127A-18
N/F
MIRANDA
94
WORCESTER
ST

S 80°44'51" W 100.88'

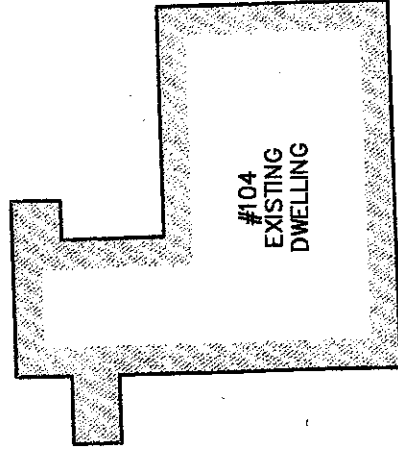

#104
EXISTING
DWELLING

S 79°35'31" W 52.28'

10.5'

EXISTING
FOUNDATION
TOF: 107.40'

25.6'

23.92'
N 50°32'38" W

N 09°09'34" W
90.00'

22.0'


CB/CENTER

#94
EXISTING
DWELLING

WORCESTER STREET
(PUBLIC - 50' WIDE)

AS BUILT FOUNDATION PLAN - MAP 127A LOT 19

LOT 5 - WORCESTER ST.
IN
NEW BEDFORD, MA.

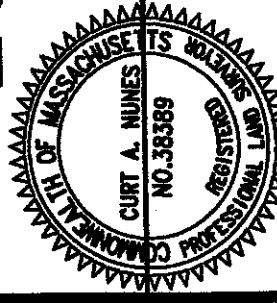

I CERTIFY THAT THE FOUNDATION SHOWN
HEREON, AS BUILT, CONFORMS TO THE CITY
OF NEW BEDFORD ZONING SETBACK
REQUIREMENTS.

[Signature] 5/5/17
PROFESSIONAL LAND SURVEYOR DATE

DATE: MAY 5, 2017

SCALE: 1" = 20'

ROMANELLI ASSOCIATES INC.
PROFESSIONAL LAND SURVEYORS
1162 Rockdale Ave. New Bedford, MA 02740
Phone (508) 995-0100 - (508) 995-6678
WWW.ROMANELLI-INC.COM

IN 16-003