

APPLICATION / AGREEMENT

For DISTURBANCE PERMIT within the City of New Bedford

Permit #	494-18
Dig Safe #	
Date Issued:	December 06, 2018

This permit shall be posted at the work site, and shall remain until the work is completed. It is subject to inspection at all times.

TO THE MAYOR AND CITY COUNCIL: _____ DISTURBANCE PERMIT

Permission is hereby requested to excavate the surface of: _____ City Property

Location of work: Intersection of Tarklin Hill Road and King's Highway

(Railroad tracks)

Substantially as per plan annexed, for the purpose of: _____

FOR INSPECTION ONLY A 24 HOUR
NOTICE IS REQUIRED AND THE
CONTRACTOR/APPLICANT IS
REQUIRED TO NOTIFY THE D.P.I.
@ 508-979-1550 Press 4 Repair
~~PERMIT REQUIRED~~

Vacuum excavation

Work will begin (weather permitting) on: 12/7/18

Work will end (weather permitting) on: 1/31/19

Applicant Name: Cory Turner bldg

Company Name: New England Boing

Hampshire

Excavator(s) Name: on file

Hoisting Equipment License Number: _____

Grade: _____

Expiration Date: _____

Contact Name: Cory Turner bldg

Name & Contact Number of Insurer: Eastern States Insurance


Approved By: Stephen Carpenter

Title: Engineering Supervisor Date: 12-6-2018

Roadway closures will require authorization from the Commissioner of Public Infrastructure.
Traffic management plans may be required.

For inspection, 24 hour notice is required and the Contractor / Applicant is required to
notify the D.P.I. @ 508-979-1550 Press 4 Repair. Permit Expires in 3 Months from work start date.

Provide Sketch

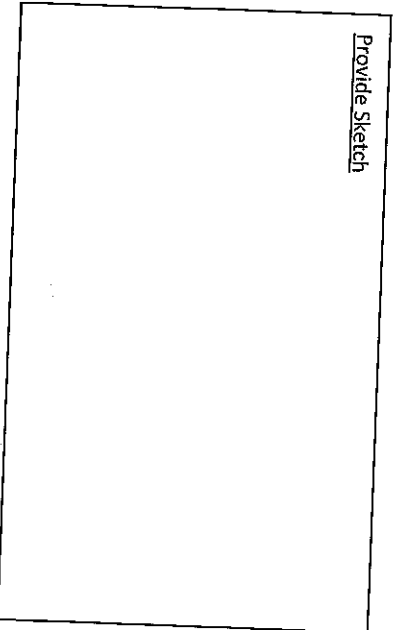

UTILITY LOCATION
VACUUM EXCAVATION
11/28/18

MATCH LINE SEE SHEET CV-315

ISSUED FOR BID

SOUTH COAST RAIL - PHASE I
HEAVY ACTION CIVIL WORKS & TACKLIN HILL ROAD

NEW BEDFORD MAIN LINE
TARKILN HILL ROAD
UTILITY PLANS 2



PROJECT NUMBER	DATE		ISSUE
	DATE	TIME	
PROJECT: AIRCRAFT	DATE: 10/10/77	TIME: 1400	PUN NO.
VERT. PHONE	TIME: 0800		
NAME: [REDACTED]			ISSUE: CIV-314

MATCH LINE SEE SHEET CV-313

• Summary

2. FOR MORE INFORMATION REGARDING DRAINAGE REFER TO SHEETS CV-309 THROUGH CV-342.

CONTRACTOR SHALL BE AWARE THAT RECORD DRAWINGS INDICATE THE POSSIBLE PRESENCE OF AN ABANDONED STONE CHASED STORM DRAIN ON THE NORTHERN SIDE OF TARKLEN HILL ROAD THROUGH THE CADE CROSSING. IF ENCOUNTERED, THE CONTRACTOR SHALL REMOVE ANY PORTIONS OF THE SEWER IN CONFLICT WITH THE PROPOSED WORK AND BULKHEAD THE REMAINING PROPOSED PORTIONS OF THE SEWER, AT NO ADDITIONAL COST TO THE DEPARTMENT.

THE NAME OF THE JOURNAL IS: JOURNAL OF THE AMERICAN MEDICAL ASSOCIATION
PUBLISHED WEEKLY
535 N. Dearborn Ave., Chicago, Ill. 60610
Subscription price: \$12.00 per year in advance
Single copies: 35¢
Second class postage paid at Chicago, Ill.
Postmaster: Send address changes in U.S.A. to JOURNAL OF THE AMERICAN MEDICAL ASSOCIATION, 535 N. Dearborn Ave., Chicago, Ill. 60610
Subscription price: \$12.00 per year in advance
Single copies: 35¢
Second class postage paid at Chicago, Ill.
Postmaster: Send address changes in U.S.A. to JOURNAL OF THE AMERICAN MEDICAL ASSOCIATION, 535 N. Dearborn Ave., Chicago, Ill. 60610