



CITY OF NEW BEDFORD
MASSACHUSETTS
ENGINEERING-508-979-1550

APPLICATION FOR
CONSTRUCTION OF
PAVED
SIDEWALK/ DRIVEWAY

Expires: 5-17-2020

Application No. 11531

Date: 5-17-19

Property Owner: Mony Holdings Tel: 508 917 1518

Address: 19 Anthony Terrace 138 MA 02740
Street City State zip code

The above hereby request permission to construct a paved: / driveway / / sidewalk located at Anthony Ct. (NS) 138c #2, plot 138c, lot 112 in accordance with the terms and conditions set forth herein, and the Ordinances of the City of New Bedford.

<u>Sidewalk</u>	<u>Dimensions</u>	<u>Driveway</u>	<u>Width (ft)</u>
<u>Residential</u>	<u>/</u>	<u>/</u> Residential	<u>/</u>
<u>Commercial</u>	<u>/</u>	<u>/</u> Commercial	<u>/</u>
<u>Bituminous Concrete</u>	<u>/</u>	<u>/</u> Relocation / Widening	<u>/</u>
<u>Concrete Full Width</u>	<u>/</u>	<u>/</u> Curb Removal	<u>18' 6"</u>
<u>Concrete w/ Grass Ribbon</u>	<u>/</u>	<u>/</u> Concrete	<u>18' x 12'</u>
<u>Curb needed</u>	<u>/</u>	<u>/</u> Bituminous Concrete	<u>/</u>

Comments: New Build

Bonded Contractor: ABE ASPHET Tel: /

Traffic Commission: / Approved / Rejected / Date /

Signature /

Building Dept.

/ Approved (New Building)
/ Approved - Bldg. Permit # /
/ Rejected

Signature /

Engineering Dept.

✓ Approved / Rejected 5/17/19 Date

Pending
Sidewalk

Signature Stephen Crumpker (CT)

Permit / Inspection fee of \$150.00 must accompany this application.

Special Requirements:

Contractor to call 24 hrs. in advance for pre-inspection (prior to pouring). If curbing is removed, it must be returned in whole pieces within 24 hrs. to the D.P.T. City Yard on Liberty St. (between Parker St. & Durfee St.) accompanied with original curbing receipt.

\$150

PAID: 5/17/19 Check # 1155

Stephen Crumpker
Supervising Civil Engineer

Chris Heniz
Print name: (property owner/representative)

By: Shmuel J. J.

Signature: (property owner/representative)



COMMONWEALTH
LAND SURVEYORS, INC.
1162 SOUTH MAIN STREET
ATTLEBORO, MASSACHUSETTS 01903
508-465-2500


MAP 136C
LOT 113

10' WIDE UTILITY EASEMENT

MAP 136C
LOT 112
8,105 S.F.

MAP 136C
LOT 99


MAP 136C
LOT 98

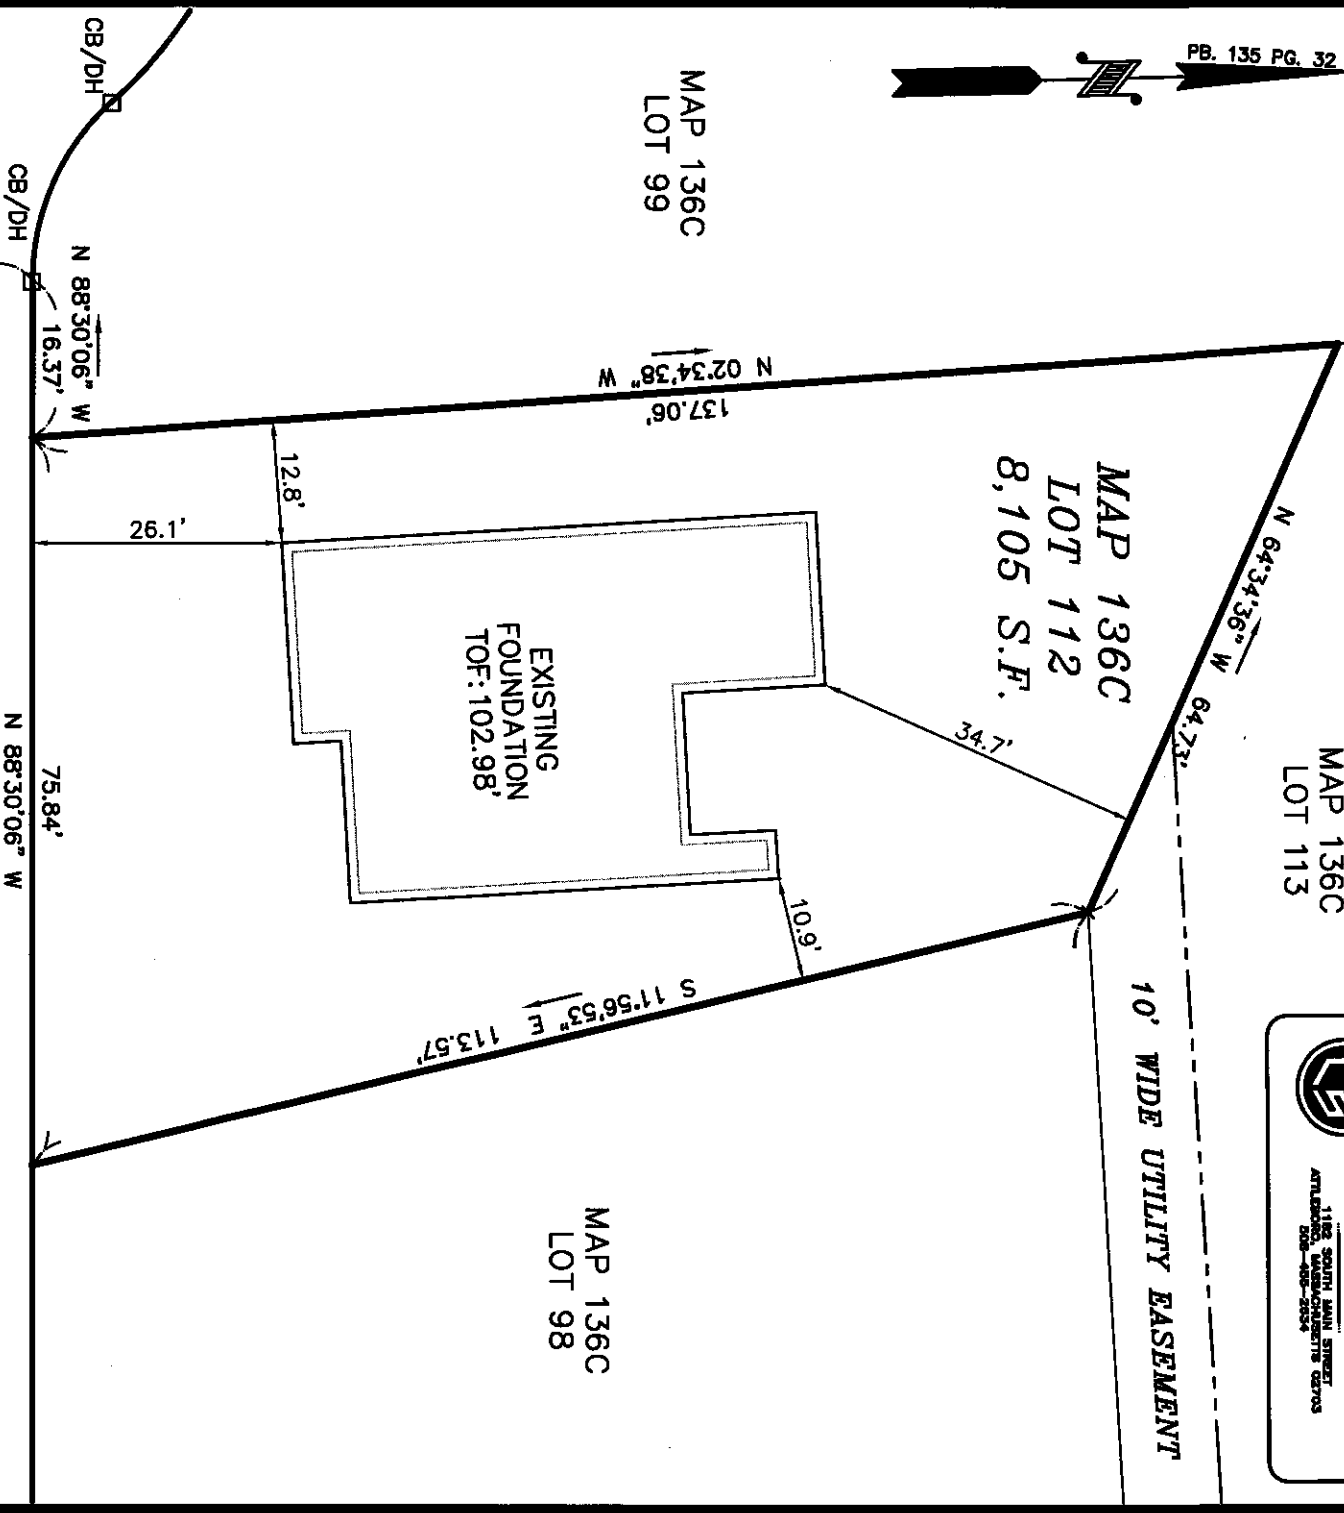

ARAUJO (PUBLIC - 50' WIDE) COURT

AS-BUILT FOUNDATION PLAN

ARAUJO COURT
IN
NEW BEDFORD, MA

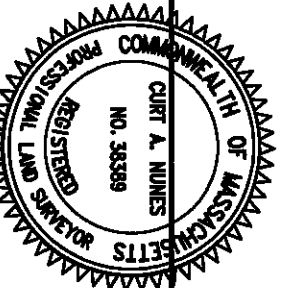

I CERTIFY THAT THE FOUNDATION SHOWN
HEREON, AS BUILT, CONFORMS TO THE CITY
OF NEW BEDFORD ZONING SETBACK
REQUIREMENTS.

PROFESSIONAL LAND SURVEYOR DATE 5/16/2019

DATE: MAY 16, 2019

SCALE: 1" = 20'

ROMANELLI ASSOCIATES INC.

PROFESSIONAL LAND SURVEYORS

1162 Rockdale Ave. New Bedford, MA 02740

Phone (508) 995-0100 - (508) 995-6678

WWW.ROMANELLI-INC.COM

