



Expires 6-12-20

PERMIT NO.
24823

CITY OF NEW BEDFORD
SEWER AND/OR STORM DRAIN PERMIT

DATE 6-12-19

This certifies that permission is granted to MONTE HARRIS 19 ANTHONYTON RD NO 0740 508 717-1518
Property Owner Tel.

To connect a sewer and/or storm drain located at Acushnet Ave (US) 150' N x Acushnet Ct.
Assessor's Plot 1340 Lot 113 to the sewer and/or storm drain in Acushnet Ave (US) 150' N x Street
Acushnet

To be laid in accordance with the conditions in this application and the City of New Bedford ordinances.
TYPE OF USE: RESIDENTIAL COMMERCIAL INDUSTRIAL FLOW G.P.D.

If applicant other than actual property owner, attach Letter of Authorization from Property Owner.

Name Tel.
Mailing Address Tel.
The Bonded Contractor/Drain Layer authorized to perform this work is:
ABLE USPEL
Name Address Tel.
Type of Pipe Required: 16" SDR35 PVC

PERMIT EXPIRES ONE YEAR AFTER DATE OF ISSUE

- Requires separate connections for sewage and storm drain where applicable. Storm water cannot be discharged to a sanitary sewer.
- All work must be inspected and approved by a D.P.I. inspector before backfilling.
- If this connection is to be part of a private service shared jointly with other building owners, attach copy of Recorded Joint Maintenance Agreement.
- Permits can be issued to Industrial and/or Commercial Applicants only upon receipt and approval by the Commissioner of Public Infrastructure of required plans and supplemental information.
- In addition, a City-issued Industrial User Discharge Permit and/or a Sewer Extension/Connection Permit issued by the Commonwealth of Massachusetts D.E.P. shall be required by the City for Industrial Discharge into the sewer system.
- Industrial User Discharge Permit No. Date

Comm. Mass. Sewer Comm./Ext. Permit No. Date
A Filing and Inspection Fee of \$ 4150, plus an Entrance Fee of \$, where applicable, must accompany this application.

Bank# Bay Coast Bank Check# 1183 Date 6-12-19 Receipt# 2276971

Other requirements: FOR INSPECTION ONLY A 24 HOUR
 NOTICE IS REQUIRED AND THE
 CONTRACTOR/APPLICANT IS
 REQUIRED TO NOTIFY THE D.P.I.
 @ 508 979-1550 Press 4 Repair
 PERMIT EXPIRES 1 YEAR

Connection made to Sewer Part Storm Drain

Applicant agrees to abide by the above terms, as well as all pertinent ordinances of the City of New Bedford, and such other special rules as the Commissioner of Public Infrastructure and/or City Engineer may deem necessary.


Stephen Carpenter City Engineer
Engineering Supervisor
Signature of Property Owner or Representative

INSPECTOR'S REPORT

INSPECTED BY:
DATE:
COMMENTS:

APPROVED DISAPPROVED

SIGNATURE

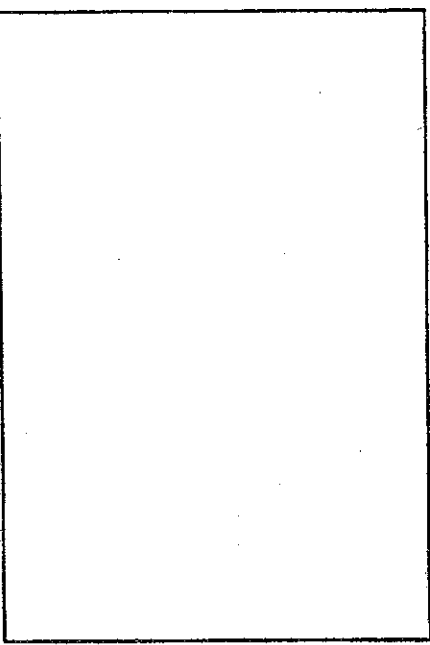

SKETCH PLAN




COMMONWEALTH
LAND SURVEYORS, INC.
4 HATFIELD STREET
ATTLEBORO, MASSACHUSETTS 02703
508-458-2834

MAP 136C
LOT 99

MAP 136
LOT 19


Pg. 135 Pg. 32

MAP 136C
LOT 112

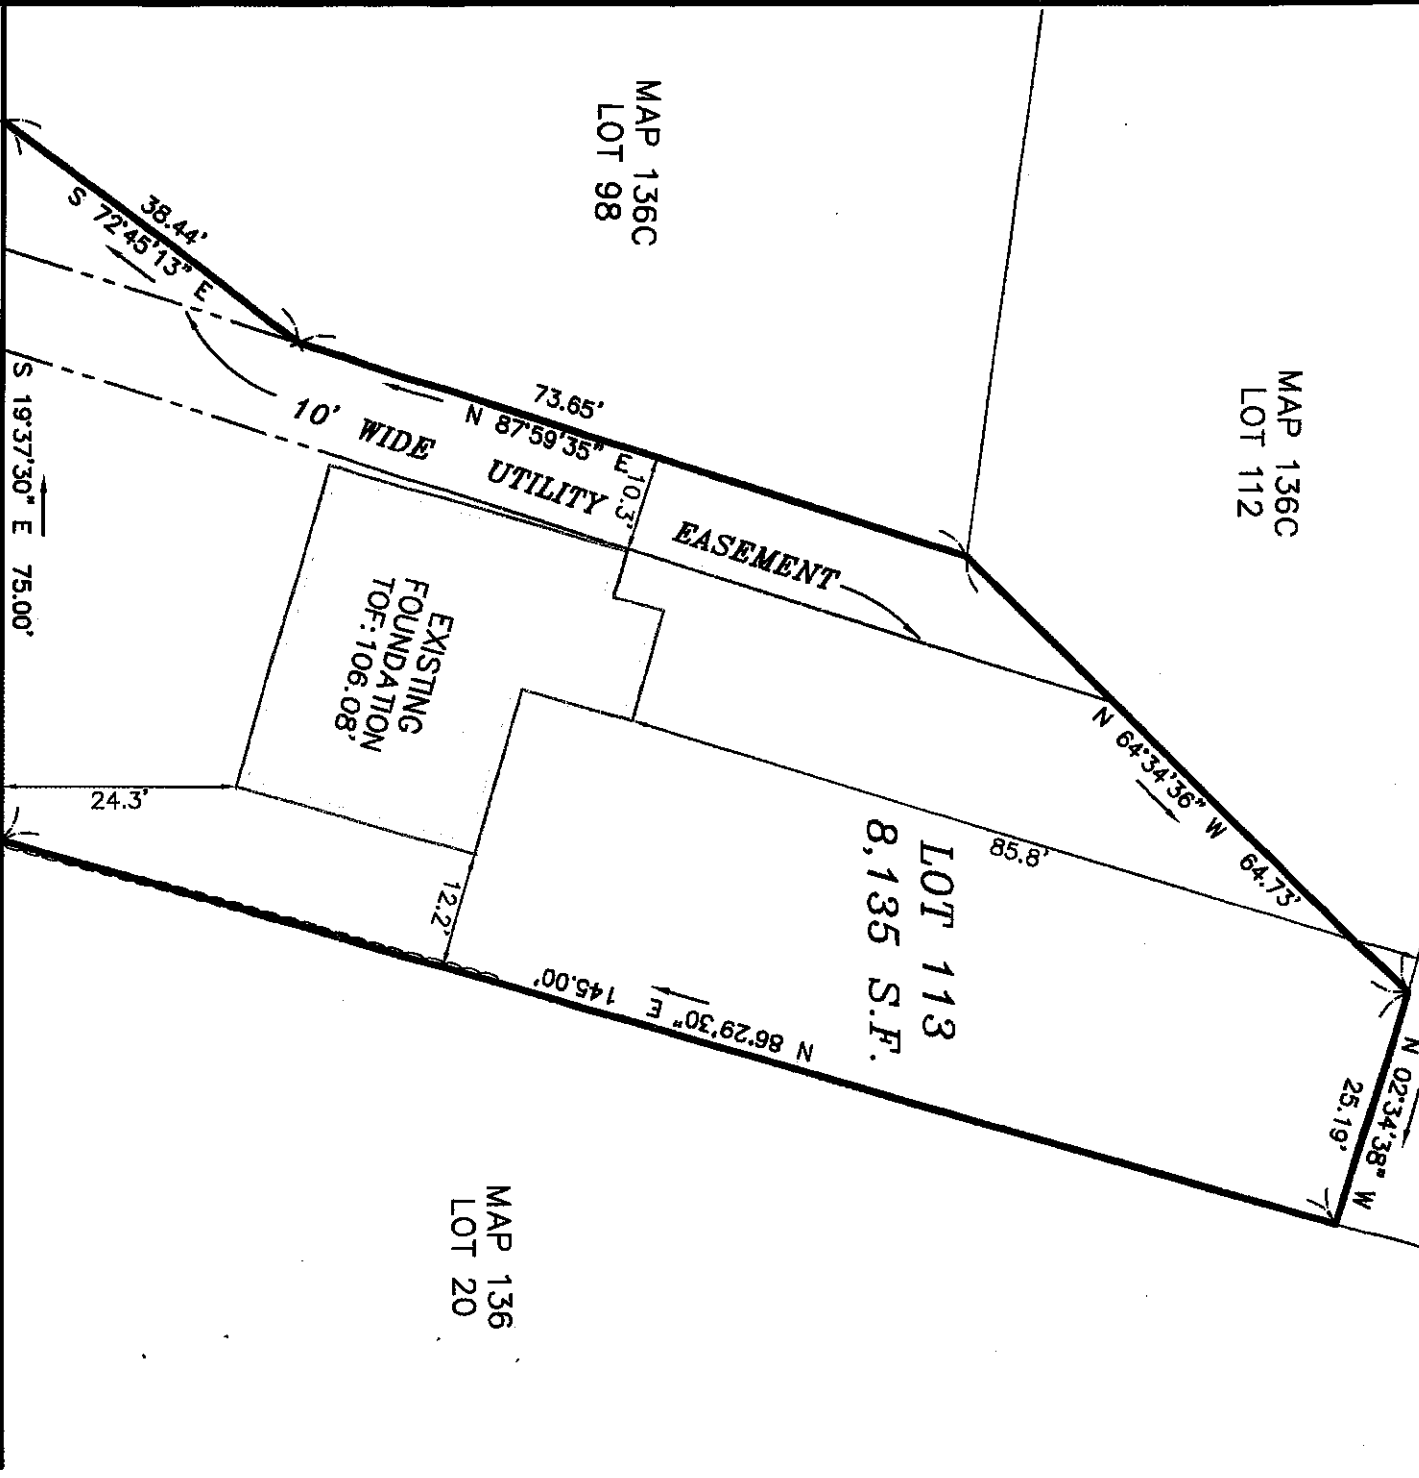

ACUSHNET (PUBLIC - 60' WIDE) AVE.

AS-BUILT FOUNDATION PLAN

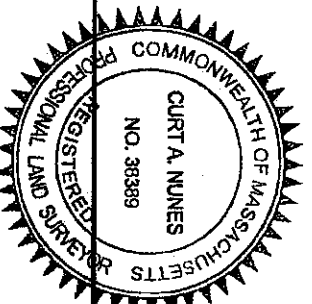

ACUSHNET AVE.
IN
NEW BEDFORD, MA

DATE: JUNE 6, 2019


SCALE: 1" = 20'

I CERTIFY THAT THE FOUNDATION SHOWN
HEREON, AS BUILT, CONFORMS TO THE CITY
OF NEW BEDFORD ZONING SETBACK
REQUIREMENTS.

PROFESSIONAL LAND SURVEYOR

6/06/2019
DATE

ROMANELLI ASSOCIATES INC.
PROFESSIONAL LAND SURVEYORS
1162 Rockdale Ave. New Bedford, MA 02740
Phone (508) 995-0100 - (508) 995-6678
WWW.ROMANELLI-INC.COM

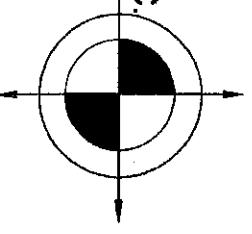

JN 17-182

CITY OF NEW BEDFORD

City Hall, Room 308, 133 William Street New Bedford, MA 02740 (508) 979-1540



FOUNDATION PERMIT

5/14/2019

FEE PAID \$100.00

MSBC Sect. 111.8 - Any permit issued shall be deemed abandoned and invalid unless the work authorized by it shall have been commenced within six (6) months after its issuance.

This certifies that Daniel P Moniz

owner/contractor has permission to:

on: Foundations Only 1-2 Family - 100.00

Providing that the person accepting this permit shall in every respect conform to the terms of application therefore on file in this office; to the provisions of the statute of the Commonwealth and to the by-laws of the City of New Bedford relating to the inspection, erection, enlarging, altering, raising, moving, repairing, or tearing down of a building.

Permit is issued subject to the following special requirements: (Restrictions)



Wiring Inspector



Plumbing Inspector



Building Inspector

YOUR AREA INSPECTOR IS: Thomas Welch

Tel: (508) 979-1540 Between 8:00am - 9:00am

NOTICE: NOTIFY INSPECTOR 48 HOURS IN
ADVANCE OF APPLYING SHEATHING OR LATHING

OCCUPANCY PERMIT REQUIRED BEFORE OCCUPANCY

No building or structure shall be used or occupied until the Certificate of Use and Occupancy shall have been issued by the Building Commission. MSBC, Sect. 110.1

This Card Must Be Displayed in a Conspicuous Place on the Premises and Not Torn Down or Removed Until Completion of Work

SUBJECT TO MASSACHUSETTS
STATE BUILDING CODE

Danny J. Moniz
Building Inspector

Plan Review Comments:



City of New Bedford, MA

Building Division

City Hall, Room 308, 133 William Street
New Bedford, MA 02740

RECEIPT

APPLICATION TO CONSTRUCTION, REPAIR, RENOVATE, CHANGE THE USE OR OCCUPANCY OF, OR DEMOLISH
A DWELLING

Permit No #: TB-19-764	Date Received: 4/9/2019
Signature: Daniel P Moniz	Date
Building Commissioner/Inspector of Buildings:	

SECTION 1 : SITE INFORMATION

1.1 Property Address ES ACUSHNET AVE	1.2 Assessors Map & Parcel Number 136C-98
1.3 Zoning Information RA	1.4 Property Dimensions 28663
Zoning District	Proposed Use
	Lot Area
	Frontage (ft)

1.5 Building Setbacks (ft)					
Front Yard		Side Yard		Rear Yard	
Required	Provided	Required	Provided	Required	Provided
20.00	24.00	8.00	10.00	30.00	80.00
1.6 Water Supply	False	1.7 Flood Zone Information		1.8 Sewage Disposal	
				False	

SECTION 2: PROPERTY AUTHORIZED AGENT

Agent of Record Daniel P Moniz	70 Lambeth Street	New Bedford	MA	02745
Name	Address			

SECTION 3: Description of Proposed Work

Permit For: Foundations Only 1-2 Family - 100.00

Brief Description of Proposed Work:

new single family

m.s.

when we find out what the new parcels are we will move each permit to the correct parcel.

Map 136C Lot 98-3

Map 136C Lot 113
new site plan

SECTION 4: Estimated Construction Costs / Permit Fees

Total Project Cost	\$7,000.00	Payment Date	Amount Paid	Check No
Total Permit Fee Paid	\$100.00	5/10/2019	\$100.00	1150
		Account Number 02401200-453010 ISPBPM		

THIS IS NOT A PERMIT