

EVERSEURCE **ENERGY**

NELSON STREET MAIN RELAY INSTALLATION OF 1290' OF 2" PH LIP GAS MAIN **NELSON STREET** NEW BEDFORD, MASSACHUSETTS ENE PROJECT #: 2005881.33 EVERSOURCE PROJECT #: 1592785

SSUED FOR INSTRUCTION 02/02/2021	SEALED BY:	SEALED ON: 02/02/2021	DESIGNED IN ACCORDANCE WITH TITLE 49-PART 192 OF MINIMUM FEDERAL SAFETY STANDARDS AND GPTC GUIDE FOR GAS TRANSMISSION AND DISTRIBUTION PIPING SYSTEMS. LATEST EDITION.	FIELD VERIFY PRIOR TO PIPE
		LICENSE EXPIRATION: 06/30/2022	ENERGINEERING 29 BARTLETT STREET MARLBOROUGH, MA 01752 TEL. (630) 353-4000 FAX (630) 535-7777 WWW.ENENGINEERING.COM	

	Mosher St Prision St Division St te St Division St St St St St St St St St St	Paradise of Division St Jouvette St Netron Concerning of C	Division S Dowette St Dowette St Dowette St Mi Antoja Mes Costa's Clish Everess Scott St Luzo Auto Body Cove Rd	D D D D D D D D D D D D D D D D D D D
	Cove Rd	Coverco	our nu	New Be
		LOCUS PI NOT TO SCA		
		SHEET INDEX		
	SHEET NUMBER	DESCRIPTION SITE PLAN, DRAWING LEGEND	AND SHFFT INDFX	
	2	GENERAL NOTES	, THE CHEET INDEA	
	3	INSTALLATION PLAN		
	5	INSTALLATION PLAN		
	5	INSTALLATION PLAN		
) 6	INSTALLATION PLAN		
)	LOCATION A - PHASE 1, 2 A	ND SCHEDULE OF MATERI	ALS
) 9	LOCATION B - PHASE 1, 2 A		
) 10	LOCATION C - PHASE 1, 2 A	ND SCHEDULE OF MATERI	ALS
) 11	LOCATION D - PHASE 1, 2 A	ND SCHEDULE OF MATERI	ALS
		STANDARD CORROSION DETAILS		
SOUTH SECOND STREET				
		TED SITE PLAN & SHEET II		ZS/AB/EK
	2 IFC - NO CH	TED SITE PLAN IANGES TO THIS SHEET	01/14/2021	WS/AB/EK ZS/AB/EK
		TED SHEET INDEX R CONSTRUCTION	10/29/2020 10/14/2020	LR/AB/EK LR/AB/EK
	NO. DESCRIPTI	ON	DATE	DW/CK/AP
		EVERS€L		
		NELSON STREET MA	ENERGY AIN RELAY	
DIMENSIONS		NEW BEDFORD, MASS ITE PLAN, LOCUS PLAN A		
	SCALE: AS NOTE	,		ET 1 OF 12
	DRAWN BY / DATE AC 12/11/2020	CHECKED BY / DATE AB 02/02/2021		REV. NO.
	APPROVED BY / DATI EK 02/02/2021	E MA21PIPNEB002R4	MA-21-PIP-NEB-002	-01 4

GENERAL NOTES

- 1. IF ANY OF THE FOLLOWING OCCUR A DRAWING REVISION IS REQUIRED AND MUST BE APPROVED AND/OR STAMPED BY THE ENGINEER OF RECORD. CHANGES CAN BE APPROVED AND/OR STAMPED BY A PROJECT ENGINEER, BUT THE ENGINEER OF RECORD MUST BE INFORMED.
 - A. IF THE TIE IN POINT MOVES TO A DIFFERENT SEGMENT OF PIPE THAN SHOWN
 - B. IF A CHANGE IN THE LOCATION OF VALVES IS REQUIRED
 - C. IF THERE IS ANY CHANGE TO WHAT IS SHOWN ON THE DRAWING WITHIN 50 FT OF A
 - PRESSURE REGULATING STATION, DISTRICT REGULATOR, OR GATE STATION
 - D. IF A CHANGE IN PIPE SIZE, MATERIAL, FITTINGS, OR WALL THICKNESS IS REQUIRED.
- 2. MINOR CHANGES SUCH AS OFFSETS MAY NOT REQUIRE DRAWING CHANGES.
- 3. EXCAVATOR SHALL CALL DIGSAFE/CALL BEFORE YOU DIG (DIAL 811) AT LEAST 72 HOURS PRIOR TO CONSTRUCTION. SATURDAYS, SUNDAYS, AND HOLIDAYS ARE EXCLUDED FROM THE 72-HOUR TIME SPAN, NOT CONSIDERED BUSINESS WORKDAYS.
- 4. CONSTRUCTION DRAWINGS ARE BASED ON EVERSOURCE HISTORICAL DOCUMENTATION AND HAVE NOT BEEN FIELD VERIFIED. WHEN THE PIPE IS EXPOSED AND VARIANCES TO THE CERTIFIED DRAWINGS ARE FOUND, CONTACT GAS ENGINEERING TO DETERMINE PATH FORWARD.
- 5. ALL WORK SHALL BE PERFORMED PER EVERSOURCE, LOCAL, STATE, OSHA, AND FEDERAL REGULATIONS AND STANDARDS.
- 6. MATERIAL AND CONSTRUCTION SHALL CONFORM TO EVERSOURCE GAS STANDARDS.
- 7. THE LOCATIONS OF EXISTING UTILITIES AND UNDERGROUND STRUCTURES ARE APPROXIMATE AND MUST BE FIELD VERIFIED. ADDITIONAL UNDERGROUND FACILITIES MAY EXIST THAT ARE NOT SHOWN ON THESE DRAWINGS WHICH MAY REQUIRE ADDITIONAL OFFSETS IN THE PIPELINE.
- 8. WORK LOCATIONS SHOWN ON THE DRAWINGS ARE APPROXIMATE. EXACT LOCATIONS OF TIE-INS SHALL BE DETERMINED AT THE TIME OF CONSTRUCTION TO SUIT FIELD CONDITIONS AT THE SPECIFIC TIE-IN POINT. VERIFY LOCATIONS OF ALL EXISTING UTILITIES PRIOR TO BEGINNING ANY TIE-IN WORK.
- 9. ALL LIVE GAS WORK INCLUDING BUT NOT LIMITED TO TAPPING OF FITTINGS ON LIVE MAINS, STOPPING, MANIPULATING VALVE, ABANDONMENT, SHALL BE PERFORMED BY, OR AT THE DIRECTION AND UNDER THE DIRECT SUPERVISION OF EVERSOURCE GAS PERSONNEL AND IN ACCORDANCE WITH THE WRITTEN PROCEDURE. DRAWING CHANGES MAY ALSO REQUIRE A CHANGE TO THE PROCEDURE.
- 10. EXCAVATOR IS REQUIRED TO PROTECT EXISTING UTILITIES, STRUCTURES, LANDSCAPE FEATURES, SIGNAGE, CURBS, ETC. CARE SHOULD BE TAKEN NOT TO DISTURB OR DAMAGE SUCH ROADWAY, SIDEWALKS, AND GRASS DISTURBED SHALL BE RESTORED TO THE SATISFACTION OF THE CITY OR TOWN. PLANT BEDS WILL BE RELOCATED TO THEIR EXISTING REGULAR LOCATION.
- 11. IF THE PROJECT IS WITHIN 50 FEET OF A DISTRICT REGULATOR OR GATE STATION, ENSURE THAT A QUALIFIED I&R TECHNICIAN IS ON SITE.
- 12. ALL TRAFFIC CONTROL SHALL CONFORM TO THE LATEST EDITION OF THE MANUAL OF UNIFORM TRAFFIC CONTROL DEVICES (MUTCD), INCLUDING ALL REVISIONS AND ADDENDA. ALL TRAFFIC CONTROL DEVICES WILL BE SUPPLIED BY EXCAVATOR.
- 13. PROPERTY LINES, STRUCTURES AND EXISTING CONDITIONS DEPICTED ON PLANS ARE BASED ON EVERSOURCE GIS INFORMATION AND HAVE NOT BEEN VERIFIED BY LAND SURVEY UNLESS NOTED.
- 14. EXISTING SERVICES SHOWN ON PLAN ARE FOR INFORMATION ONLY. PROPOSED SERVICES ARE NOT SHOWN ON PLANS AND ARE TO BE INSTALLED PER EVERSOURCE CONSTRUCTION STANDARDS.
- 15. PROPOSED WORK SHALL BE PERFORMED AND COMPLETED IN COMPLIANCE WITH ALL PERMITS AND APPROVALS.
- 16. MAINS AND SERVICES SHALL BE PRESSURE TESTED IN ACCORDANCE WITH EVERSOURCE OM-205.
- 17. MAOP:


LP = 14" W.C.
LIP = 35 PSIG
IP = 60 PSIG
HP = 90 PSIG


18. ALL WORK SHALL BE PERFORMED PER EVERSOURCE, LOCAL, STATE AND FEDERAL REGULATIONS AND STANDARDS.

- 19. ALL PIPE WILL BE INSTALLED WITH A MINIMUM DEPTH IN ACCORDANCE WITH EVERSOURCE STANDARDS
- 20. SQUEEZE OPERATIONS SHOULD BE COMPLETED IN ACCORDANCE WITH OM-233
- 21. ENSURE ALL SERVICES BEING TRANSFERRED TO A HIGHER PRESSURE SYSTEM HAVE UPGRADED PRESSURE REGULATORS INSTALLED PRIOR TO ACTIVATION.
- 22. ENSURE VALVES ON EXISTING MAIN, WHERE PROPOSED MAIN WILL BE INSERTED HAVE BEEN MADE INOPERABLE.
- 23. ADDITIONAL VALVES AND TEES THAT ARE INCLUDED IN THE SCHEDULE OF MATERIALS MAY BE INSTALLED TEMPORARILY WHEN NEEDED TO FACILITATE TIE-INS AND PURGES.
- 24. METFIT FITTINGS MAY BE SUBSTITUTED FOR ELECTROFUSION FITTINGS WHERE NEEDED.
- 25. DO NOT SCALE FROM DRAWINGS.

SSUED FOR	SEALED BY:	SEALED ON: 02/02/2021	DESIGNED IN ACCORDANCE WITH TITLE 49-PART 192 OF MINIMUM FEDERAL SAFETY STANDARDS AND GPTC GUIDE FOR GAS TRANSMISSION AND DISTRIBUTION PIPING SYSTEMS. LATEST EDITION.	FIELD VERIF
02/02/2021	BILLEGISTERED	LICENSE EXPIRATION:	ENEngineering	PRIOR TO PIF
	SIGNATURE	06/30/2022	29 BARTLETT STREET MARLBOROUGH, MA 01752 TEL. (630) 353-4000 FAX (630) 535-7777 WWW.ENENGINEERING.COM	

	4	IFC - NO CHAN		02/02/2021	ZS/	AB/EK	
	3	IFC - NO CHAN	IGES TO THIS SHEET		01/14/2021	WS/	/AB/EK
	 2 IFC - REMOVED BOM 1 IFC - NO CHANGES TO THIS SHEET 0 ISSUED FOR CONSTRUCTION 				12/08/2020	ZS/	AB/EK
					10/29/2020	LR/	AB/EK
					10/14/2020	LR/	AB/EK
	NO.	DESCRIPTION			DATE	DW/	/CK/AP
			REVISION STAT	US			
	EVERS URCE ENERGY						
	NELSON STREET MAIN RELAY						
DIMENSIONS	NEW BEDFORD, MASSACHUSETTS						
E FABRICATION	GENERAL NOTES						
	SCALE:NOT TO SCALE				SHEET 2 OF 12		
	DF	RAWN BY / DATE AC 12/11/2020	CHECKED BY / DATE AB 02/02/2021	S	HEET NUMBER		REV. NO.
	APF	PROVED BY / DATE EK 02/02/2021	MA21PIPNEB002R4	MA-2 ⁻	1-PIP-NEB-002-	02	4

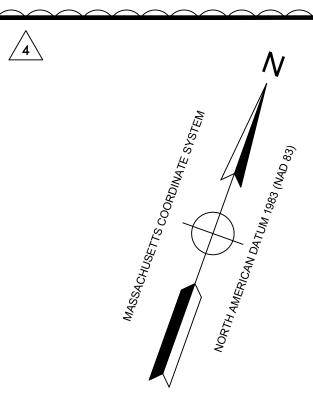

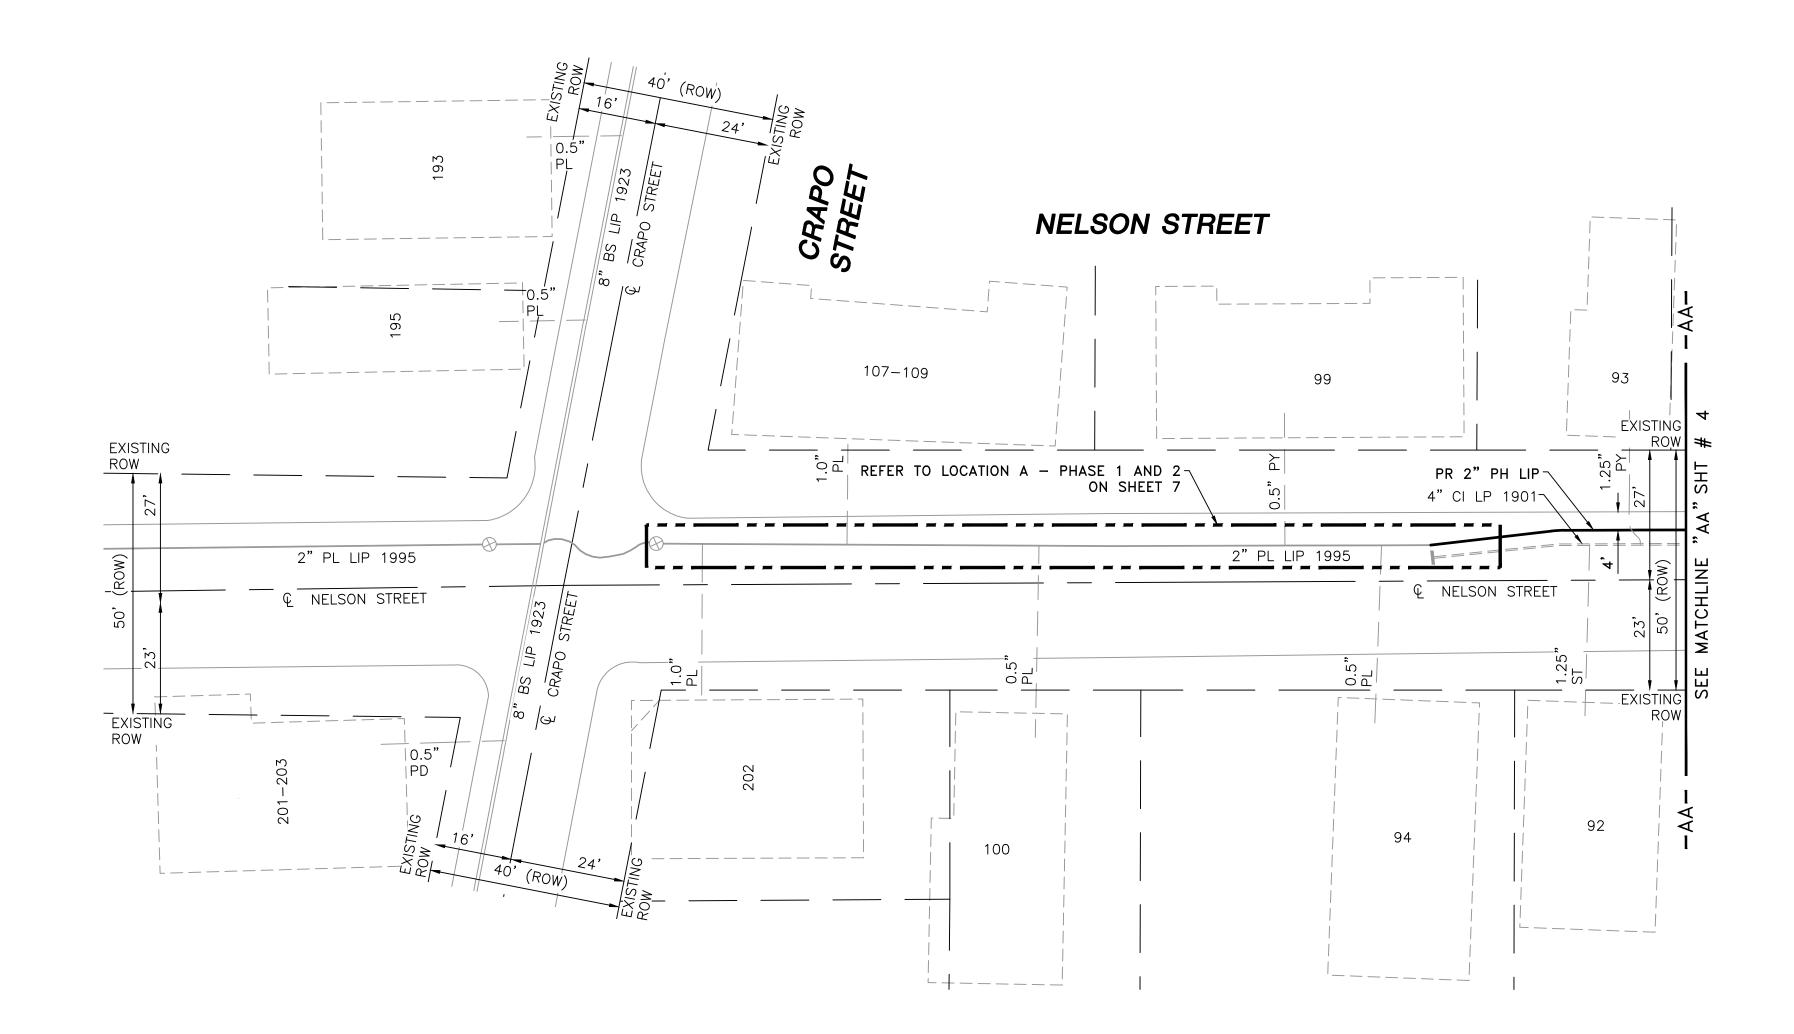

NOTES:


1. REFER TO GENERAL NOTES ON SHEET #2.


2. CONTRACTOR TO POTHOLE EXISTING UTILITIES AT CROSSING LOCATIONS PRIOR TO CONSTRUCTION.


3. HDPE, 4710, SDR 11 ELBOWS TO BE INSTALLED AS REQUIRED TO FACILITATE OFFSETS BASED ON FIELD CONDITIONS.

l: CC

SSUED FOR	SEALED BY:	SEALED ON: 02/02/2021	DESIGNED IN ACCORDANCE WITH TITLE 49-PART 192 OF MINIMUM FEDERAL SAFETY STANDARDS AND GPTC GUIDE FOR GAS TRANSMISSION AND DISTRIBUTION PIPING SYSTEMS. LATEST EDITION.	FIELD VERIFY
02/02/2021	BORSENSIONAL ENGINE	LICENSE EXPIRATION:	EN ©ngineering	PRIOR TO PIPE
02/02/2021	SIGNATURE	06/30/2022	29 BARTLETT STREET MARLBOROUGH, MA 01752 TEL. (630) 353-4000 FAX (630) 535-7777 WWW.ENENGINEERING.COM	

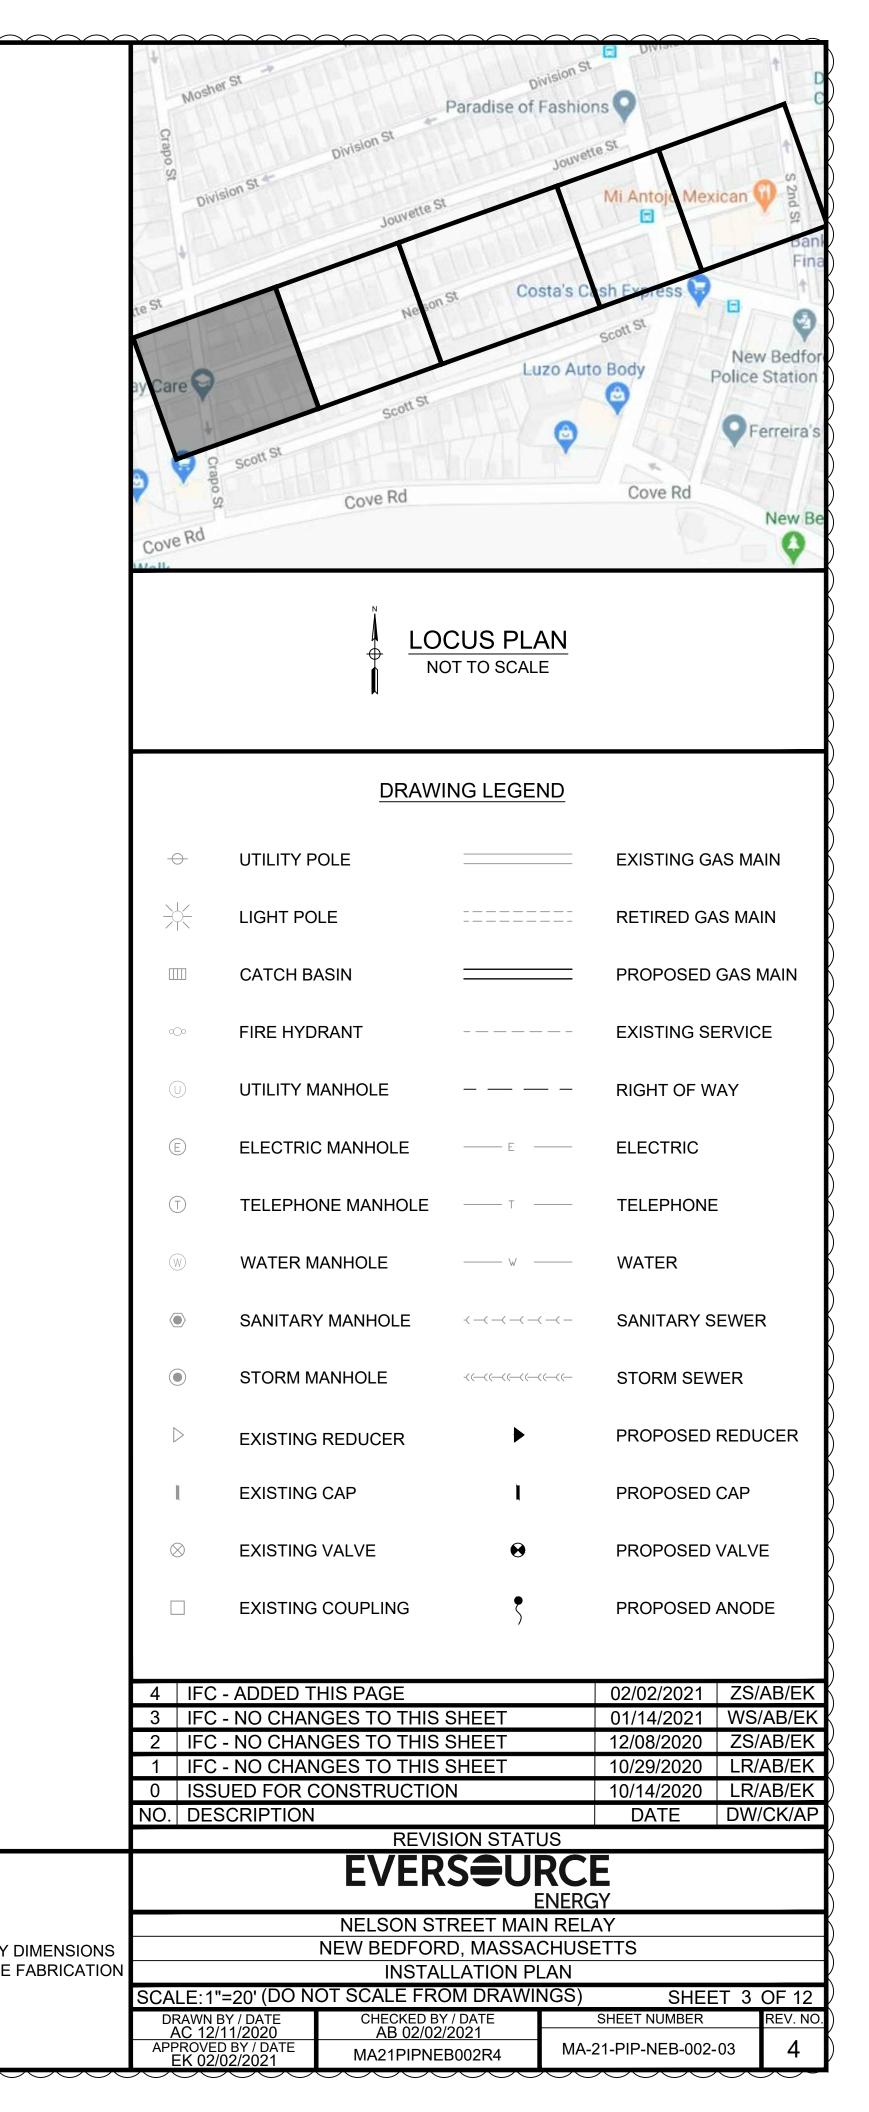

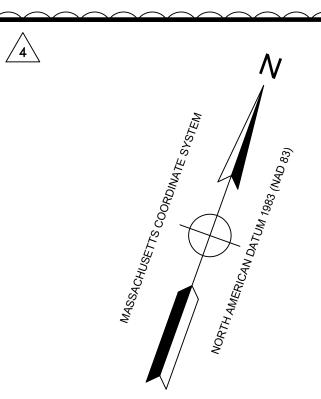

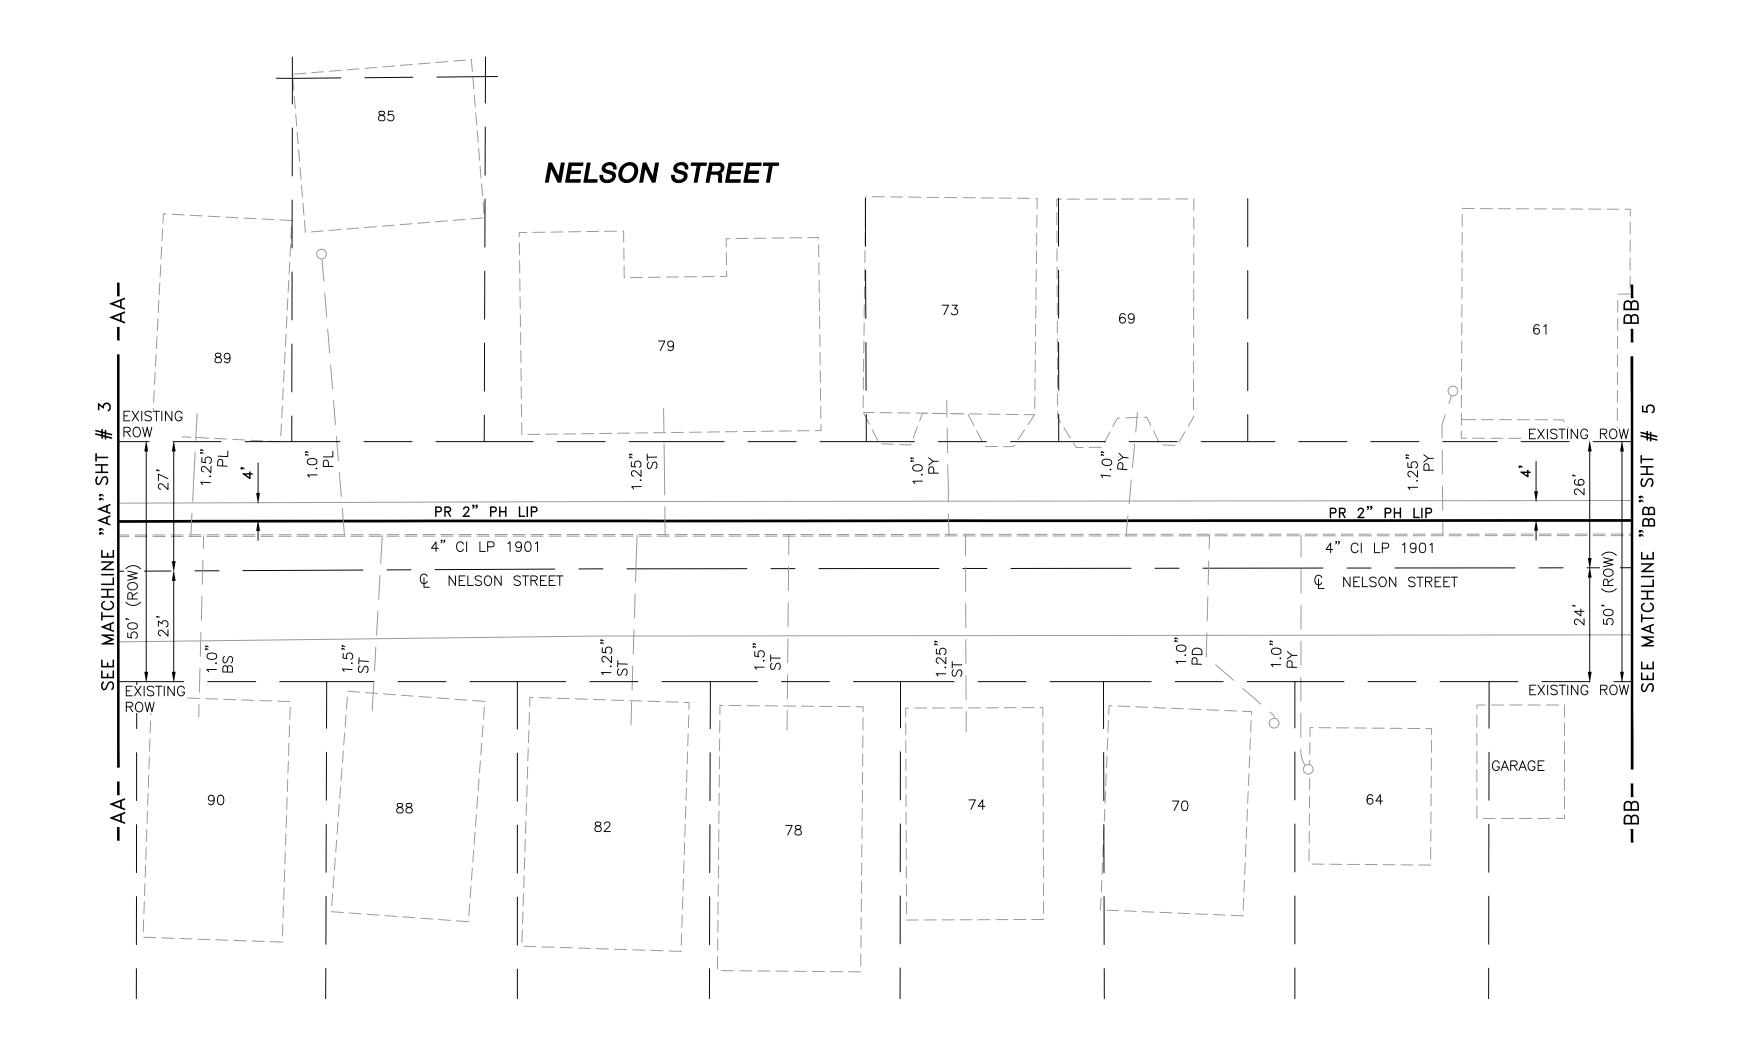

NOT	<u>ES</u> :
1.	REFER TO GENERAL NOTES ON SHEET #2.


2. CONTRACTOR TO POTHOLE EXISTING UTILITIES AT CROSSING LOCATIONS PRIOR TO CONSTRUCTION.


3. HDPE, 4710, SDR 11 ELBOWS TO BE INSTALLED AS REQUIRED TO FACILITATE OFFSETS BASED ON FIELD CONDITIONS.


1				
	LENGTH	SIZE	MATERIAL	DESCRIPTION
	315'	2"	РН	INSTALL
	315'	4"	CI	RETIRE



ISSUED FOR ONSTRUCTION 02/02/2021	WINNERIC VINAI	SEALED ON: 02/02/2021	DESIGNED IN ACCORDANCE WITH TITLE 49-PART 192 OF MINIMUM FEDERAL SAFETY STANDARDS AND GPTC GUIDE FOR GAS TRANSMISSION AND DISTRIBUTION PIPING SYSTEMS. LATEST EDITION.	FIELD VERIFY
	BOLLET	LICENSE EXPIRATION: 06/30/2022	29 BARTLETT STREET MARLBOROUGH, MA 01752 TEL. (630) 353-4000 FAX (630) 535-777 WWW.ENENGINEERING.COM	PRIOR TO PIPE
	SIGNATURE		WWW.ENENGINEERING.COM	

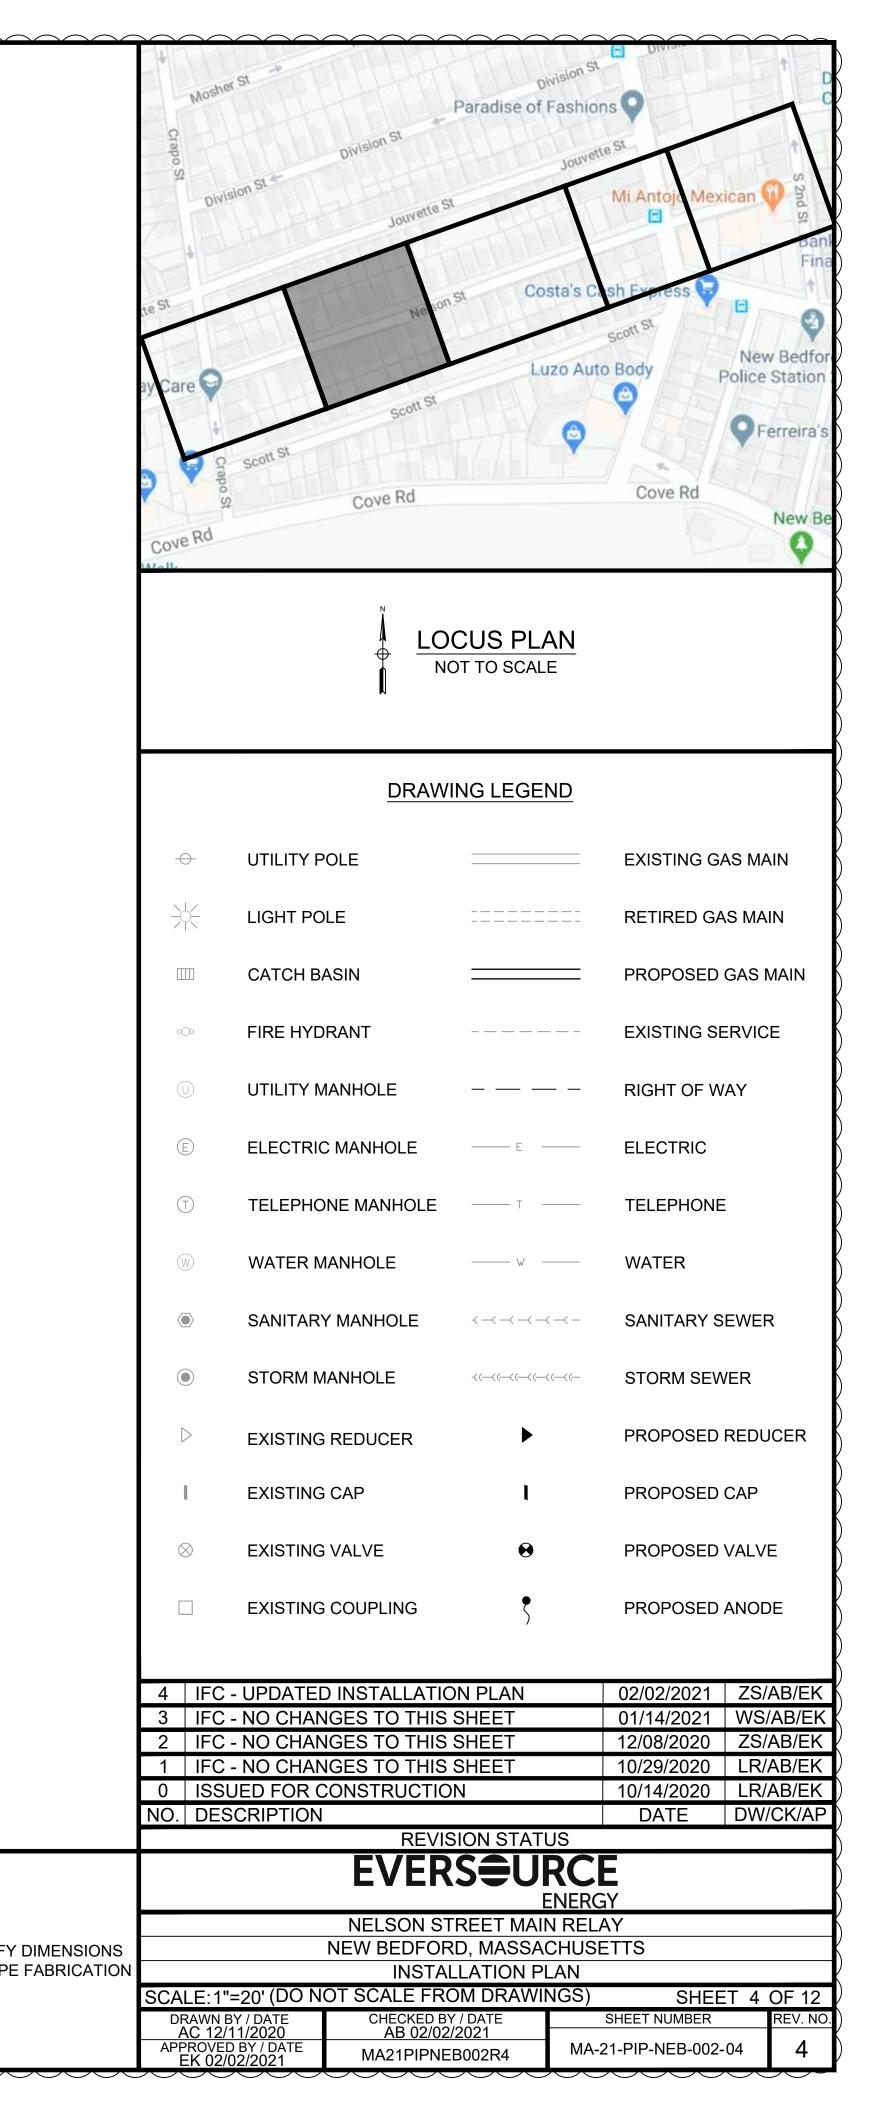

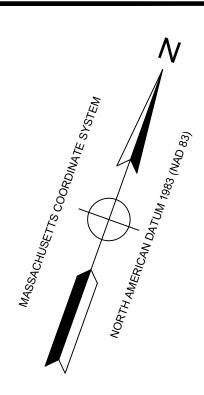

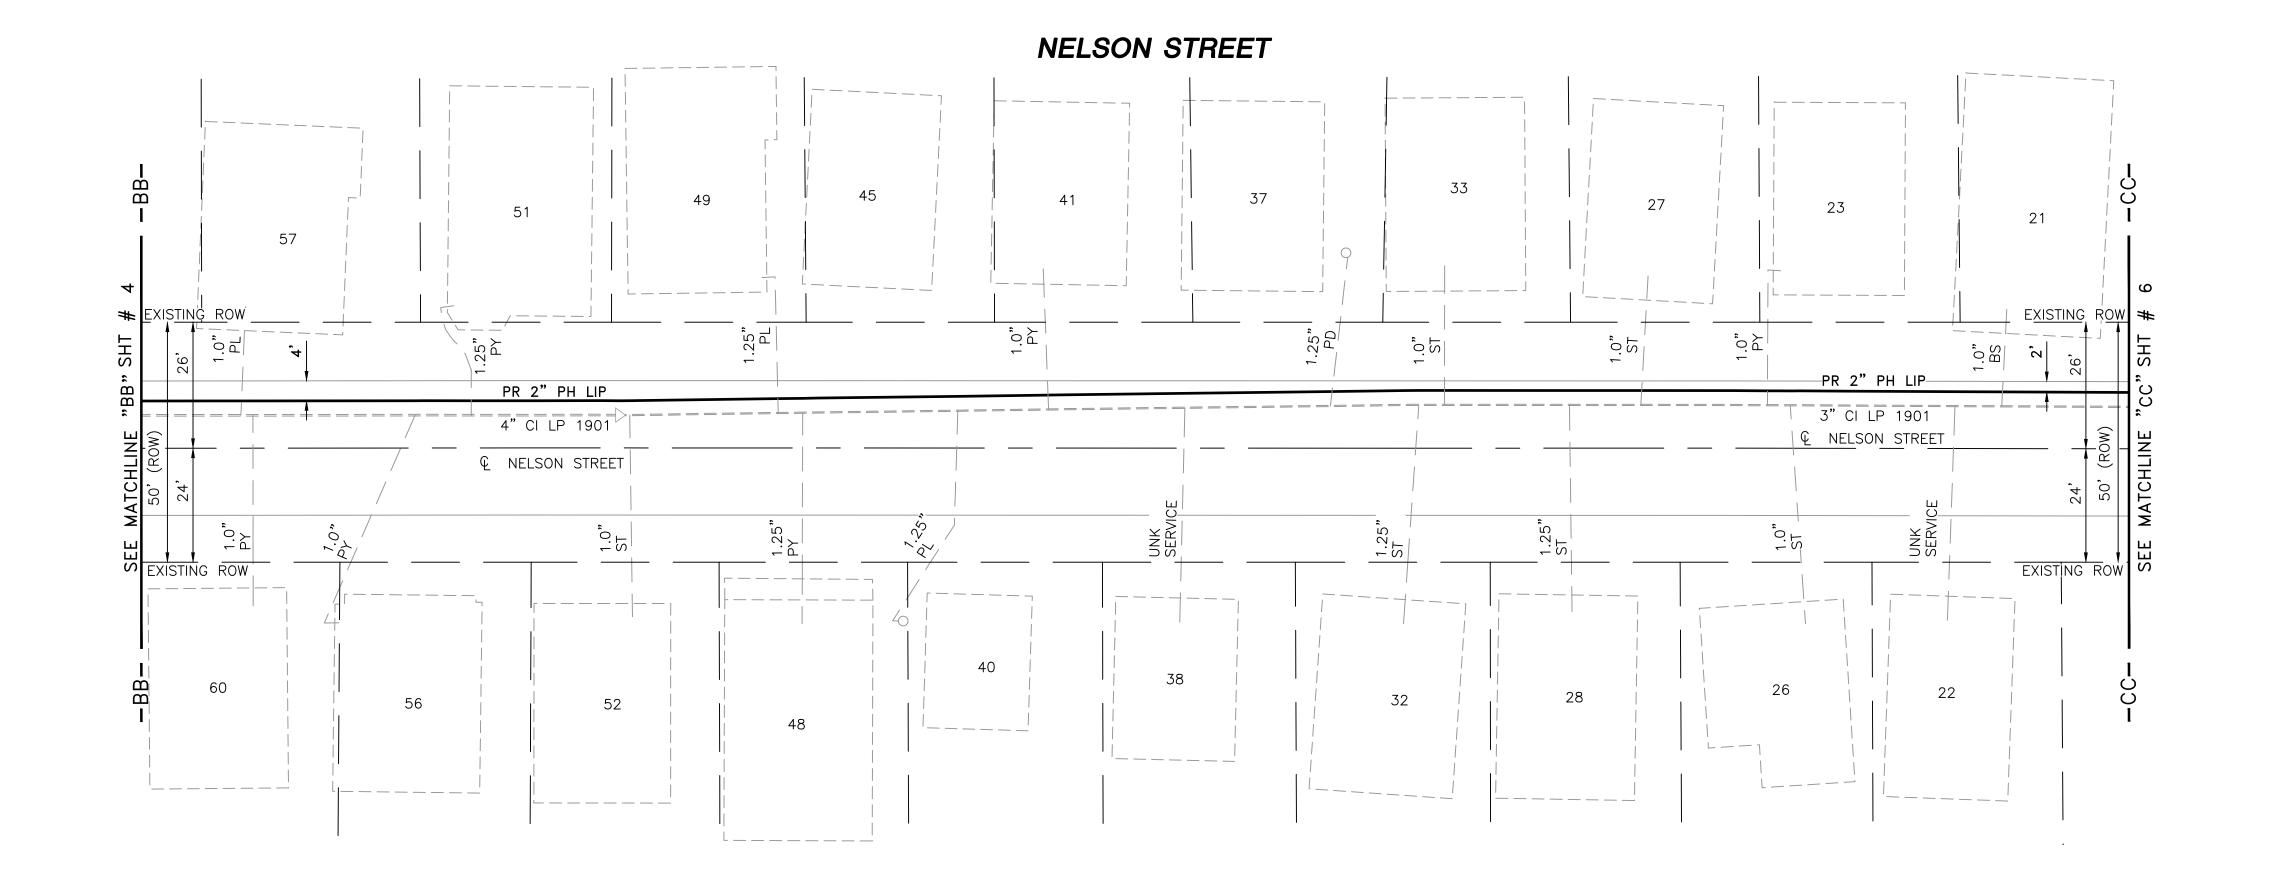

NOTES:

1. REFER TO GENERAL NOTES ON SHEET #2.

2. CONTRACTOR TO POTHOLE EXISTING UTILITIES AT CROSSING LOCATIONS PRIOR TO CONSTRUCTION.


3. HDPE, 4710, SDR 11 ELBOWS TO BE INSTALLED AS REQUIRED


TO FACILITATE OFFSETS BASED ON FIELD CONDITIONS.


	\sim	\sim	\sim
LENGTH	SIZE	MATERIAL	
415'	2"	РН	INSTALL
310'	3"	CI	RETIRE
100'	4"	CI	RETIRE

CC

ISSUED FOR CONSTRUCTION	SEALED BY:	SEALED ON: 02/02/2021	DESIGNED IN ACCORDANCE WITH TITLE 49-PART 192 OF MINIMUM FEDERAL SAFETY STANDARDS AND GPTC GUIDE FOR GAS TRANSMISSION AND DISTRIBUTION PIPING SYSTEMS. LATEST EDITION.	FIELD VERIFY
02/02/2021	BOLESSIONAL ENGINE	LICENSE EXPIRATION:	ENERGINEERING 29 BARTLETT STREET	PRIOR TO PIPE
	SIGNATURE	06/30/2022	MARLBOROUGH, MA 01752 TEL. (630) 353-4000 FAX (630) 535-7777 WWW.ENENGINEERING.COM	

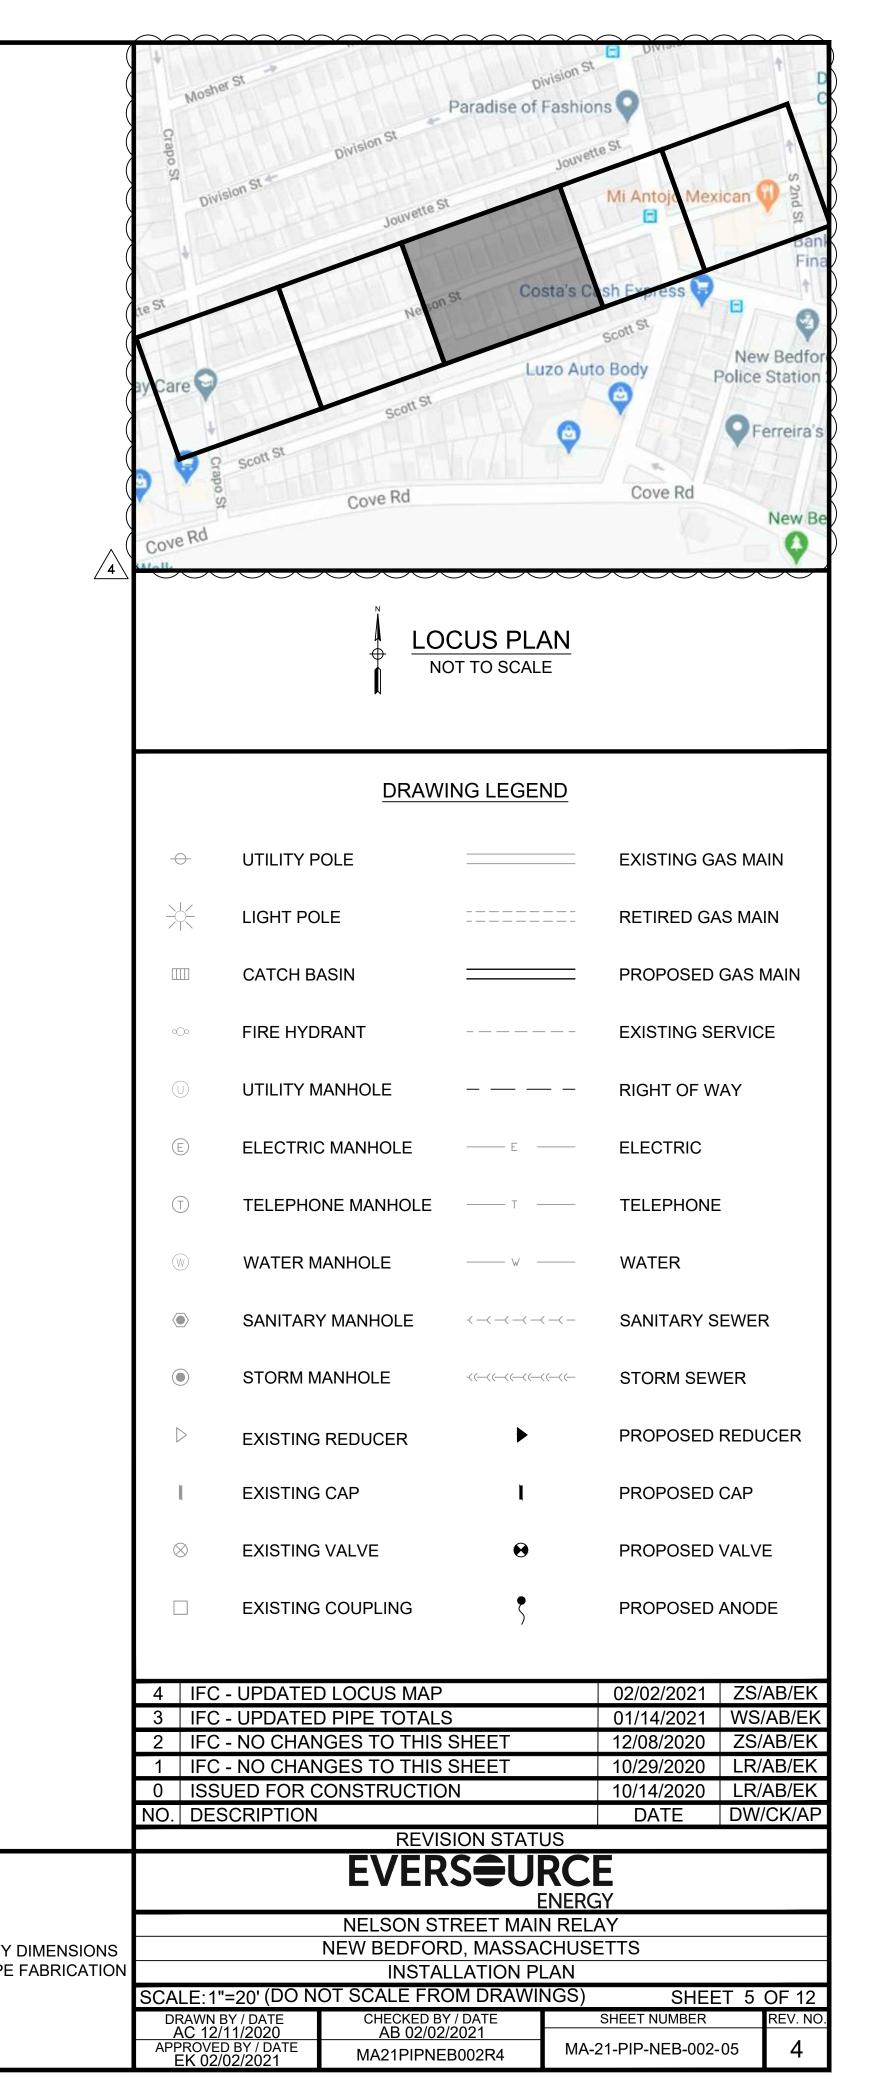

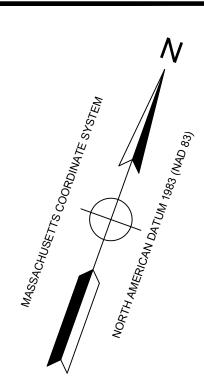

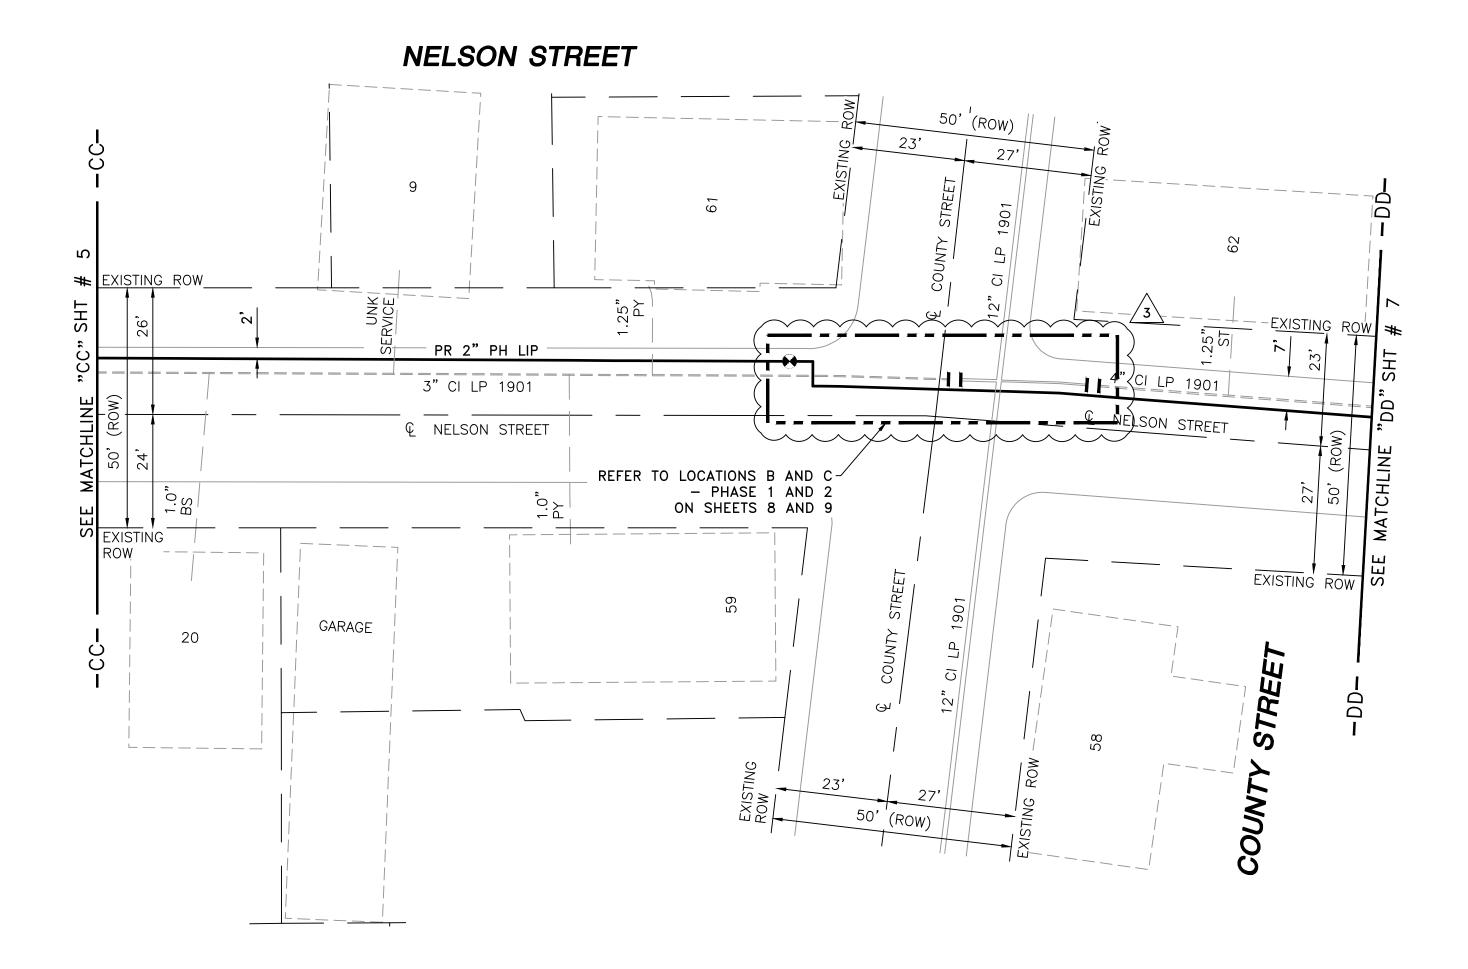

NOTES


1. REFER TO GENERAL NOTES ON SHEET #2.


2. CONTRACTOR TO POTHOLE EXISTING UTILITIES AT CROSSING


LOCATIONS PRIOR TO CONSTRUCTION. 3. HDPE, 4710, SDR 11 ELBOWS TO BE INSTALLED AS REQUIRED


TO FACILITATE OFFSETS BASED ON FIELD CONDITIONS.

LENGTH	SIZE	MATERIAL	DESCRIPTION
270'	2"	РН	INSTALL
150'	3"	CI	RETIRE
60'	4"	CI	RETIRE
25'	6"	CI	RETIRE

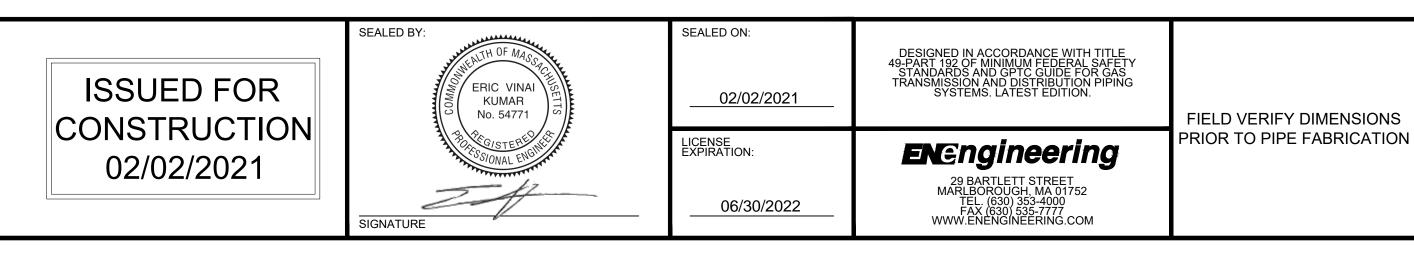

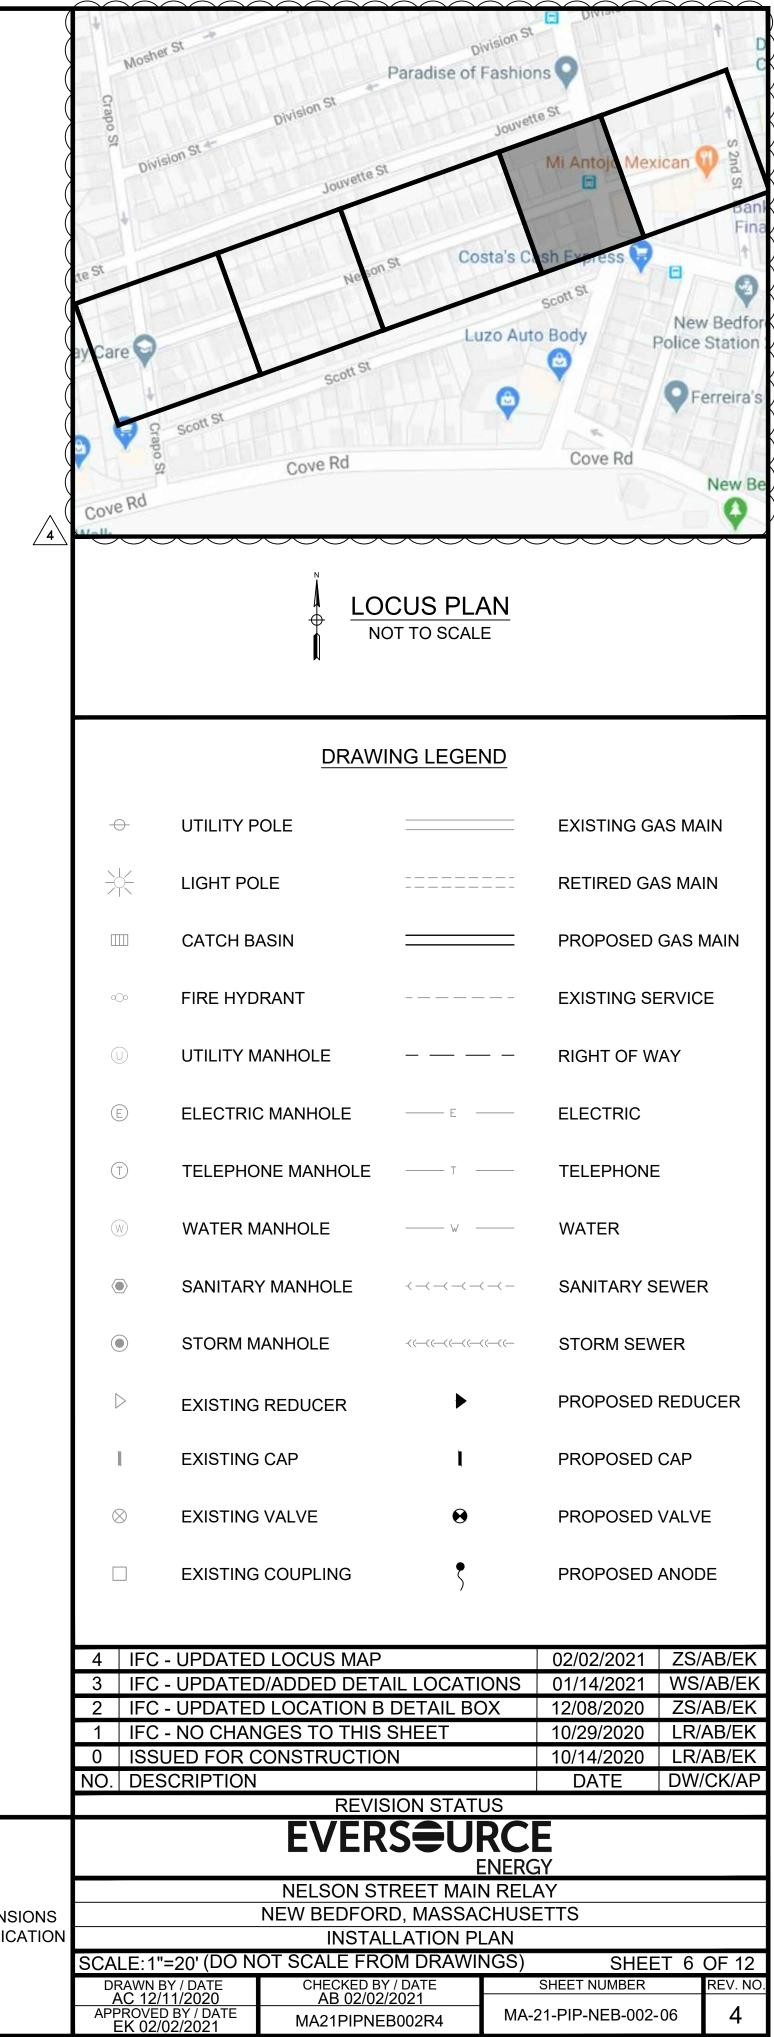

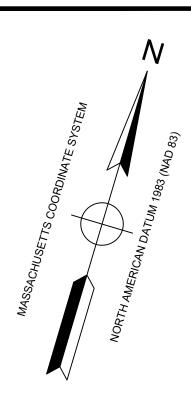

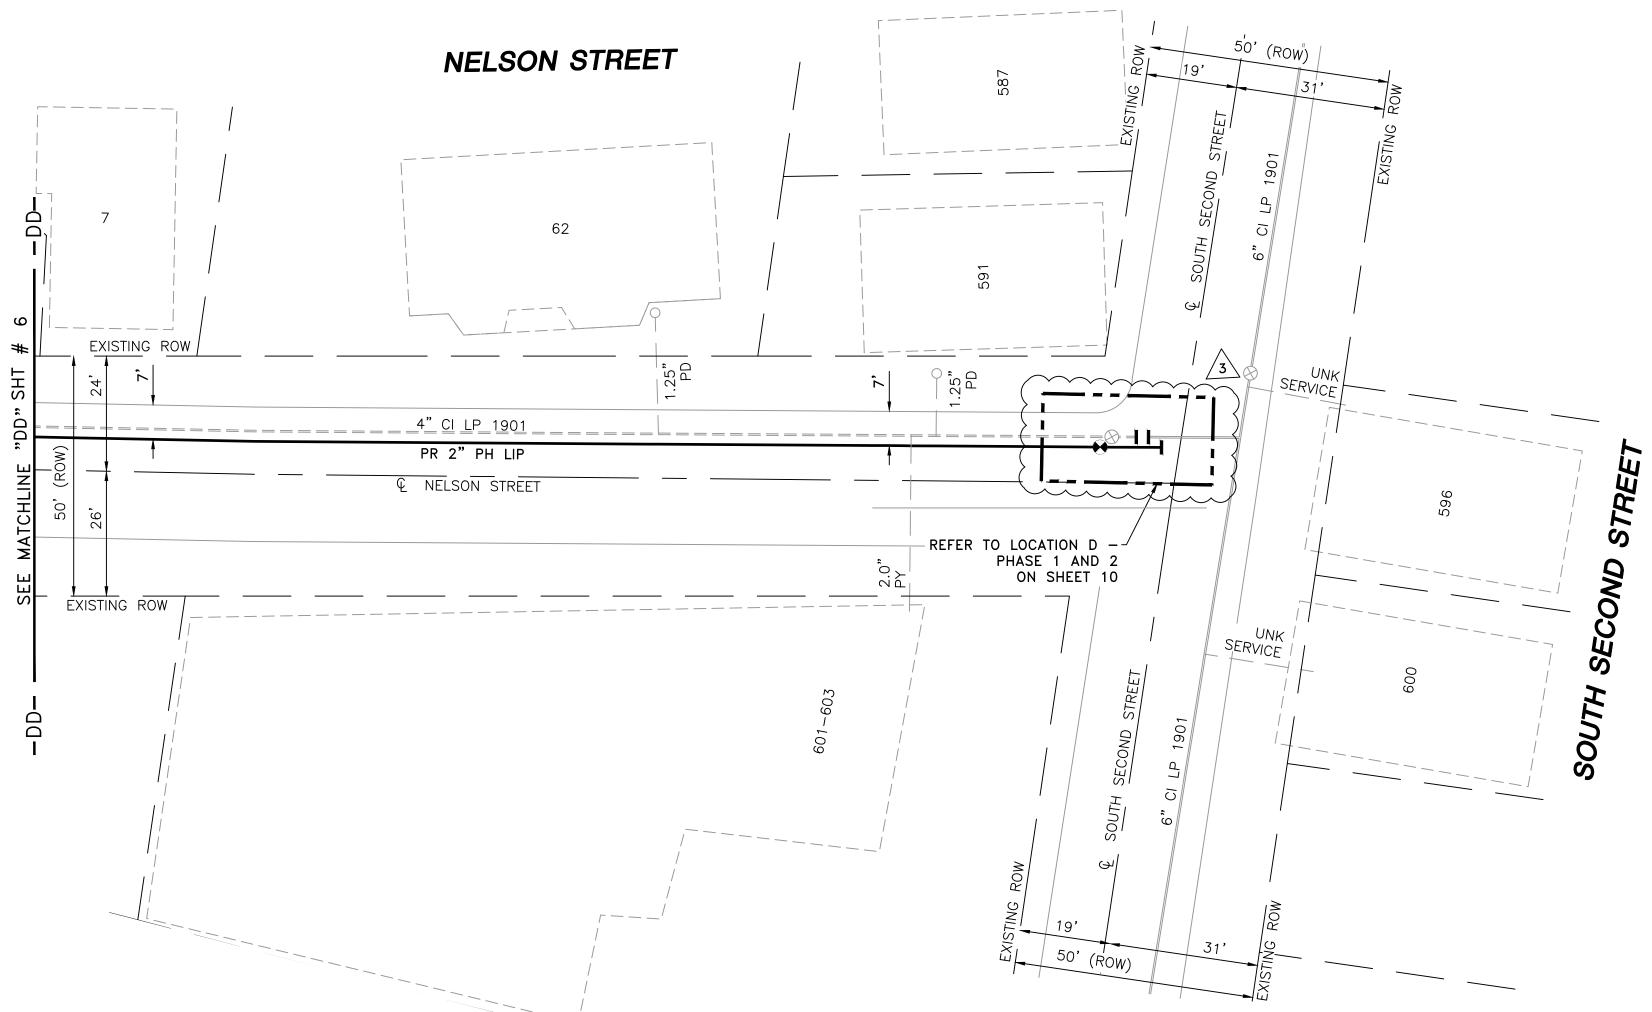

NOTES:

1. REFER TO GENERAL NOTES ON SHEET #2.

2. CONTRACTOR TO POTHOLE EXISTING UTILITIES AT CROSSING LOCATIONS PRIOR TO CONSTRUCTION.


3. HDPE, 4710, SDR 11 ELBOWS TO BE INSTALLED AS REQUIRED


TO FACILITATE OFFSETS BASED ON FIELD CONDITIONS.

LENGTH	SIZE	MATERIAL	DESCRIPTION
235'	2"	РН	INSTALL
230'	4"	CI	RETIRE



	SEALED BY:	SEALED ON:	DESIGNED IN ACCORDANCE WITH TITLE 49-PART 192 OF MINIMUM FEDERAL SAFETY STANDARDS AND GPTC GUIDE FOR GAS	
SSUED FOR	ERIC VINAL KUMAR No. 54771	02/02/2021	TRANSMISSION AND DISTRIBUTION PIPING SYSTEMS. LATEST EDITION.	FIELD VERIFY
02/02/2021	BICKEGISTERED	LICENSE EXPIRATION:	EN Engineering	PRIOR TO PIPE
02/02/2021	SIGNATURE	06/30/2022	29 BARTLETT STREET MARLBOROUGH, MA 01752 TEL. (630) 353-4000 FAX (630) 535-7777 WWW.ENENGINEERING.COM	

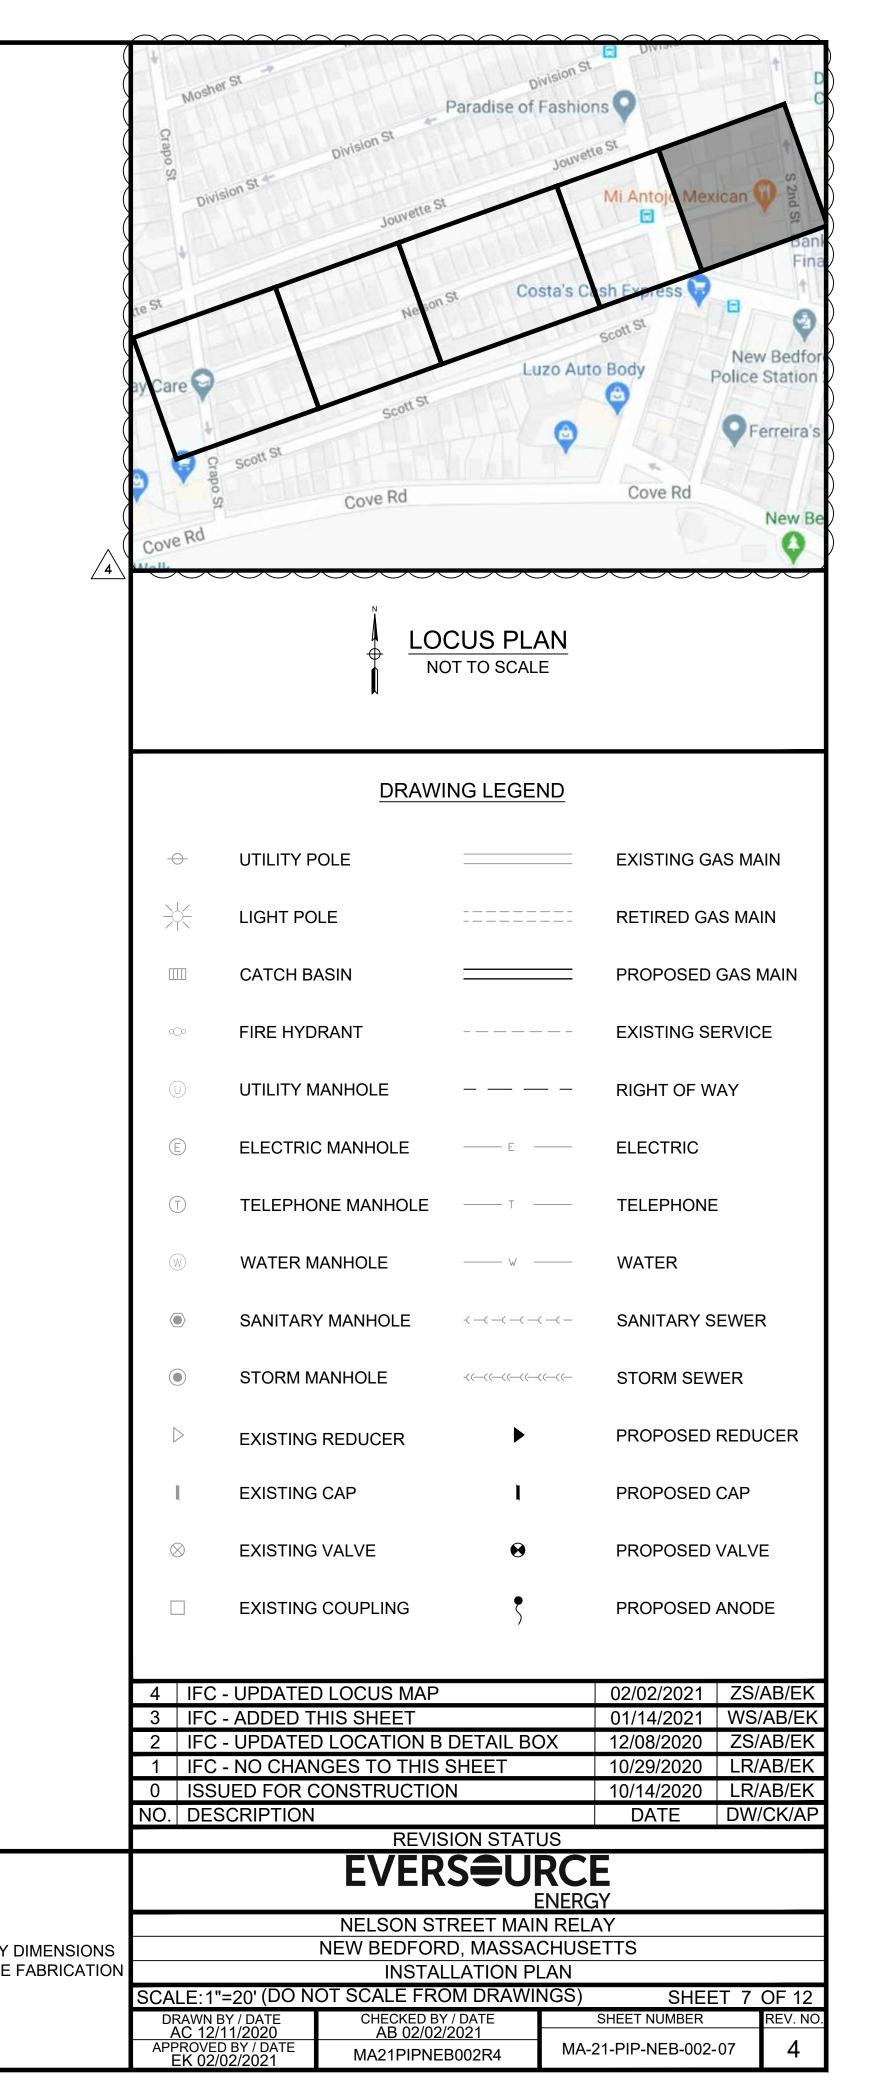


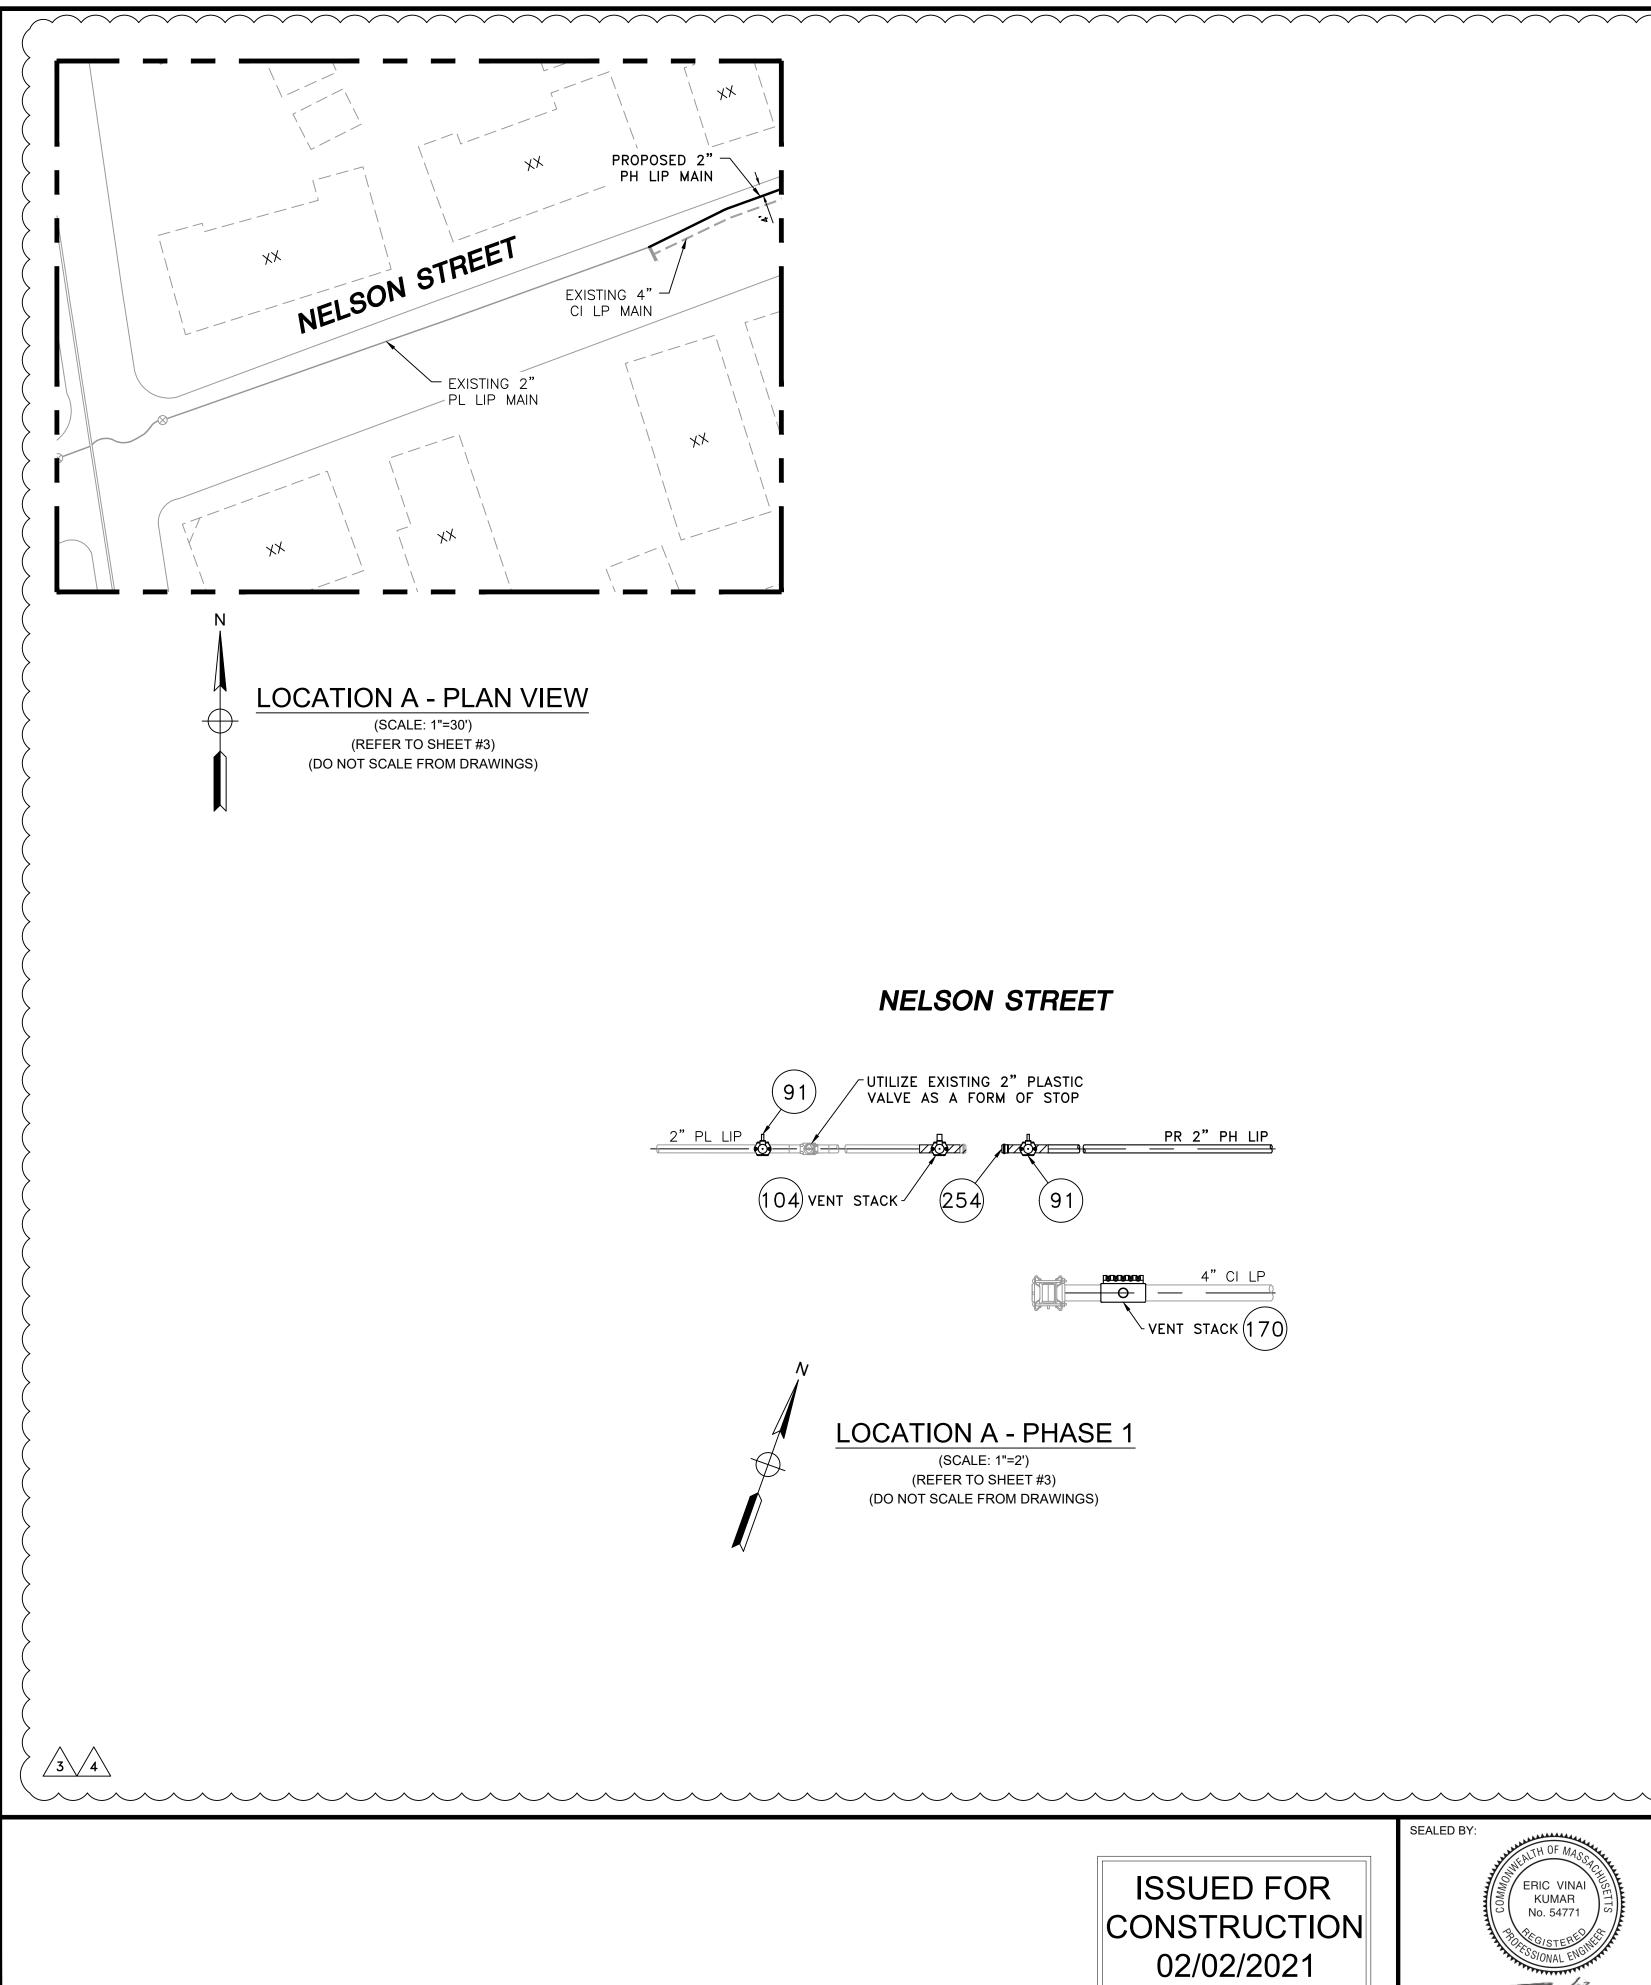

NOTE: 1. REFER TO GENERAL NOTES ON SHEET #2.

				NELSON STREET MAIN RELAY - LOCATION A - SCHEDULE OF MATERIALS	
ITEM	QTY	SIZE	MAXIMO NO.	DESCRIPTION	MATERIAL
91	3	2" X 1/2"	500866	TAPPING TEE, ELECTROFUSION, IPS X CTS, HDPE 3408/4710, SDR 11, ASTM D2513, ASTM D3350, ASTM D3261 ASTM F1055. CENTRAL PLASTICS OR APPROVED EQUAL.	ASTM D2513
104	1	2" X 1"	560779	TAPPING TEE, ELECTROFUSION, IPS X IPS, HDPE 3408/4710, SDR 11, ASTM D2513, ASTM D3350, ASTM D3261, ASTM F1055. CENTRAL PLASTICS OR APPROVED EQUAL.	ASTM D2513
170	1	4" x 2"	543028	BAND CLAMP, WITH WELDED 2" FNPT SERVICE OUTLET, 304L SS SINGLE SECTION BAND AND GAP BRIDGES, SS STUDS WITH TEFLON COATED HEX NUTS, COMPLETELY LINED WITH NITRILE RUBBER GASKET. MUELLER 540 SERVI-SEAL OR APPROVED EQUAL. COMPLETE WITH PLUG.	
254	AS REQUIRED	2"	581633	END CAP MECHANICAL COMPRESSION, SDR 11 IPS, DUPONT ZYTEL ST-801 NYLON BODY, 316 SS COMRESSION RING, INTERNAL STIFFENER, ASTM D-2513, ASTM F1924. METFIT OR APPROVED EQUAL.	ASTM D2513
255	AS REQUIRED	2"	579840	COUPLING, MECHANICAL COMPRESSION, SDR 11 IPS, DUPONT ZYTEL ST-801 NYLON BODY, 316 SS COMRESSION RING, INTERNAL STIFFENER, ASTM D-2513, ASTM F1924. METFIT OR APPROVED EQUAL.	ASTM D2513
263	15'	2"	554025	PIPE, IPS, HDPE 3408/4710 SDR 11, ASTM D2513, ASTM D3350, PERFORMANCE PIPE OR APPROVED EQUAL	ASTM D2513
270	AS REQUIRED	1/2"	542609	END CAP, MECHANICAL STAB, CTS, HDPE, PE 4710/3408, ASTM D2513, WITH SS GRIPPING SUPPORT RING, ACETAL COLLET AND SPACER RETAINER RING, PE THRUST WASHER, BUNA-N O-RING, ZINC-PLATED CS INSERT STIFFENER, PERFECTION WITH END CAP OR APPROVED EQUAL.	ASTM D2513

NELSON STREET

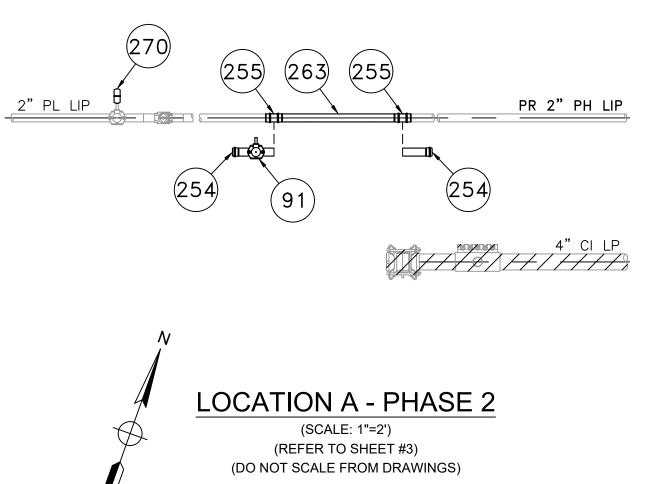


SEALED BY: SEALED ON: DESIGNED IN ACCORDANCE WITH TITLE 49-PART 192 OF MINIMUM FEDERAL SAFETY STANDARDS AND GPTC GUIDE FOR GAS TRANSMISSION AND DISTRIBUTION PIPING SYSTEMS. LATEST EDITION. TH OF A **ISSUED FOR** ERIC VINAI 02/02/2021 KUMAR No. 54771 FIELD VERIFY CONSTRUCTION PRIOR TO PIPE LICENSE EXPIRATION: **EN**Engineering 02/02/2021 29 BARTLETT STREET MARLBOROUGH, MA 01752 TEL. (630) 353-4000 FAX (630) 535-7777 WWW.ENENGINEERING.COM 1 06/30/2022 SIGNATURE

4" CI LP

PR 2" PH LIP

		~~~~~~~~~~~~~~~~~~~~~~~~~~~~~~~~~~~~~~~	~~~~~	$\sim$					
	4 IFC - UPDATE	D DETAIL, SITE PLAN AND	D BOM 02/02/2021	ZS/AB/EK					
	3 IFC - UPDATE	01/14/2021	WS/AB/EK						
$\mathbf{x}$	2 IFC - NO CHAN	12/08/2020	ZS/AB/EK						
$\langle$	1 IFC - NO CHAN	10/29/2020	LR/AB/EK						
$\langle$	0 ISSUED FOR C	10/14/2020	LR/AB/EK						
	NO. DESCRIPTION		DATE	DW/CK/AP					
		REVISION STAT	US						
	EVERS <del>©</del> URCE								
	ENERGY								
	NELSON STREET MAIN RELAY								
/ DIMENSIONS	NEW BEDFORD, MASSACHUSETTS								
E FABRICATION	LOCATION A - PHASE 1, 2 AND SCHEDULE OF MATERIALS								
	SCALE: AS NOTED	SHEE	T 8 OF 12						
	DRAWN BY / DATE AC 12/11/2020	CHECKED BY / DATE AB 02/02/2021	SHEET NUMBER	REV. NO.					
	APPROVED BY / DATE EK 02/02/2021	MA21PIPNEB002R4	MA-21-PIP-NEB-002-	08 4					

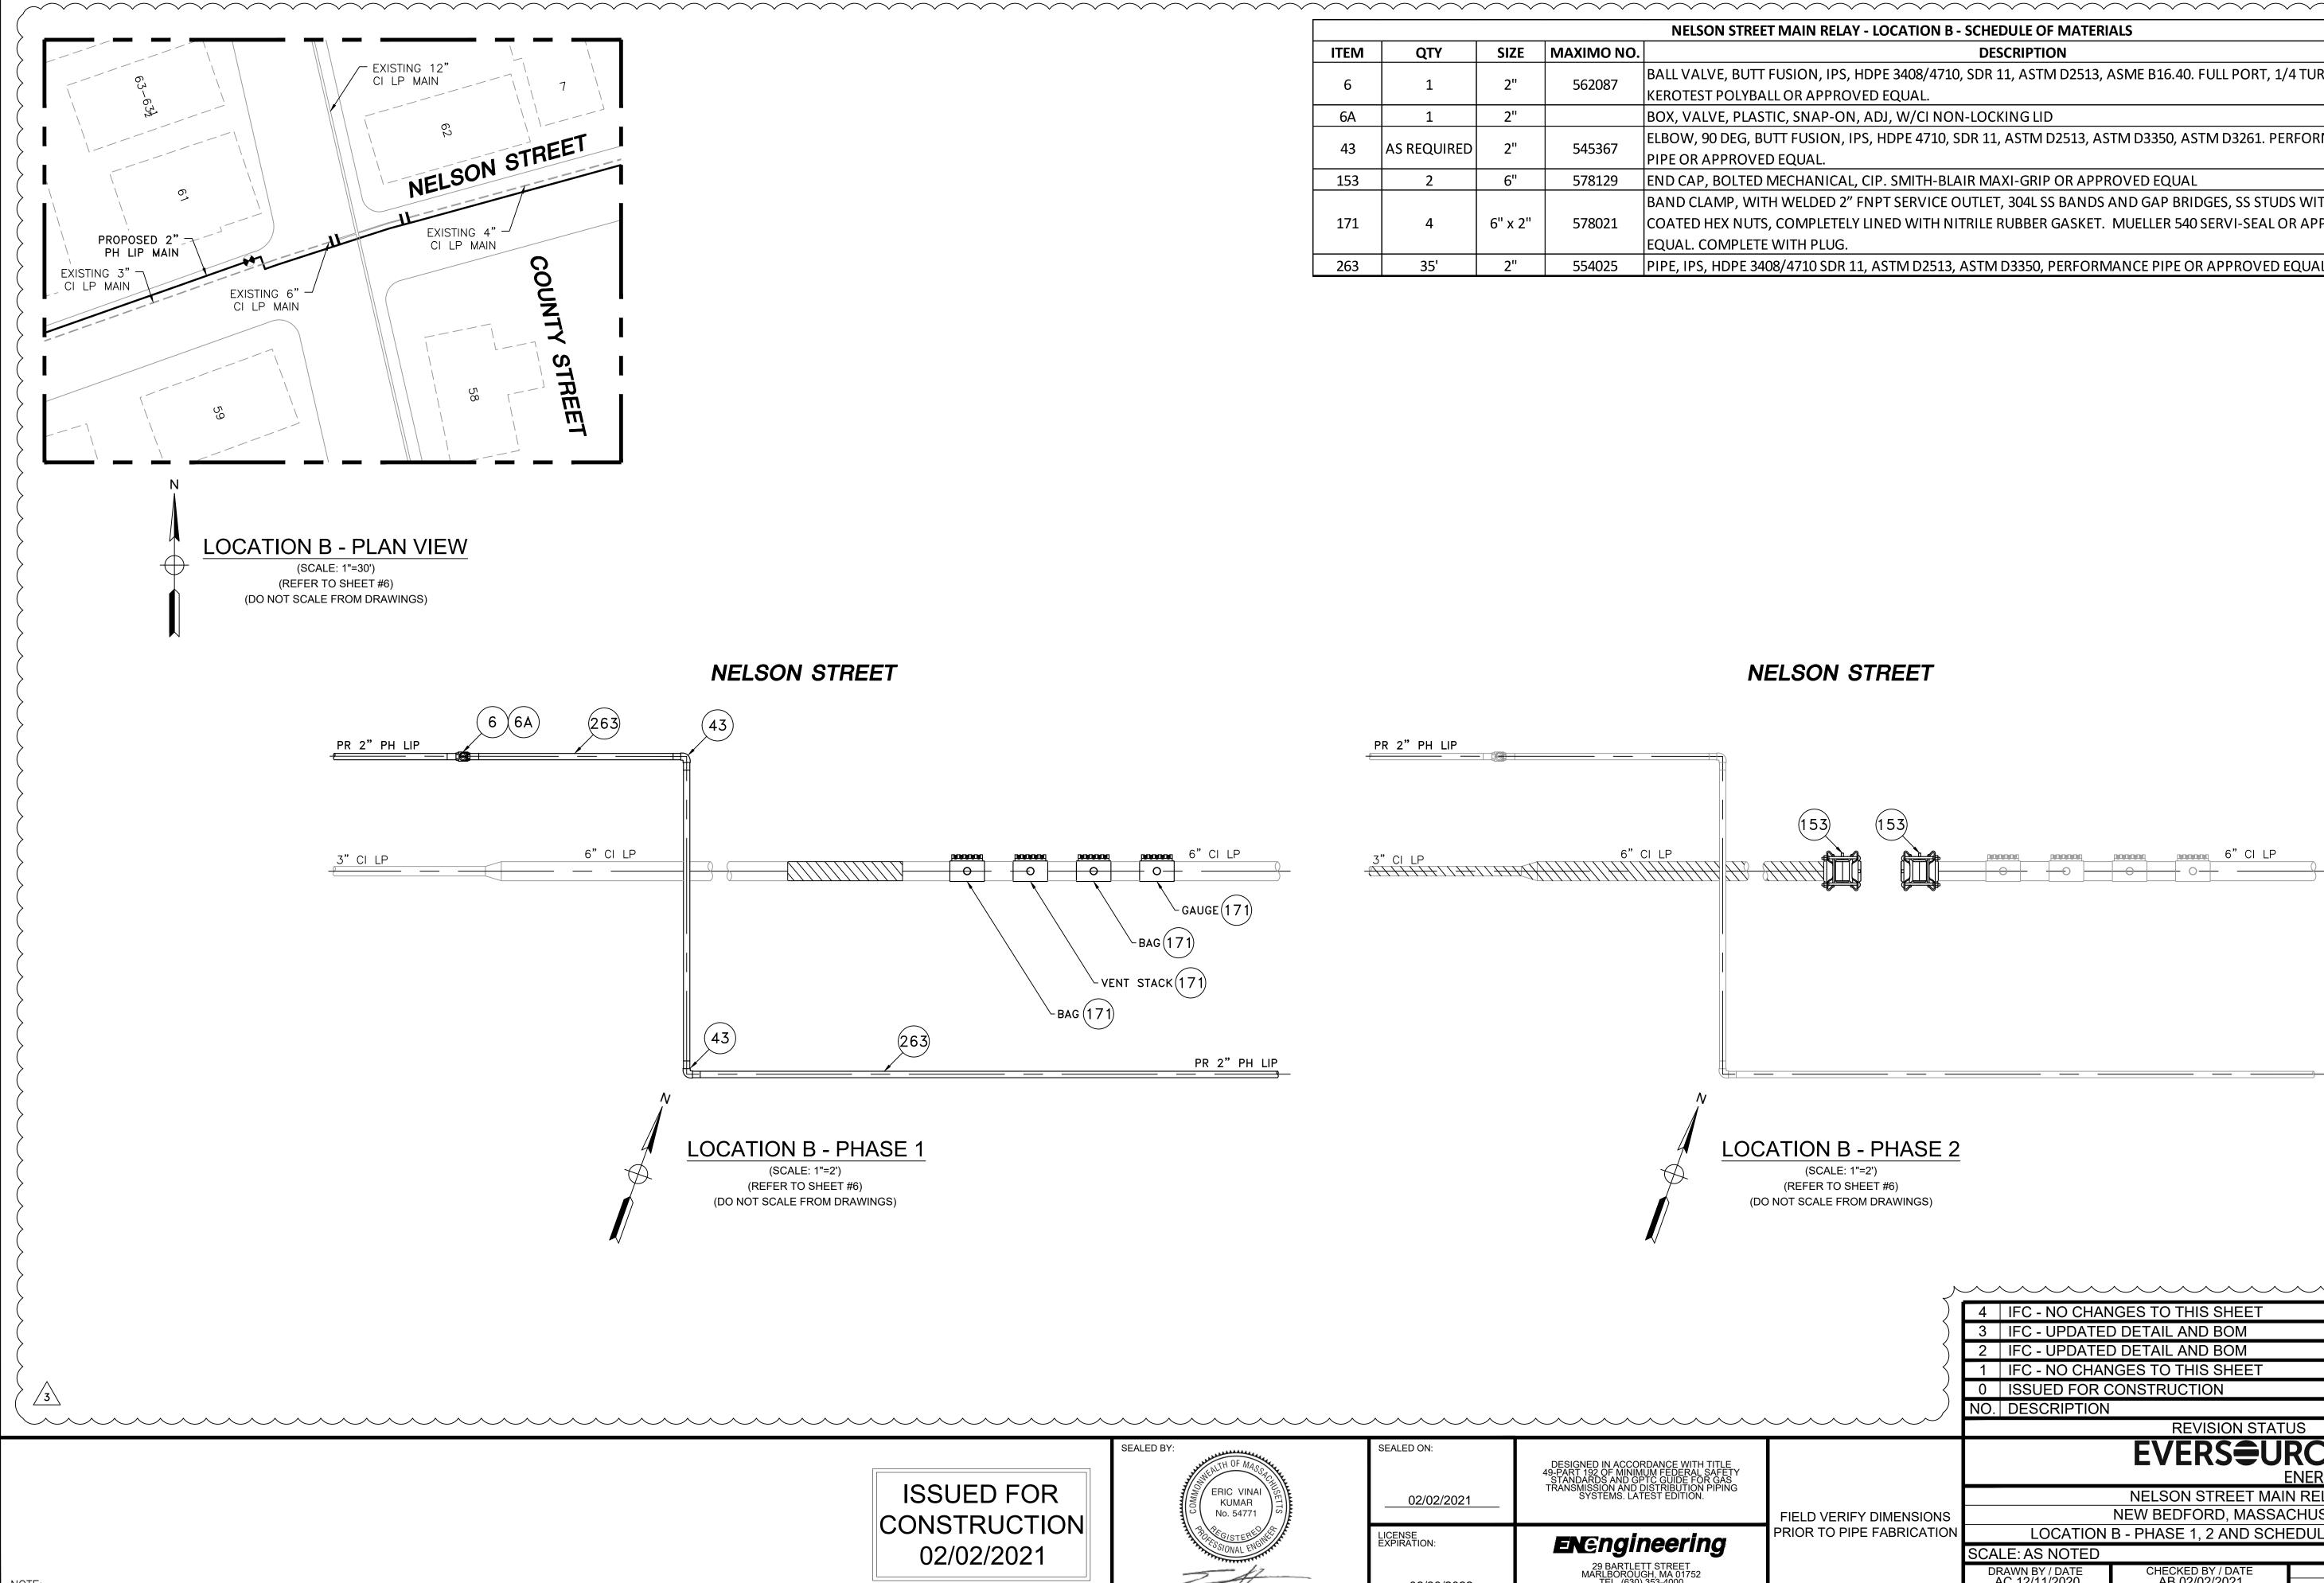


				<b>NELSON STREET MAIN RELAY -</b>
ITEM	QTY	SIZE	MAXIMO NO.	
6	1	2"	562087	BALL VALVE, BUTT FUSION, IPS, HD
0	L L	Z	502087	KEROTEST POLYBALL OR APPROVE
6A	1	2"		BOX, VALVE, PLASTIC, SNAP-ON, A
40		2"		ELBOW, 90 DEG, BUTT FUSION, IPS,
43	AS REQUIRED	Z	545367	PIPE OR APPROVED EQUAL.
153	2	6"	578129	END CAP, BOLTED MECHANICAL, C
				BAND CLAMP, WITH WELDED 2" FN
171	4	6" x 2"	578021	COATED HEX NUTS, COMPLETELY LI
				EQUAL. COMPLETE WITH PLUG.
263	35'	2"	554025	PIPE, IPS, HDPE 3408/4710 SDR 11,



					~~~~~~~~~~~~~~~~~~~~~~~~~~~~~~~~~~~~~~~	~~~~~~	$\sim$
					4 IFC - NO CHANGES TO THIS SHEET	02/02/2021 ZS/	/AB/EK
					3 IFC - UPDATED DETAIL AND BOM	01/14/2021 WS/	/AB/EK
				$\langle \rangle$	2 IFC - UPDATED DETAIL AND BOM	12/08/2020 ZS/	/AB/EK
				\leq	1 IFC - NO CHANGES TO THIS SHEET	10/29/2020 LR/	/AB/EK
				\langle	0 ISSUED FOR CONSTRUCTION	10/14/2020 LR/	/AB/EK
					NO. DESCRIPTION	DATE DW/	/CK/AP
					REVISION STAT	US	
	SEALED BY:	SEALED ON:	DESIGNED IN ACCORDANCE WITH TITLE 49-PART 192 OF MINIMUM FEDERAL SAFETY STANDARDS AND GPTC GUIDE FOR GAS TRANSMISSION AND DISTRIBUTION PIPING SYSTEMS. LATEST EDITION.		EVERS € U	RCE	
ISSUED FOR		02/02/2021	TRANSMISSION AND DISTRIBUTION PIPING SYSTEMS. LATEST EDITION.		NELSON STREET MA		
	8 No. 54771			FIELD VERIFY DIMENSIONS	NEW BEDFORD, MASSA	CHUSETTS	
ONSTRUCTION	A BACKSTERE WE	LICENSE EXPIRATION:	ENEnginooring	PRIOR TO PIPE FABRICATION	LOCATION B - PHASE 1, 2 AND SCH	EDULE OF MATERIALS	
02/02/2021	SSIONAL ENDING	EAFIRATION:	EN ©ngineering		SCALE: AS NOTED	SHEET 9	OF 12
	242-		29 BARTLETT STREET MARLBOROUGH, MA 01752 TEL, (630) 353-4000		DRAWN BY / DATE CHECKED BY / DATE AC 12/11/2020 AB 02/02/2021	SHEET NUMBER	REV. NO.
	SIGNATURE	06/30/2022	FAX (630) 535-7777 WWW.ENENGINEERING.COM		APPROVED BY / DATE EK 02/02/2021 MA21PIPNEB002R4	MA-21-PIP-NEB-002-09	4


	~ ~ ~ ~
LOCATION B - SCHEDULE OF MATERIALS	
DESCRIPTION	MATERIAL
DPE 3408/4710, SDR 11, ASTM D2513, ASME B16.40. FULL PORT, 1/4 TURN, D EQUAL.	ASTM D2513
ADJ, W/CI NON-LOCKING LID	PLASTIC
, HDPE 4710, SDR 11, ASTM D2513, ASTM D3350, ASTM D3261. PERFORMANCE	ASTM D2513
CIP. SMITH-BLAIR MAXI-GRIP OR APPROVED EQUAL	
NPT SERVICE OUTLET, 304L SS BANDS AND GAP BRIDGES, SS STUDS WITH TEFLON INED WITH NITRILE RUBBER GASKET. MUELLER 540 SERVI-SEAL OR APPROVED	
ASTM D2513, ASTM D3350, PERFORMANCE PIPE OR APPROVED EQUAL	ASTM D2513

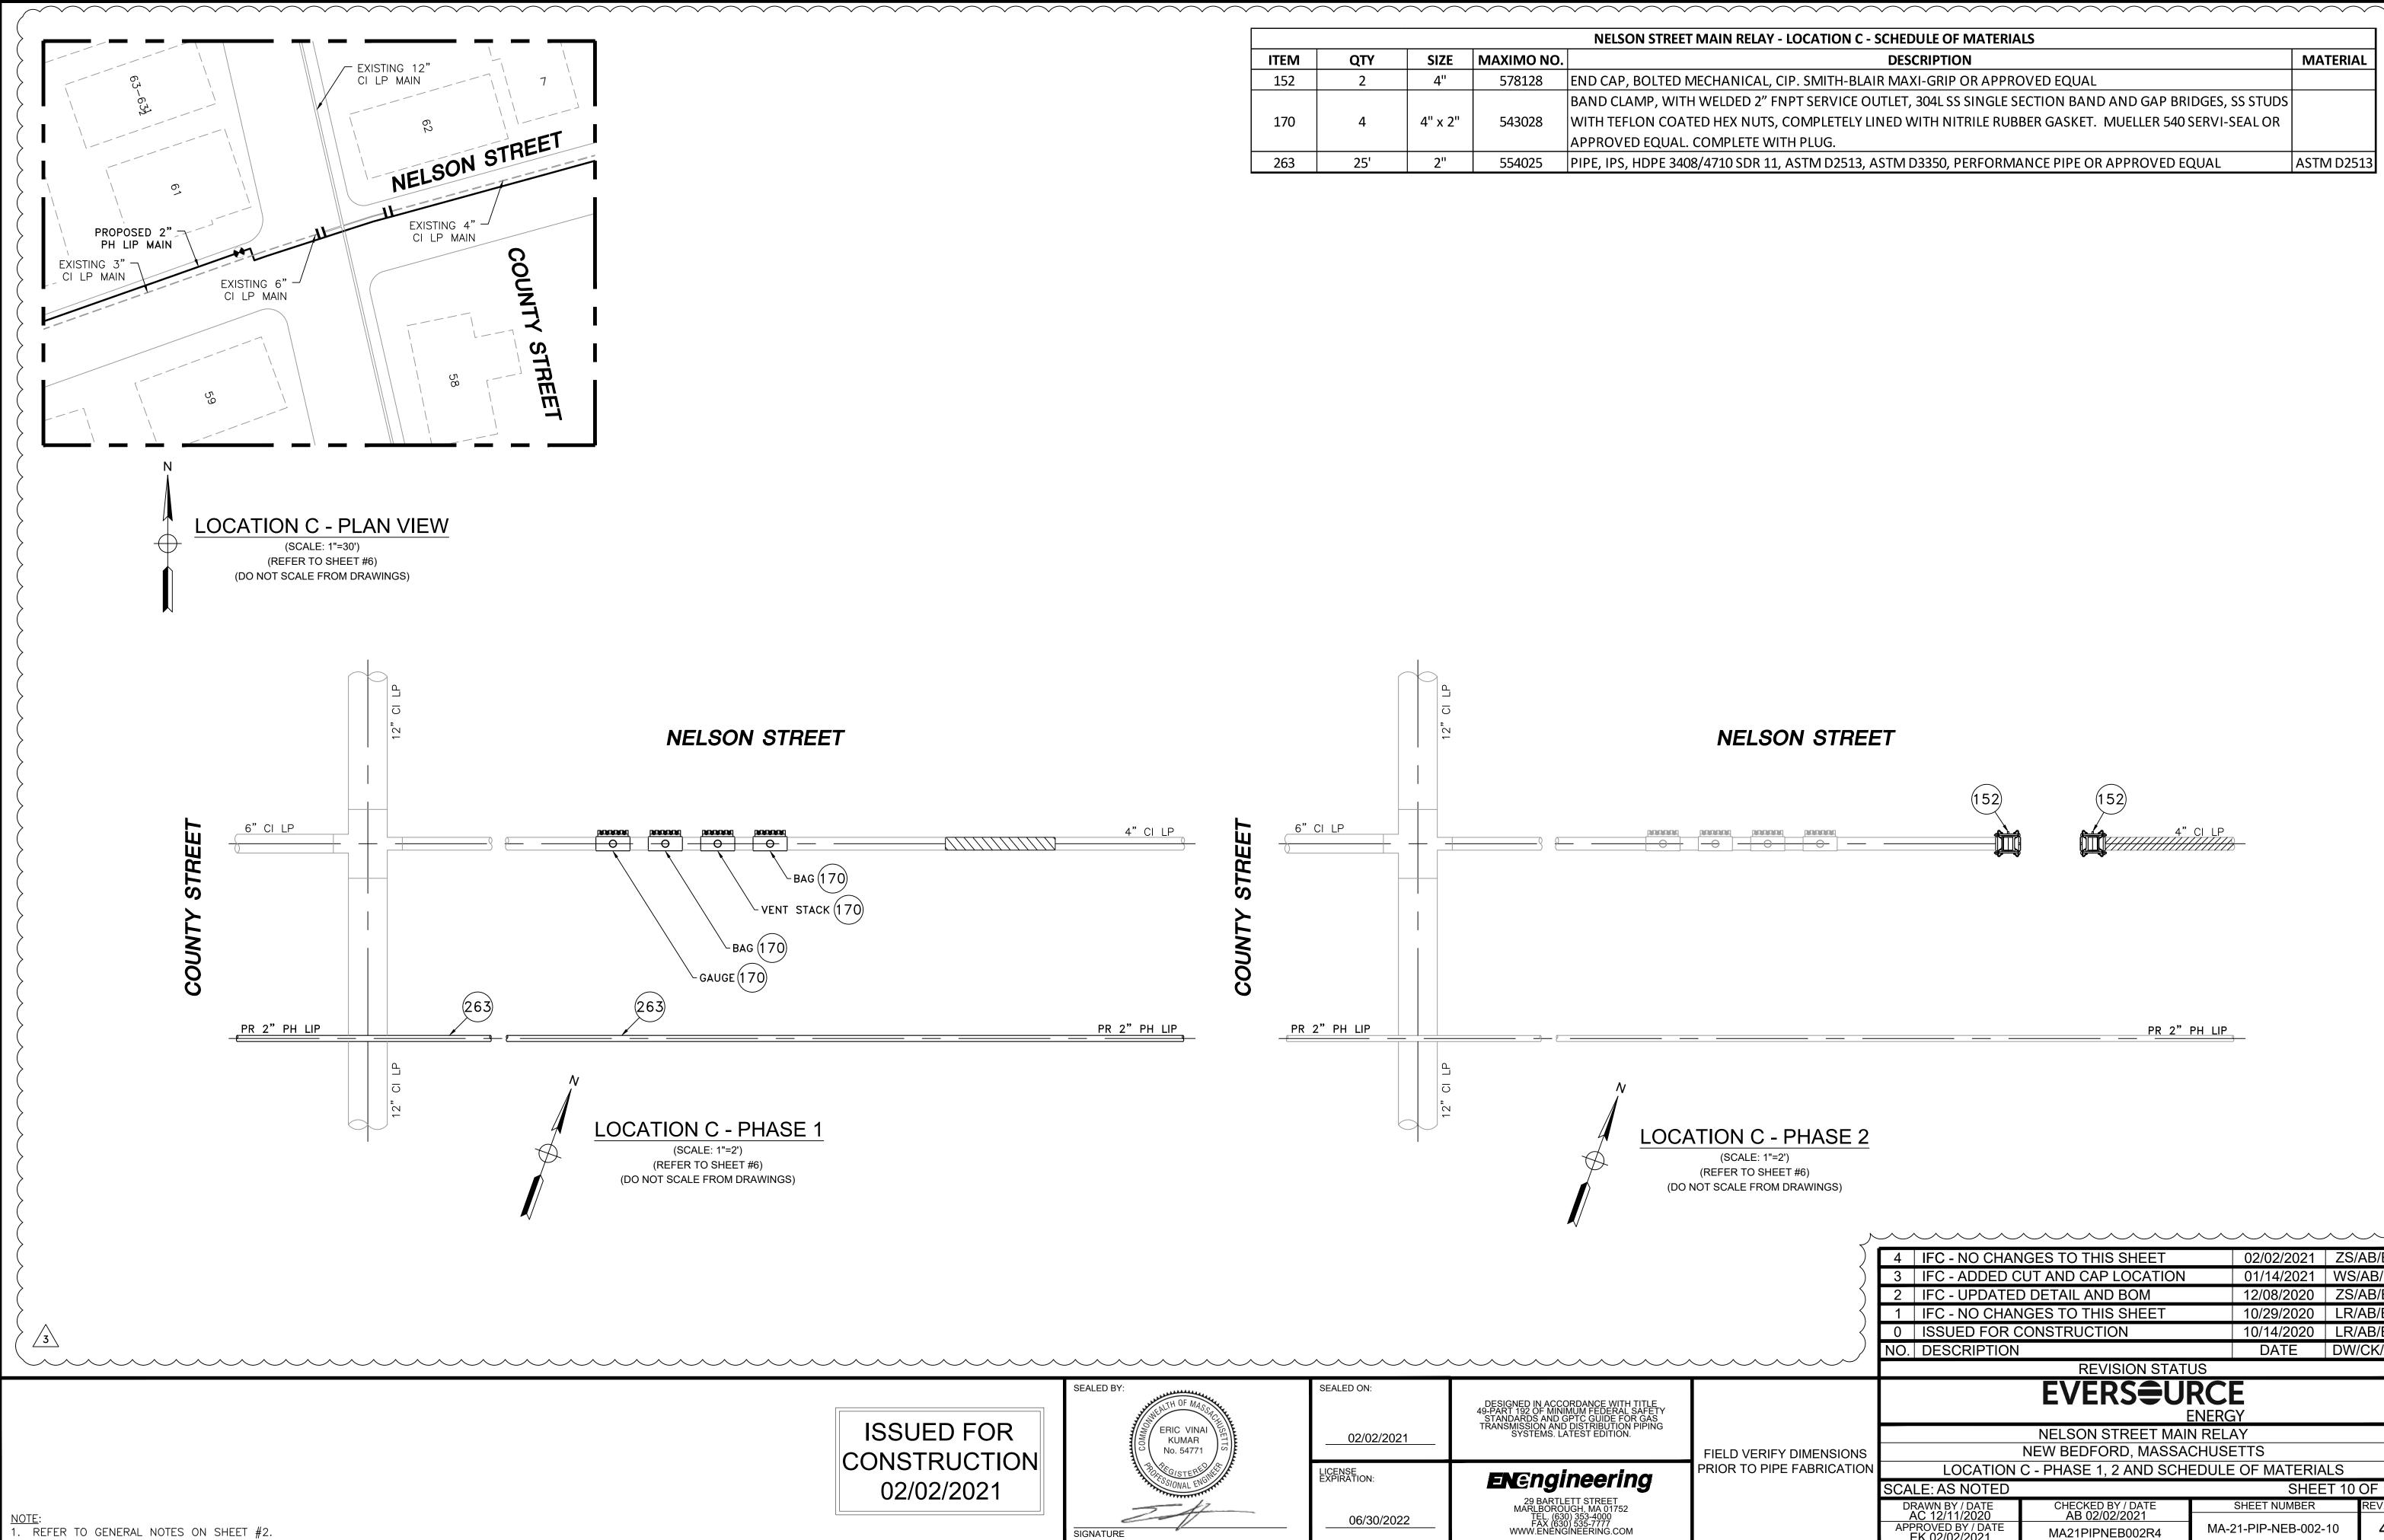


			••••	
				NELSON STREET MAIN RELAY - L
ITEM	QTY	SIZE	MAXIMO NO.	
152	2	4"	578128	END CAP, BOLTED MECHANICAL, CI
				BAND CLAMP, WITH WELDED 2" FN
170	4	4" x 2"	543028	WITH TEFLON COATED HEX NUTS, C
				APPROVED EQUAL. COMPLETE WITH
263	25'	2"	554025	PIPE, IPS, HDPE 3408/4710 SDR 11, A
	1	-		, , , , , , , , , , , , , , , , , , , ,

ISSUED FOR ONSTRUCTION 02/02/2021	KUMAR No. 54771	02/02/2021	ENEngineering	FIELD VERIFY DIMENSIONS PRIOR TO PIPE FABRICATION	NELSON STREET M/ NEW BEDFORD, MASS LOCATION C - PHASE 1, 2 AND SC SCALE: AS NOTED	ACHUSETTS HEDULE OF MATERIA	LS T 10 OF 12
	8 KUMAR 1]	02/02/2021	STSTEMS. LATEST EDITION.	FIELD VERIFY DIMENSIONS			
			I KANSINISSION AND DISTRIBUTION PIPING				
	SEALED BY:	SEALED ON:	DESIGNED IN ACCORDANCE WITH TITLE 49-PART 192 OF MINIMUM FEDERAL SAFETY STANDARDS AND GPTC GUIDE FOR GAS TRANSMISSION AND DISTRIBUTION PIPING SYSTEMS. LATEST EDITION.		EVERS€L	JRCE ENERGY	
					REVISION STA		
					NO. DESCRIPTION	DATE	DW/CK/AP
					1 IFC - NO CHANGES TO THIS SHEET 0 ISSUED FOR CONSTRUCTION	10/29/2020	LR/AB/EK LR/AB/EK
					2 IFC - UPDATED DETAIL AND BOM	12/08/2020	ZS/AB/EK
					3 IFC - ADDED CUT AND CAP LOCATIO	N 01/14/2021	WS/AB/EK
)	4 IFC - NO CHANGES TO THIS SHEET	02/02/2021	ZS/AB/EK
				7			

LOCATION C - SCHEDULE OF MATERIALS					
DESCRIPTION	MATERIAL				
P. SMITH-BLAIR MAXI-GRIP OR APPROVED EQUAL					
PT SERVICE OUTLET, 304L SS SINGLE SECTION BAND AND GAP BRIDGES, SS STUDS					
COMPLETELY LINED WITH NITRILE RUBBER GASKET. MUELLER 540 SERVI-SEAL OR					
H PLUG.					
ASTM D2513, ASTM D3350, PERFORMANCE PIPE OR APPROVED EQUAL	ASTM D2513				

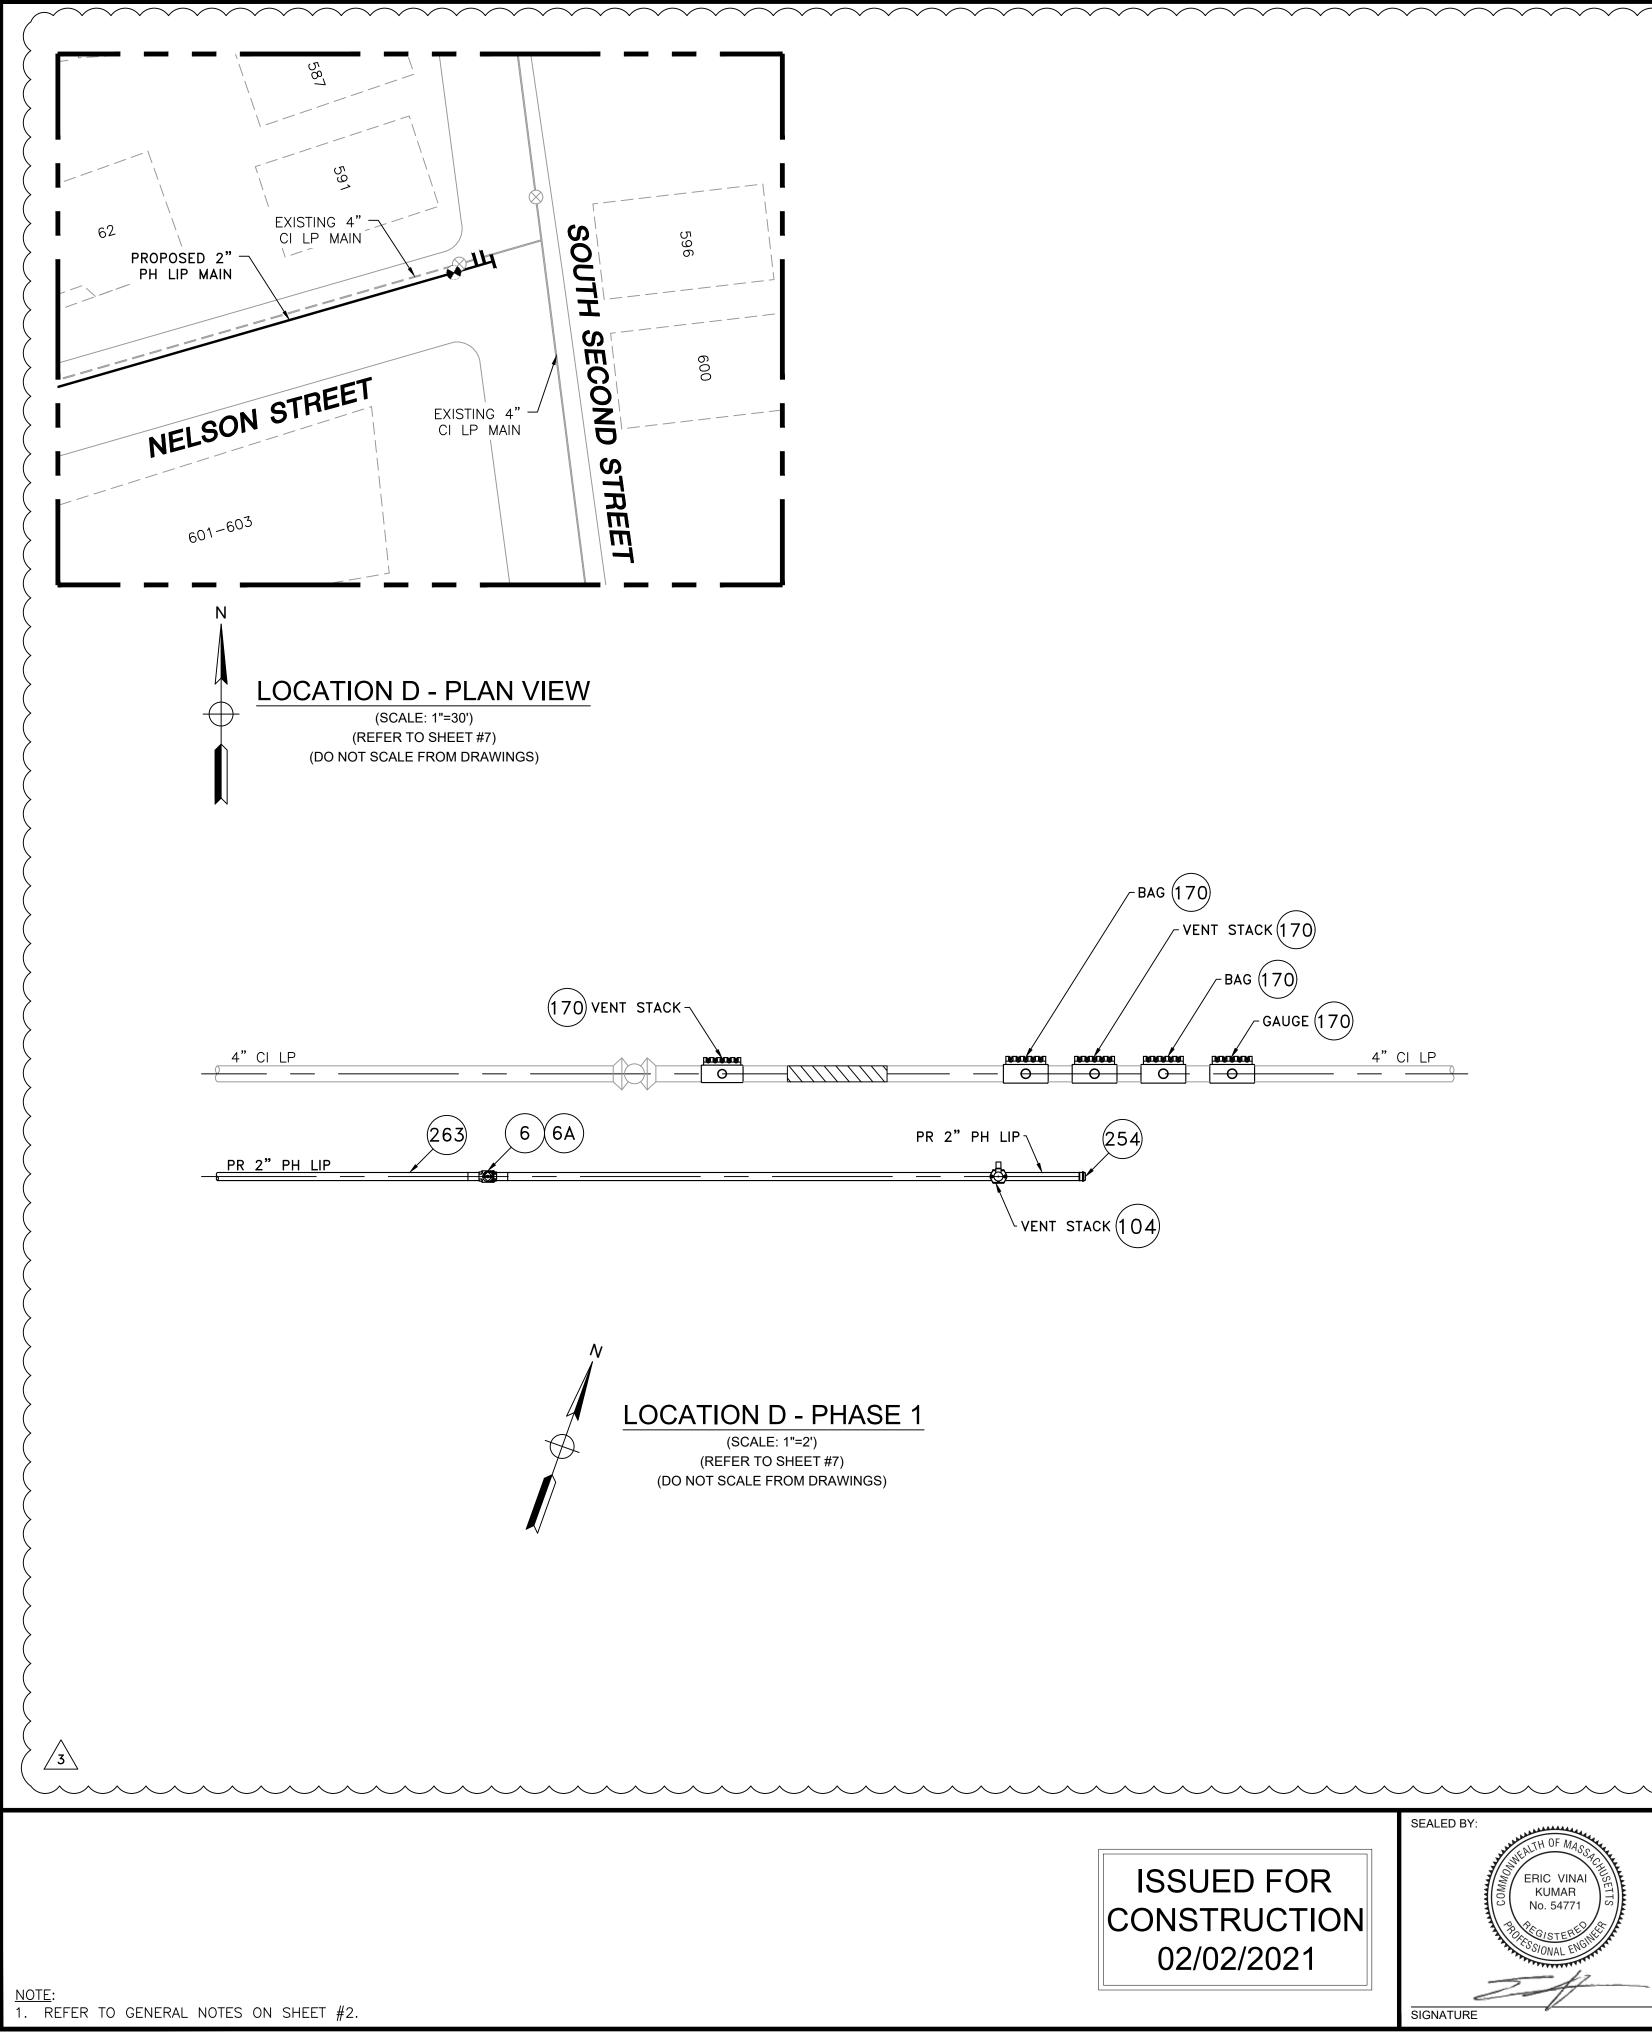


				NELSON STREET MAIN RELAY - LOCATION D - SCHEDULE OF MATERIALS	
ITEM	QTY	SIZE	MAXIMO NO.	DESCRIPTION	MATERIAL
6	1	2"	562087	BALL VALVE, BUTT FUSION, IPS, HDPE 3408/4710, SDR 11, ASTM D2513, ASME B16.40. FULL PORT, 1/4 TURN, KEROTEST POLYBALL OR APPROVED EQUAL.	ASTM D2513
6A	1	2"		BOX, VALVE, PLASTIC, SNAP-ON, ADJ, W/CI NON-LOCKING LID	PLASTIC
104	1	2" X 1"	560779	TAPPING TEE, ELECTROFUSION, IPS X IPS, HDPE 3408/4710, SDR 11, ASTM D2513, ASTM D3350, ASTM D3261, ASTM F1055. CENTRAL PLASTICS OR APPROVED EQUAL.	ASTM D2513
152	2	4"	578128	END CAP, BOLTED MECHANICAL, CIP. SMITH-BLAIR MAXI-GRIP OR APPROVED EQUAL	
170	5	4" x 2"	543028	BAND CLAMP, WITH WELDED 2" FNPT SERVICE OUTLET, 304L SS SINGLE SECTION BAND AND GAP BRIDGES, SS STUDS WITH TEFLON COATED HEX NUTS, COMPLETELY LINED WITH NITRILE RUBBER GASKET. MUELLER 540 SERVI-SEAL OR APPROVED EQUAL. COMPLETE WITH PLUG.	
254	AS REQUIRED	2"	581633	END CAP MECHANICAL COMPRESSION, SDR 11 IPS, DUPONT ZYTEL ST-801 NYLON BODY, 316 SS COMRESSION RING, INTERNAL STIFFENER, ASTM D-2513, ASTM F1924. METFIT OR APPROVED EQUAL.	ASTM D2513
263	15'	2"	554025	PIPE, IPS, HDPE 3408/4710 SDR 11, ASTM D2513, ASTM D3350, PERFORMANCE PIPE OR APPROVED EQUAL	ASTM D2513
272	AS REQUIRED	1"	542612	END CAP, MECHANICAL STAB, IPS, HDPE, PE 4710/3408, ASTM D2513, WITH SS GRIPPING SUPPORT RING, ACETAL COLLET AND SPACER RETAINER RING, PE THRUST WASHER, BUNA-N O-RING, ZINC-PLATED CS INSERT STIFFENER, PERFECTION WITH END CAP OR APPROVED EQUAL.	ASTM D2513

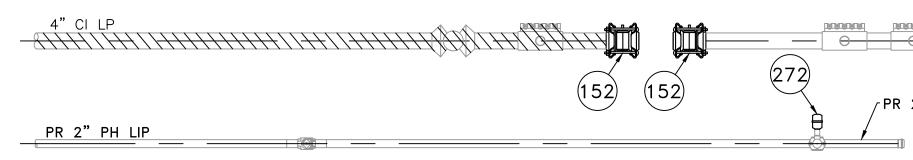

LOCATION D - PHASE 2 (SCALE: 1"=2') (REFER TO SHEET #7) (DO NOT SCALE FROM DRAWINGS)

				ر بر	~~~~~~~~~~~~~~~~~~~~~~~~~~~~~~~~~~~~~~~	~~~~~	$\sim\sim\sim$	
)	4 IFC - NO CHANGES TO THIS SHEET	02/02/2021	ZS/AB/EK	
					3 IFC - NEW PROPOSED TIE IN L,OCATION D	01/14/2021	WS/AB/EK	
				\mathbf{x}	2 IFC - UPDATED DETAIL AND BOM	12/08/2020	ZS/AB/EK	
				\langle	1 IFC - NO CHANGES TO THIS SHEET	10/29/2020	LR/AB/EK	
				<	0 ISSUED FOR CONSTRUCTION	10/14/2020	LR/AB/EK	
					NO. DESCRIPTION	DATE	DW/CK/AP	
					REVISION STATUS			
	SEALED BY:	SEALED ON:	DESIGNED IN ACCORDANCE WITH TITLE 49-PART 192 OF MINIMUM FEDERAL SAFETY STANDARDS AND GPTC GUIDE FOR GAS TRANSMISSION AND DISTRIBUTION PIPING SYSTEMS. LATEST EDITION.		EVERS URCE ENERGY			
ISSUED FOR	ERIC VINAI KUMAR No. 54771 BOUSSIONAL ENGINE	02/02/2021	SYSTEMS. LATEST EDITION.		NELSON STREET MAIN REL			
ONSTRUCTION				FIELD VERIFY DIMENSIONS	NEW BEDFORD, MASSACHUS			
		LICENSE EXPIRATION: ENErgine	ENEngineering	PRIOR TO PIPE FABRICATION	LOCATION D - PHASE 1, 2 AND SCHEDUL	- PHASE 1, 2 AND SCHEDULE OF MATERIALS		
02/02/2021			ENGIGINECTING		SCALE: AS NOTED	SHEE	T 11 OF 12	
	24	00/00/0000	29 BARTLETT STREET MARLBOROUGH, MA 01752 TEL. (630) 353-4000		DRAWN BY / DATE CHECKED BY / DATE AC 12/11/2020 AB 02/02/2021	SHEET NUMBER	REV. NO.	
	SIGNATURE	06/30/2022	FAX (630) 535-7777 WWW.ENENGINEERING.COM			-21-PIP-NEB-002-	11 4	

1 — —					4"CI	LP
272						
	} ∕	PR 2"P	H LIP			

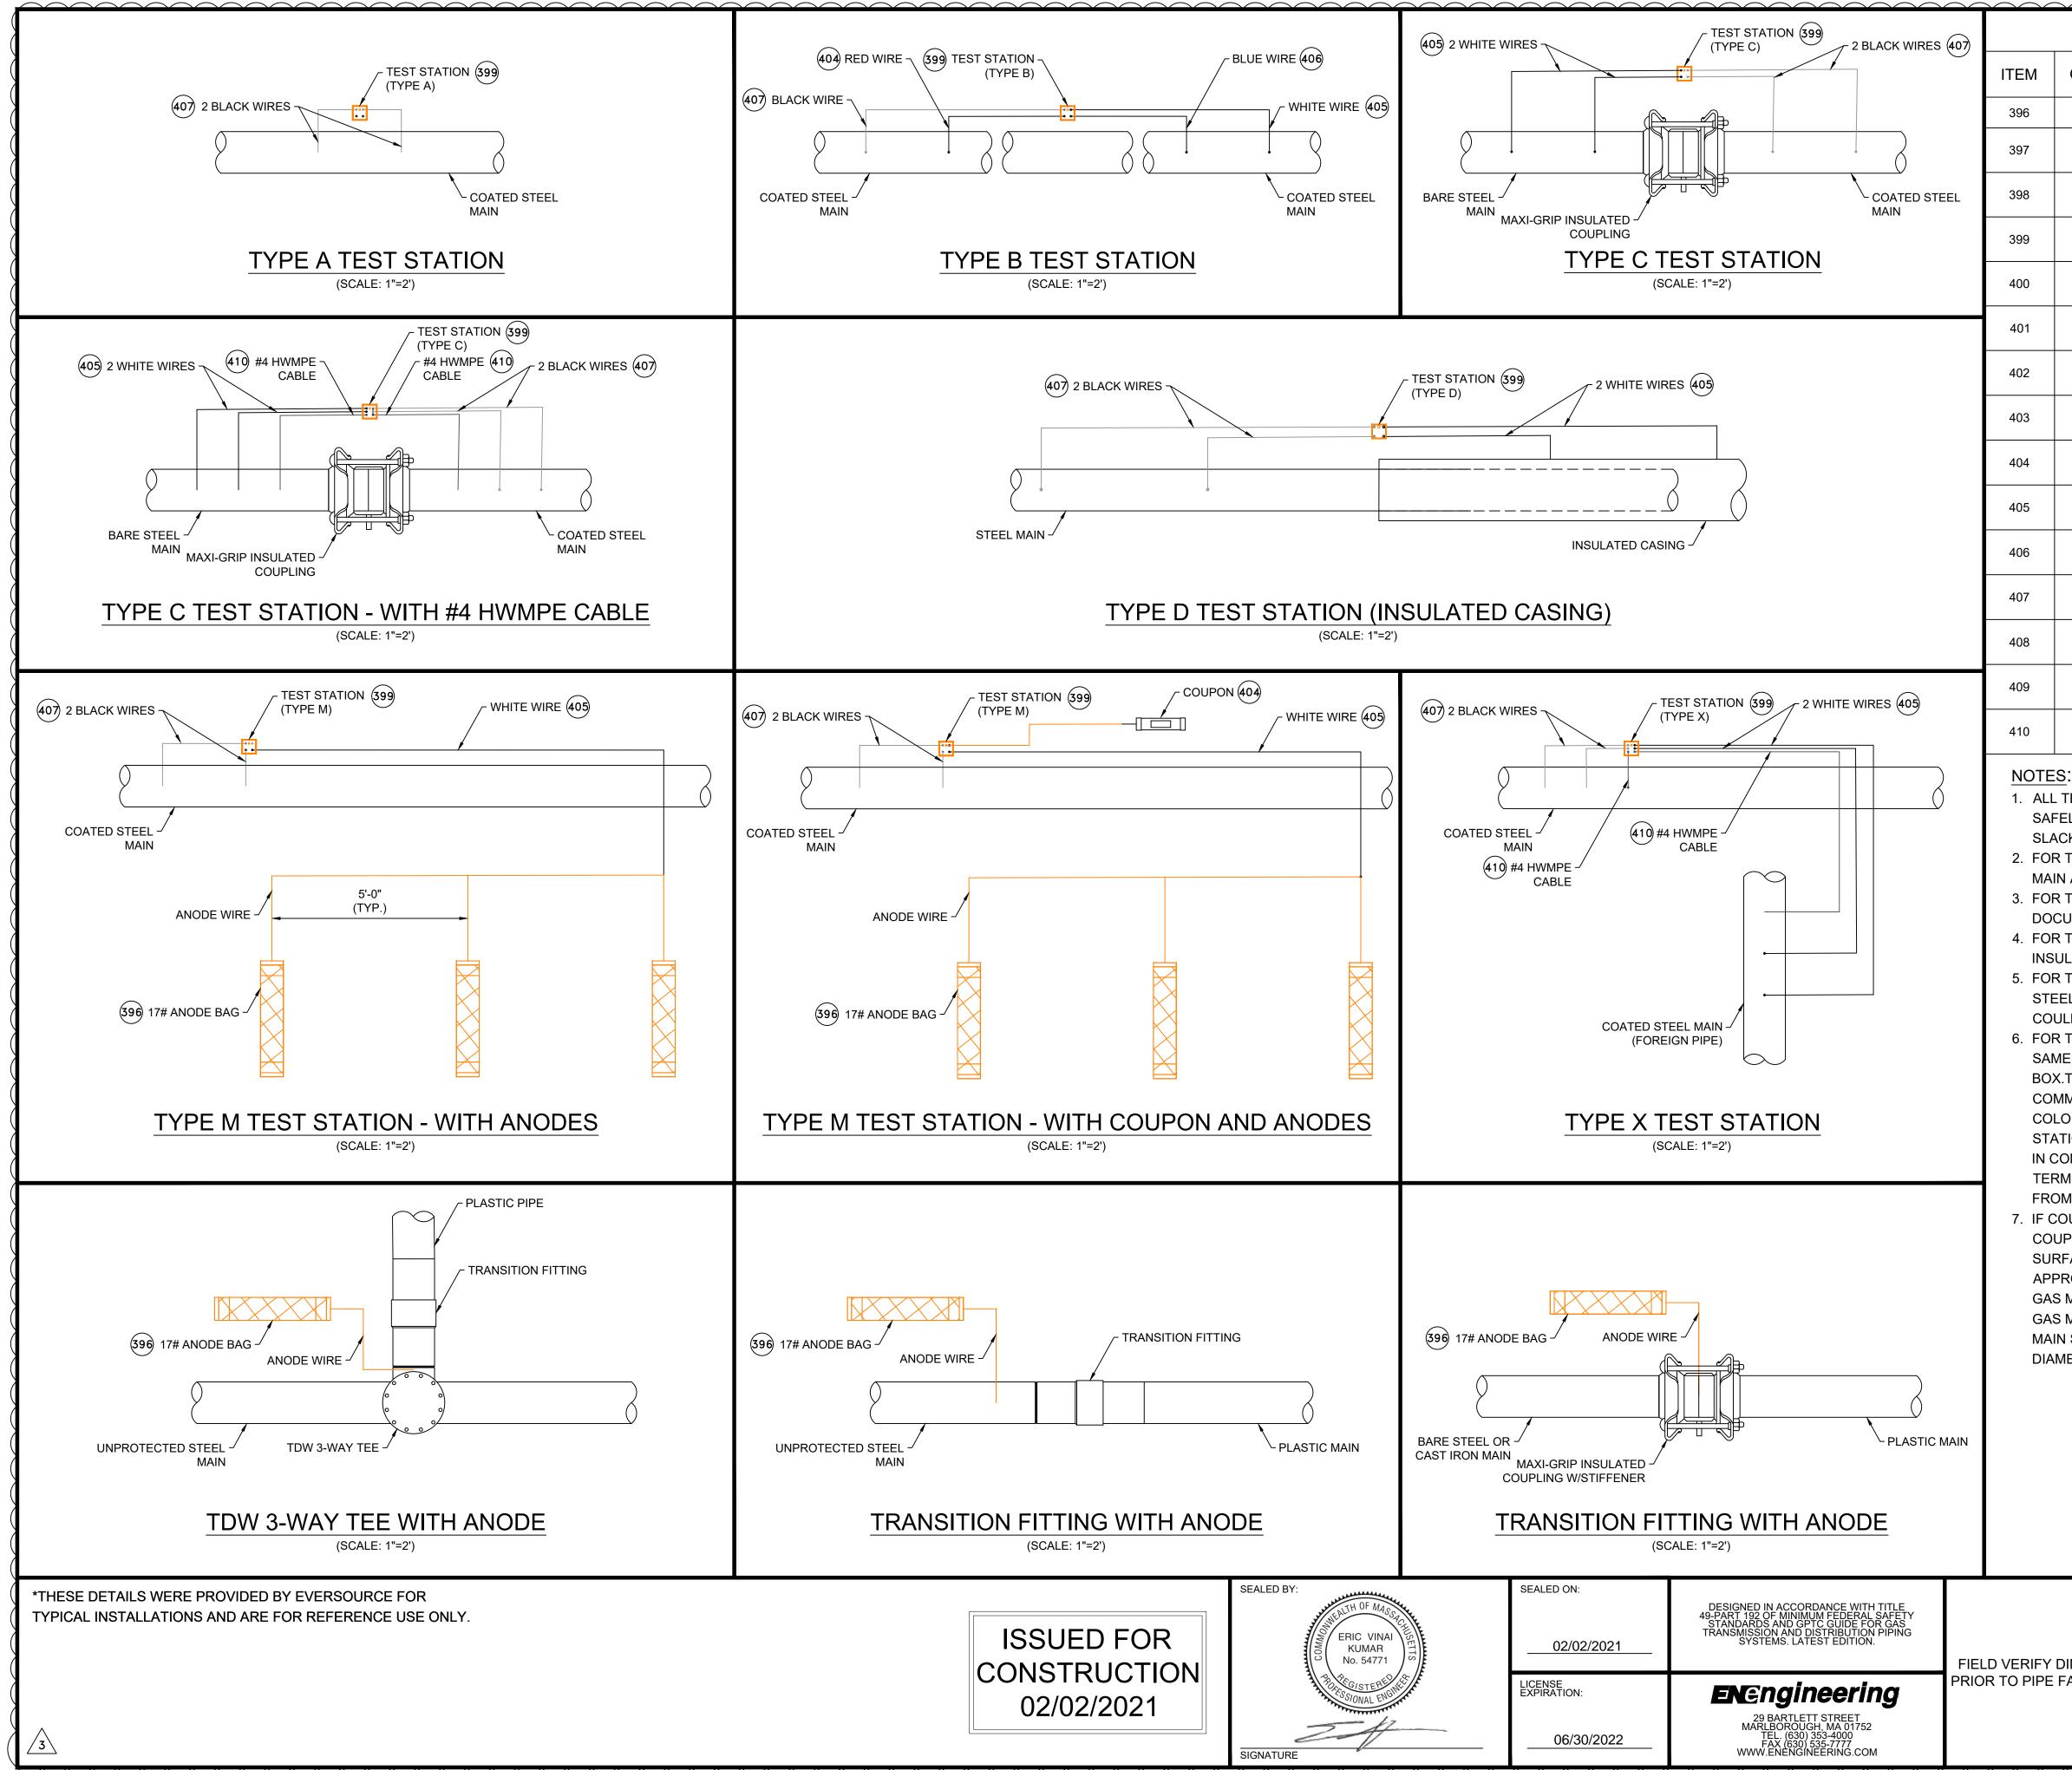

	$\sim \sim \sim$	\frown						
	CATHODIC PROTECTION BILL OF MATERIALS							
	QTY	SIZE	MAXIMO NO.	DESCRIPTION				
	х	EA	577776	ANODE,BAG, 17 LB NET, HIGH POTENTIAL MAGNESIUM, W/ 10 FT #10 AWG TW ORANGE LEAD WIRE, PACKED IN CARDBOARD BOX 42 LB TOTAL WEIGHT				
	х	EA	517626	CONNECTOR, SPLIT BOLT, 12 SOLID - 10 STRANDED, CU TO CU, HOUSING (COVER) MATE IN 590389,				
	х	EA	590389	HOUSING, 50 V MAX, 10 AWG MAX, FOR PROTECTING TRACER WIRE SPLICES, USED WITH CONNECTOR IN 517626. 10/BAG				
	х	EA	590871	BOX VALVE, TEST STATION, CP TEST #178, 10-1/4 IN DIA. LID, 8-3/8 IN I.D. 16 IN H., ASTM A48 CL 25 CAST IRON, FOR OFF-ROAD USE ONLY				
	х	BOX	508567	POWDER, CARTRIDGE, TYPE IS F-33, ALLOY , CAP COLOR CLEAR, 15 GM CHARGE, 20/PAC, FOR STEEL PIPE				
	х	EA	559168	SLEEVE,ELECTRICAL, #14 TO 10 AWG, W/ THERMITE WELDER, FOR CATHODIC PROTECTION				
	х	ES	584045	EDI CONCENTRIC COUPON ASSEMBLY INCLUDING UCB-ZIN-LW010, 10 FT OF CABLE				
	х	ES	603126	EDI CONCENTRIC COUPON ASSEMBLY INCLUDING UCB-ZIN-LW025, 25 FT OF CABLE				
	х	ROLL	603140	WIRE,ELECTRICAL, THHN, 1/C, #10 AWG, STRANDED, RED, INSULATED, CU, 500 FT SPOOL, WIRE				
	х	ROLL	578415	WIRE,ELECTRICAL, THHN, 1/C, #10 AWG, STRANDED, WHITE, INSULATED, CU, 500 FT SPOOL, WIRE				
	х	ROLL	603141	WIRE,ELECTRICAL, THHN, 1/C, #10 AWG, STRANDED, BLUE INSULATED, CU, 500 FT SPOOL, WIRE				
	х	ROLL	603139	WIRE,ELECTRICAL, THHN, 1/C, #10 AWG, STRANDED, BLACK, INSULATED, CU, 500 FT SPOOL,WIRE				
	х	EA	500804	WELDER,THERMITE, THERMITE, FOR GAS PIPE, #12 CABLE,HORIZONTAL STEEL PIPE 4 IN AND LARGER DIAMETER				
	х	EA	500805	WELDER,THERMITE, THERMITE, FOR GAS PIPE, #12 CABLE, HORIZONTAL STEEL PIPE 3/4 - 3-1/2 IN DIAMETER				
	х	FT	513850	CABLE, INSULATED, CATHODIC PROTECTION, 1/C, #4 AWG, 7 STR, 600 V, BLACK, HMWPE, CU, 1000 FT ROLLS				
_			1					

1. ALL TEST STATION BOXES SHOULD BE INSTALLED IN A SAFE LOCATION WHERE ONE INDIVIDUAL CAN SAFELY OPEN AND ACCESS THE TEST WIRES. ALL TEST WIRES INSIDE THE BOX SHOULD HAVE ENOUGH SLACK ON THE WIRES SO THEY CAN EXTEND A MINIMUM OF 12" ABOVE GRADE.

2. FOR TYPE A TEST STATIONS, THE TWO WIRES SHOULD BE THERMITE WELDED TO THE COATED STEEL MAIN AND BE THE SAME COLOR. (COUPONS COULD BE ADDED TO THE TEST STATION TYPE) 3. FOR TYPE B TEST STATIONS, EACH OF THE FOUR WIRES SHOULD BE A DIFFERENT COLOR AND DOCUMENTED

4. FOR TYPE C TEST STATIONS, THE WIRES SHOULD BE THE SAME COLOR ON EACH SIDE OF THE INSULATED COUPLING. (ANODES AND/OR COUPONS COULD BE ADDED TO THIS TEST STATION TYPE) 5. FOR TYPE D TEST STATIONS WHICH ARE AT A CASING, WHITE WIRES ARE NORMALLY INSTALLED ON THE STEEL CASING AND BLACK WIRES ON INSTALLED ON THE CARRIER PIPE. (ANODES AND/OR COUPONS COULD BE ADDED TO THIS TEST STATION TYPE).

6. FOR TYPE M TEST STATIONS, THE TWO WIRES THERMITE WELDED TO THE CARRIER PIPE SHOULD BE THE SAME COLOR WIRE. THERE IS ALSO MAGNESIUM ANODE(S) WIRE(S) LOCATED INSIDE THE TEST STATION BOX.THE WIRE COLOR (TYPICALLY ORANGE) FOR THE ANODES. IF THE ANODE WIRES ARE SPLICED TO A COMMON ANODE HEADER CABLE, THE ANODE HEADER CABLE SHOULD BE A (WHITE OR RED) DIFFERENT COLOR WIRE THAN THE WIRE THAT WAS THERMITE WELDED TO THE CARRIER PIPE. AT A TYPE M TEST STATION, NO MAGNESIUM ANODES SHOULD BE DIRECTLY THERMITE WELDED TO THE CARRIER PIPE OR IN CONTACT WITH THE CARRIER PIPE. THE ANODE HEADER WIRE OR INDIVIDUAL ANODE WIRES SHOULD TERMINATE INSIDE THE TEST STATION BOX. ANODES SHOULD BE SPACED A MINIMUM OF 5' ON CENTER FROM EACH OTHER AND A MINIMUM OF 12" AWAY AND BELOW THE BOTTOM OF THE STEEL MAIN. 7. IF COUPONS ARE TO BE INSTALLED, FIRST REMOVE THE PROTECTIVE LABEL COVERING THE STEEL COUPON AND THE RED STICKERS COVERING EACH SENSING PORT. CLEAN THE ENTIRE STEEL COUPON SURFACE WITH ALCOHOL TO REMOVE THE CORROSION INHIBITOR .PLACE THE COUPON ASSEMBLY APPROXIMATELY 12" FROM THE GAS MAIN BEING MONITORED WITH THE SENSING PORTS FACING THE GAS MAIN. THE COUPON ASSEMBLY SHOULD BE LOCATED ADJACENT TO THE BOTTOM PORTION OF THE GAS MAIN, ANYWHERE BETWEEN 3 O'CLOCK AND 9 O'CLOCK. THE SOIL BETWEEN THE COUPON AND THE MAIN SHOULD BE WELL COMPACTED AND CONTAIN NO ROCKS LARGER THAN A CENTIMETER IN DIAMETER OR FOREIGN MATERIAL.

	4	IFC - NO CHAN	IGES TO THIS SHEET		02/02/2021	ZS/	AB/EK	
	3	IFC - NO CHAN	01/14/2021	WS/	AB/EK			
	2	IFC - NO CHAN	12/08/2020	ZS/AB/EK				
	1	IFC - ADDED S	HEET		10/29/2020	LR/	AB/EK	
	0	ISSUED FOR C	CONSTRUCTION		10/14/2020	LR/	AB/EK	
	NO.	DESCRIPTION			DATE	DW/	′CK/AP	
			REVISION STAT	US				
	EVERS URCE ENERGY							
	NELSON STREET MAIN RELAY							
DIMENSIONS	NEW BEDFORD, MASSACHUSETTS							
FABRICATION	STANDARD CORROSION DETAILS							
	SCALE: 1"=2' (DO NOT SCALE FROM DRAWINGS) SHEET 12 OF 12							
	DF	RAWN BY / DATE AC 12/11/2020	CHECKED BY / DATE AB 02/02/2021		SHEET NUMBER		REV. NO.	
	APF	PROVED BY / DATE EK 02/02/2021	MA21PIPNEB002R4	MA-2	21-PIP-NEB-002-	·12	4	