



CITY OF NEW BEDFORD
MASSACHUSETTS
ENGINEERING- 508-979-1550

CONSTRUCTION OF
PAVED
SIDEWALK/ DRIVEWAY

Expires: 7-8-2022

Application No. 11721

Date: 7-8-2021

Property Owner: Lopez Development Tel: 508.441.8000

Address: 129 Huxton Ave NE MA 02719
Street City State zip code

The above hereby request permission to construct a paved: / driveway / / sidewalk
located at Forward Circle (w/s) 5 x Drill's Rd, plot 1309, lot 446 in accordance
with the terms and conditions set forth herein, and the Ordinances of the City of New Bedford.

Sidewalk	Dimensions	Driveway	Width (ft)
☐ Residential		☒ Residential	
☐ Commercial		☐ Commercial	
☒ Bituminous Concrete		☐ Relocation / Widening	
☒ Concrete Full Width	<u>55' x 10'</u>	☐ Curb Removal	
☒ Concrete w/ Grass Ribbon	<u>55'</u>	☒ Concrete	<u>18' x 10'</u>
☐ Curb needed		☐ Bituminous Concrete	

Comments: Buildings LOT #15: Proposed concrete walkway:
+ granite curbing 55'-1- (both sides)

Bonded Contractor: _____ Tel: _____

Traffic Commission: _____ Approved _____ Rejected _____ Date _____

Signature _____

Building Dept.

☒ Approved (New Building)
☐ Approved - Bldg. Permit # B-21-17
☐ Rejected

Signature: Denny Amodeo (C.T.)

Engineering Dept.

____ Approved _____ Rejected _____ Date _____

Paving site visit

Signature _____

Permit / Inspection fee of \$150.00 must accompany this application.

Special Requirements:

Contractor to call 24 hrs. in advance for pre-inspection (prior to pouring). If curbing is removed, it must be returned in whole pieces within 24 hrs. to the D.P.I. City Yard on Liberty St. (btwn Parker St. & Durfee St.) accompanied with original curbing receipt.

PAID: \$150.00 Check # 1542

Supervising Civil Engineer: Stephanie Chavira (C.T.)

By: Chavira Torres

Print name: (property owner/representative)
X Dacia King

Signature: (property owner/representative)
X [Signature]

MISCELLANEOUS PAYMENT RECPT#: 3412184
City of New Bedford
133 William St.
New Bedford MA 02740

DATE: 07/08/21 TIME: 14:53
CLERK: a450mbb DEPT:
CUSTOMER#: 0

COMMENT:

CHG: DPIDRV DPI DRIVEWAY PE 150.00

REVENUE:

1 03406000 454010 150.00

DPI - Driveway-Sidewalk Permit

CASH:

TW05 101009 150.00

Cash Treasurer Dep W

AMOUNT PAID: 150.00

PAID BY: LOPEZ DEVELOPMENT LL

PAYMENT METH: CHECK

REFERENCE: MR1542

AMT TENDERED: 150.00

AMT APPLIED: 150.00

CHANGE: .00



CITY OF NEW BEDFORD

City Hall, Room 309, 133 William Street, New Bedford, MA 02740 (508) 979-1540

FOUNDATION PERMIT

5/25/2021

FEE PAID \$100.00

MSBC Sect. 111.8 - Any permit issued shall be deemed abandoned and invalid unless the work authorized by it shall have been commenced within six (6) months after its issuance.

This certifies that Eddie Lopez

owner/contractor has permission to:

WS- FARLAND CRC

130D

466

Foundations Only 1-2 Family - 100.00

Providing that the person accepting this permit shall in every respect conform to the terms of application, therefore on file in this office; to the provisions of the statute of the Commonwealth and to the by-laws of the City of New Bedford relating to the inspection, erection, enlarging, altering, raising, moving, repairing, or tearing down of a building.

Permit is issued subject to the following special requirements: (Restrictions)

Writing Inspector

Plumbing Inspector

Building Inspector

YOUR AREA INSPECTOR IS: Thomas Welch

Tel: (508) 979-1540 Between 8:00am - 9:00am

OCCUPANCY PERMIT REQUIRED BEFORE OCCUPANCY


NOTICE: NOTIFY INSPECTOR 48 HOURS IN ADVANCE OF APPLYING SHEATHING OR LATHING

No Building or Structure shall be used or occupied until the Certificate of Use and Occupancy shall have been issued by the Building Commissioner - MSBC, Sect. 120.1


This Card Must Be Displayed in a Conspicuous Place on the Premises and Not Torn Down or Removed Until Completion of Work

SUBJECT TO MASSACHUSETTS STATE BUILDING CODE

Thomas Welch

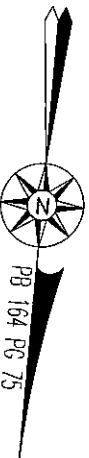


— ZONING DATA —	
DISTRICT: SINGLE RESIDENCE D	
DESCRIPTION	REQUIRED
FRONT SETBACK	20 FT
SIDE SETBACK	10/12 FT
REAR SETBACK	30 FT

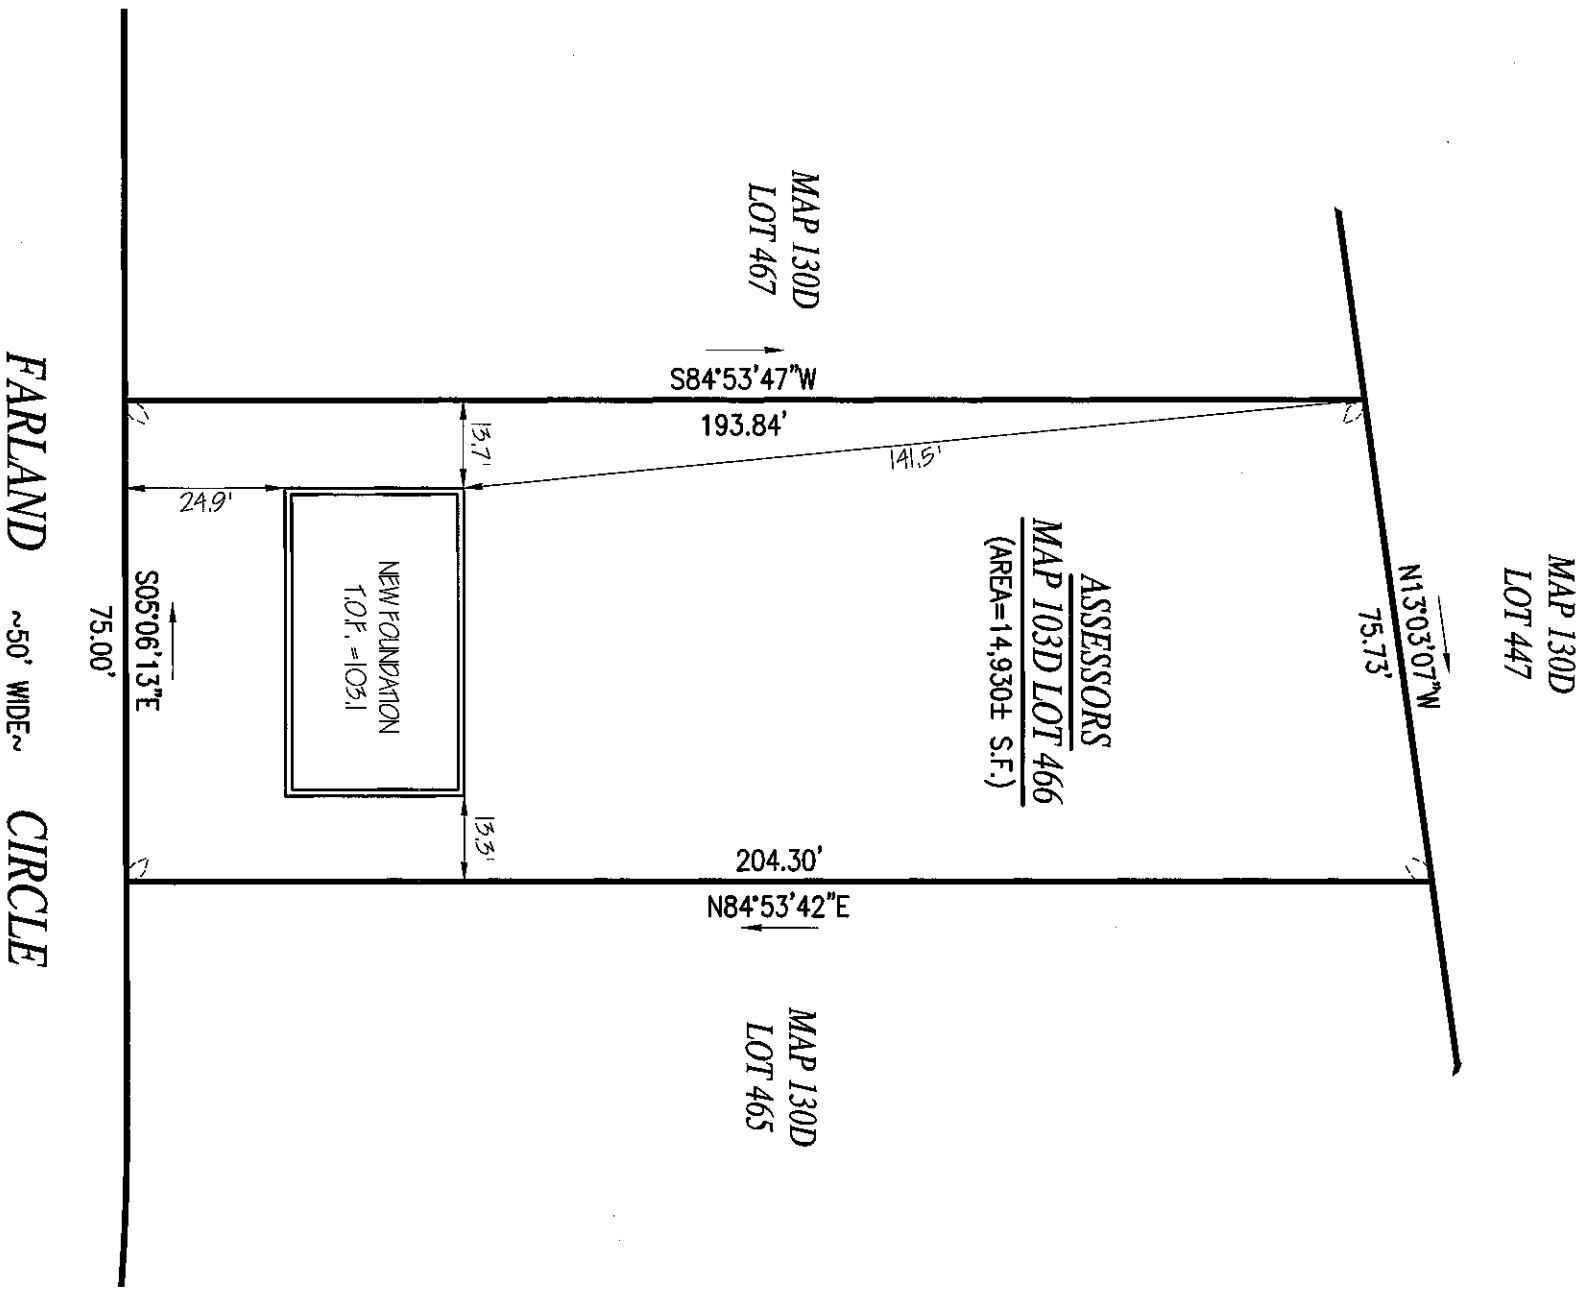


FARLAND ~50' WIDE~ CIRCLE

NOTE:
AS-BUILT SURVEY PERFORMED BY FARLAND CORP IN JUNE 2021
COPYRIGHT © 2020 FARLAND CORP. ALL RIGHTS RESERVED
NO PART OF THIS DOCUMENT MAY BE REPRODUCED, STORED IN A RETRIEVAL SYSTEM, OR TRANSMITTED IN ANY FORM OR BY ANY MEANS, ELECTRONIC, MECHANICAL, PHOTOCOPYING, RECORDING OR OTHERWISE, WITHOUT THE EXPRESS WRITTEN CONSENT OF FARLAND CORP.
ANY MODIFICATIONS MADE TO THIS DOCUMENT WITHOUT THE WRITTEN PERMISSION OF FARLAND CORP. SHALL RENDER IT INVALID AND UNUSABLE.

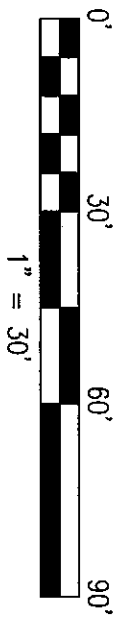

FOUNDATION AS-BUILT
LOT 15 FARLAND CIRCLE
ASSESSORS MAPD130D LOT 465
NEW BEDFORD, MASSACHUSETTS

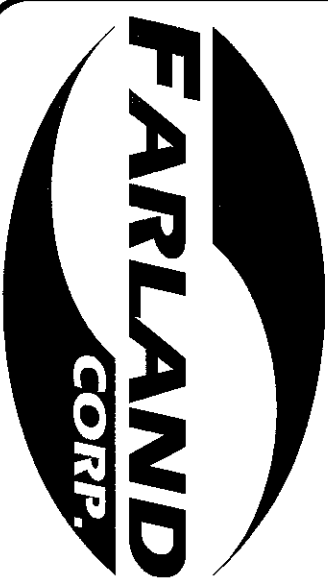


FARLAND
CORP.

21 VENTURA DRIVE
DARTMOUTH, MA 02747
P.508.717.3479

- ENGINEERING
- SITEMARK
- LAND SURVEYING
- DEVELOPMENT

www.FarlandCorp.com

PREPARED FOR:
TD DESIGN AND DEVELOPMENT CORP.
403 ROCKDALE AVENUE
NEW BEDFORD, MA 02740

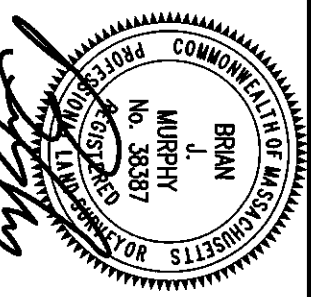

SCALE: 1"=30'

JUNE 24, 2021

DRAWN BY: AJT

JOB NO: 19-744