

APPLICATION/AGREEMENT
For Trench/Disturbance Permit within the City of New Bedford

Permit # 399-2022
Dig Safe# 20220803726
Date: 2/23/2022

TO THE MAYOR AND CITY COUNCIL: DISTURBANCE PERMIT/TRENCH SAFETY PERMIT

Permission is hereby requested to excavate the surface of: X City Property and/or X Private Property

Provide Sketch

Location of Work: 366 Ash St.

Emergency Gas Leak Repair

Work will begin (weather permitting) on: February 23, 2022

Applicant Name: Kevin O'Sullivan (ra) Excavator(s) Name: _____

Company Name: Eversource Hoisting Equipment License Number: _____

Grade: _____ Expiration Date: _____

Contact Number: 508-441-5817 Name & Contact Number of Insurer: _____

Competent Person on Work Site: ON FILE

APPROVED BY: Stephen Cupola DATE: 9-11-22
TITLE: Asst City Engineer

This permit shall be posted at the work site, and shall remain until the work is completed. It is subject to inspection at all times.

Work completed prior to D.P.L. approval under
emergency work order for Class II Leak

Trenches must be maintained
weekly until final paving is
completed

ROADWAY CLOSURES WILL REQUIRE
AUTHORIZATION FROM THE
COMMISSIONER OF PUBLIC
INFRASTRUCTURE. TRAFFIC MANAGEMENT
PLANS MAY BE REQUIRED.

Permit only valid for three months
from date of approval

PIPE RETIREMENT							
DigSafe/ CBYD Number	PERMIT #		PROJECT #	99945	Unique ID :	7887516-10-[NW82]	
ADDRESS:	366 ASH ST	TOWN:	NEW BEDFORD	DATE:	02/23/22	WORK ORDER- TASK:	7887516-10
SHEET 27 of 33	LEAK REPORT #		LEAK CLASS		TYPE OF WORK:	GASCONSTR	
	Contractor:		WAMFWO:	30292463	WAMCTE #	879836	

FACILITY TYPE	MATERIAL	SIZE	EXT PIPE COND	INT PIPE COND	EXT CORR COND	INT CORR COND	COATING	DEPTH OF COVER
Main	Plastic	2	Good	NA	Good	NA	Good	3' 0"
PIPE INSPECTION								
FACILITY TYPE	MATERIAL	SIZE	EXT PIPE COND	INT PIPE COND	EXT CORR COND	INT CORR COND	COATING	DEPTH OF COVER
	Plastic	3/4			9		LI	1974
PIPE INSTALL								

FACILITY TYPE	MATERIAL	SIZE	LENGTH	PRESSURE METHOD	OVERALL PIPE LENGTH	PIPE REPLACED/INSTALLED	DEPTH OF COVER	CONNECTION AT MAIN	INSTALLED	EFV SUBTYPE	EFV COMMENTS
Service	Plastic	0.50"	9'	LI	Insert	60' or Less	Main to Valve	2' 0"	No Connection	Yes	1/2"-350 Yellow-HDPE-P41-592085
PRESSURE TEST											
MEDIUM	TYPE	START TIME	FINISH TIME	FINISH PRESSURE(PSIG)	TEST DURATION	PERFORMED BY	SOAP TESTED	NOTES			
Air	Service below	2022-02-23 16:45:00	2022-02-23 17:00:00	100	15min	Tyrone Edwards	Yes	From break at main to riser			
RESTORATION											

CONSTRUCTION MATERIAL	LOCATION	EXISTING SURFACE FINISH	EXISTING DEPTH	LENGTH	WIDTH	REQUIRED DEPTH	TEMPORARY REPAIR ACTION	COMPACTION METHOD	% COMPACTED
Hot Asphalt	Street	Asphalt	4	6' 0"	5' 0"	4"		DCP	95
Hot Asphalt	Sidewalk	Concrete	4	6' 0"	5' 0"	4"		DCP	95
MATERIALS									

DESCRIPTION	TYPE	CATALOG ID	SIZE	Q. PLANNED	Q. USED	Unit of Measure	SERIAL NUMBER
-------------	------	------------	------	------------	---------	-----------------	---------------

TEE PIPE, NON-BLOWING, 2 X 1 IN IPS SDR 11, ELECTROFUSION X COMPRESSION ENDS, LIGHT WALL, POLYETHYLENE, PE3408/PE100	NON-BLOWING	560779	2 X 1 IN IPS SDR 11	1		EA	
CABLE, INSULATED, MDP, #12 AWG, 7 STR, YELLOW, POLYETHYLENE-30, SOFT DRAWN CU, 500 FT/RL, FOR USED AS PIPE LOCATOR	INSULATED	513679		100		FT	
BRACKET, STABILIZER, W/CAP SCREW FOR METER BAR, FOR 3/4 - 1-1/4 IN PIPE	STABILIZER	541600		1		EA	
RISER, PREFORMED, ANODELESS, PRE-BENT, FBE STEELXHDPE, 3/4"-14 NPT X 1/2" CTS, .090 WALL, 36" TALL, P						EA	
CLIP, PIPE, UV STABILIZED PVC/ACRYLIC, FOR 3/4 IN PIPE, 6 LG, TRACER WIRE CLIP/PROTECTOR, 50/BOX, GPI PART #TS34X6		587814		1		EA	
BOX VALVE, CURB, W/ 4-1/4 IN SQ COVER NON-LOCKING LTD, RING IN 583489, 48/SKID	CURB	577812		1		EA	
COUPLING, METFIT, REDUCER, 1 IN IPS SDR 11 X 1/2 IN CTS 0.090 IN THK WALL, PLASTIC, PE-4710, REPLACED IN 544384	METFIT, REDUCER	604423	1 IN IPS SDR 11 X 1/2 IN CTS 0.090 IN THK WALL	1		EA	
VALVE,BLEED, EXCESS FLOW, BLACK, 1 IN IPS X 12 IN LG, #P41, PLASTIC, SDR 11, PE4710, SERIES 300	EXCESS FLOW, BLACK	602473	1 IN IPS X 12 IN LG	1		EA	
VALVE,METERING, INSULATING, LOCK-WING TAMPER PROOF, 3/4 X 3/4 IN, TUBE, BLACK FINISH, 15/BOX	INSULATING, LOCK-WING	563157	3/4 X 3/4 IN	1		EA	

DESCRIPTION	TYPE	CATALOG ID	SIZE	Q. PLANNED	Q. USED	Unit of Measure	SERIAL NUMBER
VALVE, METERING, INSULATING, LOCK-WING TAMPER PROOF, 3/4 X 3/4 IN. TUBE, BLACK FINISH, 15/BOX	TAMPER PROOF	563157	3/4 X 3/4 IN	1		EA	
LOCK, EQUIPMENT, TAMPER PROOF, EXPANDABLE, 3 IN LG SHANK, W/ HEX HEAD SHEAR-OFF SCREW, ALUMOWELD RING	TAMPER PROOF	564930		1		EA	
FITTING, COUPLING, METFIT, 1/2 IN CTS X 0.090 IN THK WALL, REPLACED IN 544382	METFIT	580326	1/2 IN CTS X 0.090 IN THK WALL	3		EA	
PIPE, 1/2 IN CTS X 0.090 IN THK WALL SDR 7, 5/8 IN OD, 500 FT LG COIL, POLYETHYLENE, PE3408/PET100		554022	1/2 IN CTS X 0.090 IN THK WALL SDR 7	100		FT	
ANCHOR, EXPANSION, MASONARY, 3/8 IN, 1-7/8 IN LG, W/ BOLT, WASHER, FOR STABILIZER BRACKETS, 50/BOX	EXPANSION, MASONARY	535958	3/8 IN	2		EA	
MANIFOLD, METER, BYPASS, 1P, 90 DEGREE BODY REGULATOR 3/4 X 1 IN W/ 1 IN VENT, 3/16 IN ORIFICE, AT POS, 6410	BYPASS	592895		1		EA	
BAR, 1A SWIVELS							
VALVE, BALL, FULL PORT, 1/2 IN CTS, SDR 7.0, PE 4710, BUTT FUSE, POLYETHYLENE, BLACK FINISH, REPLACED IN 561834		601132	1/2 IN CTS, SDR 7.0	1		EA	


DESCRIPTION OF WORK COMPLETED	
Crew inserted service from valve to main Sewer is two feet under service	

PERSONNEL	
FOREMAN / WORKING LEADER / INSPECTOR	

SIGNATURE:	

DigSafe/ CBYD Number		PERMIT #	PROJECT # 99945	Unique ID :	7887516-10- [NW82]
ADDRESS: 366 ASH ST		TOWN:	NEW BEDFORD	DATE: 02/23/22	WORK ORDER- 7887516-10
URL: http://CWV-CLKSOPRD1/Repository/ cdy photo 002 054305(GOWUV015).jpg		LEAK REPORT #	LEAK CLASS	TYPE OF WORK:	GASCONSTR
SHEET 29 of 33		Contractor:	WAMFWO: 30292463	# WAMCTE	879836

5:35 PM Wed Feb 23

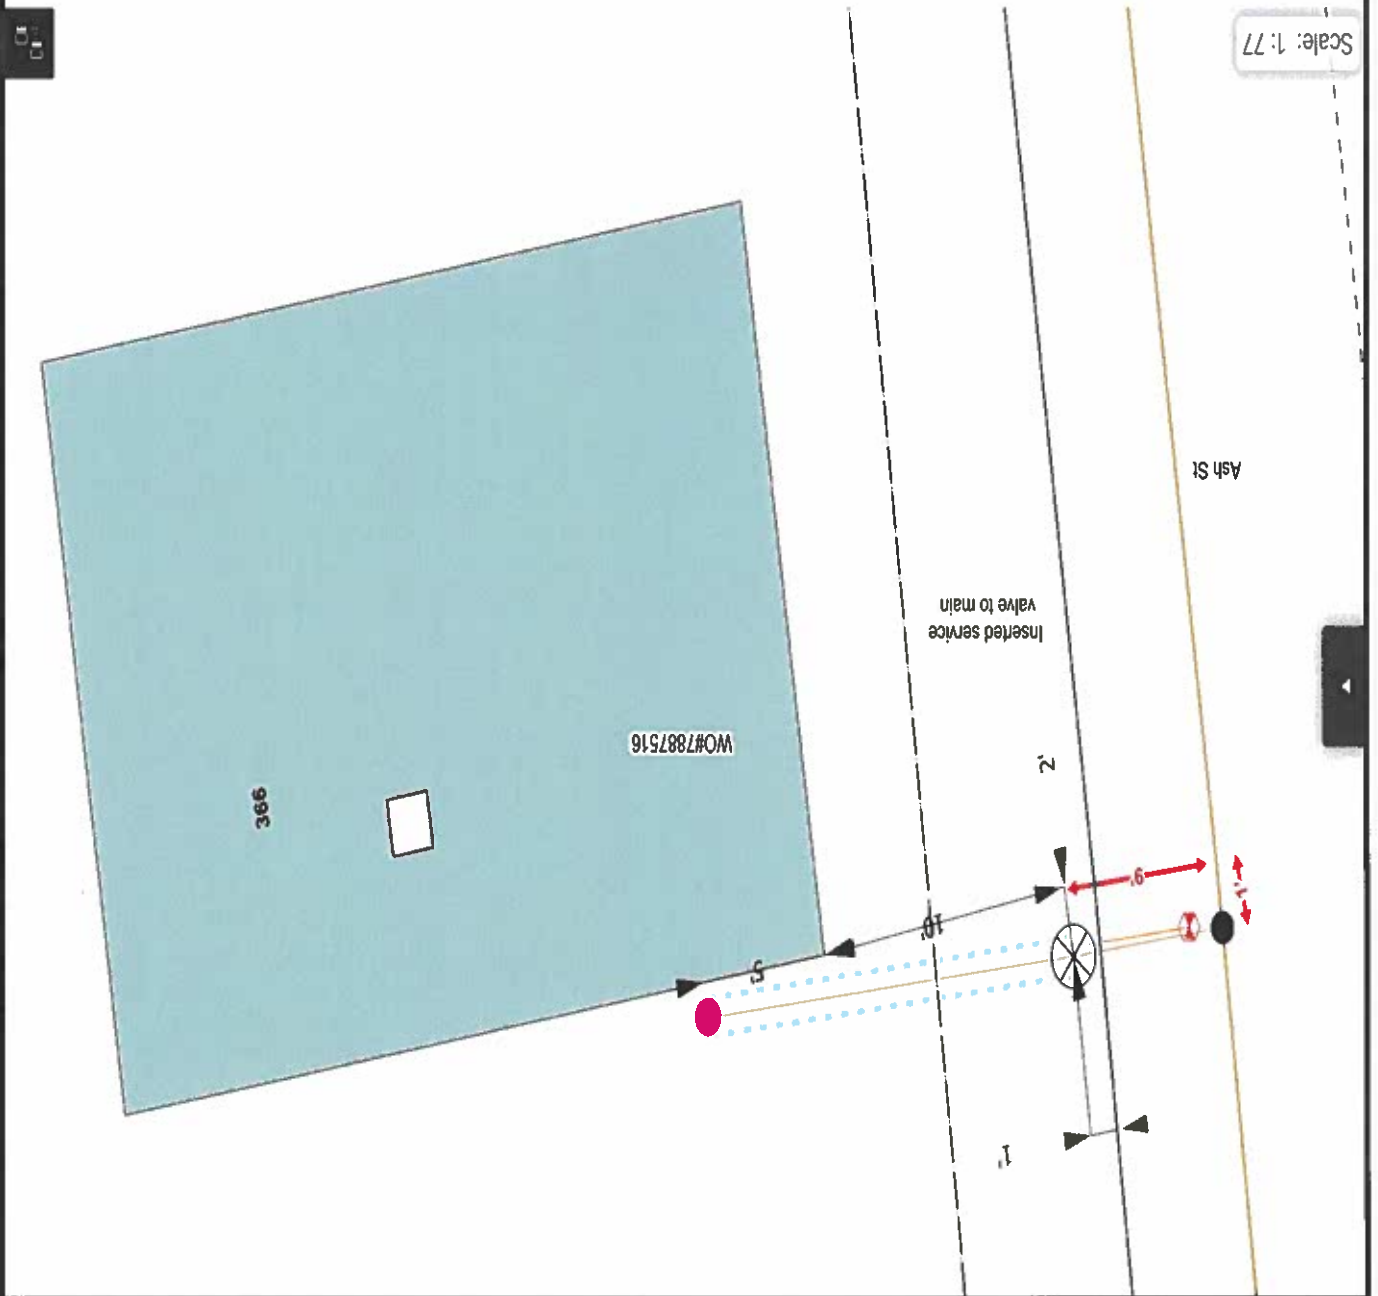

Scale: 1:77

User: tyrone.edwards@eversource.com Portal Group: EpochFieldCloud_Prod41_GasDist-MA
Mode: Map Markup - Arial|Black 10 pt