

TO THE MAYOR AND CITY COUNCIL: DISTURBANCE PERMIT/TRENCH SAFETY PERMIT

Permission is hereby requested to excavate the surface of: X City Property and/or X Private Property
Provide Sketch

Location of Work: 4299 Acushnet Ave.
May St to Tobey St
Emergency Gas Leak Repair

Work will begin (weather permitting) on: March 21, 2022

Applicant Name: Kevin O'Sullivan (ra) Excavator(s) Name: _____

Company Name: Eversource Hoisting Equipment License Number: _____
Grade: _____ Expiration Date: _____

Contact Number: 508-441-5817 Name & Contact Number of Insurer: _____

Competent Person on Work Site: ON FILE APPROVED BY: Stephen Oyster DATE: 9-11-22

TITLE: Asst. City Engineer

This permit shall be posted at the work site, and shall remain until the work is completed. It is subject to inspection at all times.

Work completed prior to D.P.L. approval under
emergency work order for Class II Leak Trenches must be maintained
weekly until final paving is
completed

ROADWAY CLOSURES WILL REQUIRE
AUTHORIZATION FROM THE
COMMISSIONER OF PUBLIC
INFRASTRUCTURE. TRAFFIC MANAGEMENT
PLANS MAY BE REQUIRED. Permit only valid for three months
from date of approval

DigSafe/
CBYD
Number
20221200643

PERMIT#

TOWN: NEW BEDFORD

PROJECT#

GAS-MLR0TH2Y

Unique ID :

8561071-10-[VG59]

ORDER-
TASK:

8561071-10

TYPE OF
WORK:

GASMAINTENANCE

LEAK
REPORT #

Contractor:

LEAK
CLASS

WAMFWO:

30300011

WAMCTE #

888080

PIPE RETIREMENT

No

PIPE INSPECTION

Main

FACILITY TYPE

MATERIAL SIZE

8

EXT PIPE COND

INT PIPE COND

EXT CORR COND

INT CORR COND

COATING

Poor

Poor

3' 3"

PIPE INSTALL

FACILITY
TYPE

MATERIAL SIZE

PRESSURE METHOD

OVERALL
PIPE LENGTHINSTALLED/
REPLACEDDEPTH
OF COVERCONNECTION
AT MAINEFV
INSTALLEDEFV
SUBTYPEEFV
COMMENTS

PRESSURE TEST

No

RESTORATION

No

MATERIALS

No

DESCRIPTION OF WORK COMPLETED

Dug on highest reading for class 2 leak. Bell joint in the hole was already booted and not leaking. There were no leaks on the main in the hole either.

PERSONNEL


FOREMAN / WORKING LEADER / INSPECTOR

SIGNATURE:

DigSafe/ CAYD Number	20221200643	PERMIT #		PROJECT #	GAS-MLR0TH2Y	Unique ID :	8561071-10- [VG59]
ADDRESS:	4299 ACUSHNET AVE	TOWN:	NEW BEDFORD	DATE:	03/21/22	WORK ORDER-	8561071-10
URL:	http://CWV-CLKSOPRD1/Repository/Files/cdy photo 001 020155(ayrbms1P).jpg	LEAK REPORT #		LEAK CLASS		TYPE OF WORK:	GASMAINTENANCE
SHEET 14 of 18		Contractor:		WAMFWO:	30300011	# WAMCTE	888080

7:01 AM Tue Mar 22

LTE 40% 9+

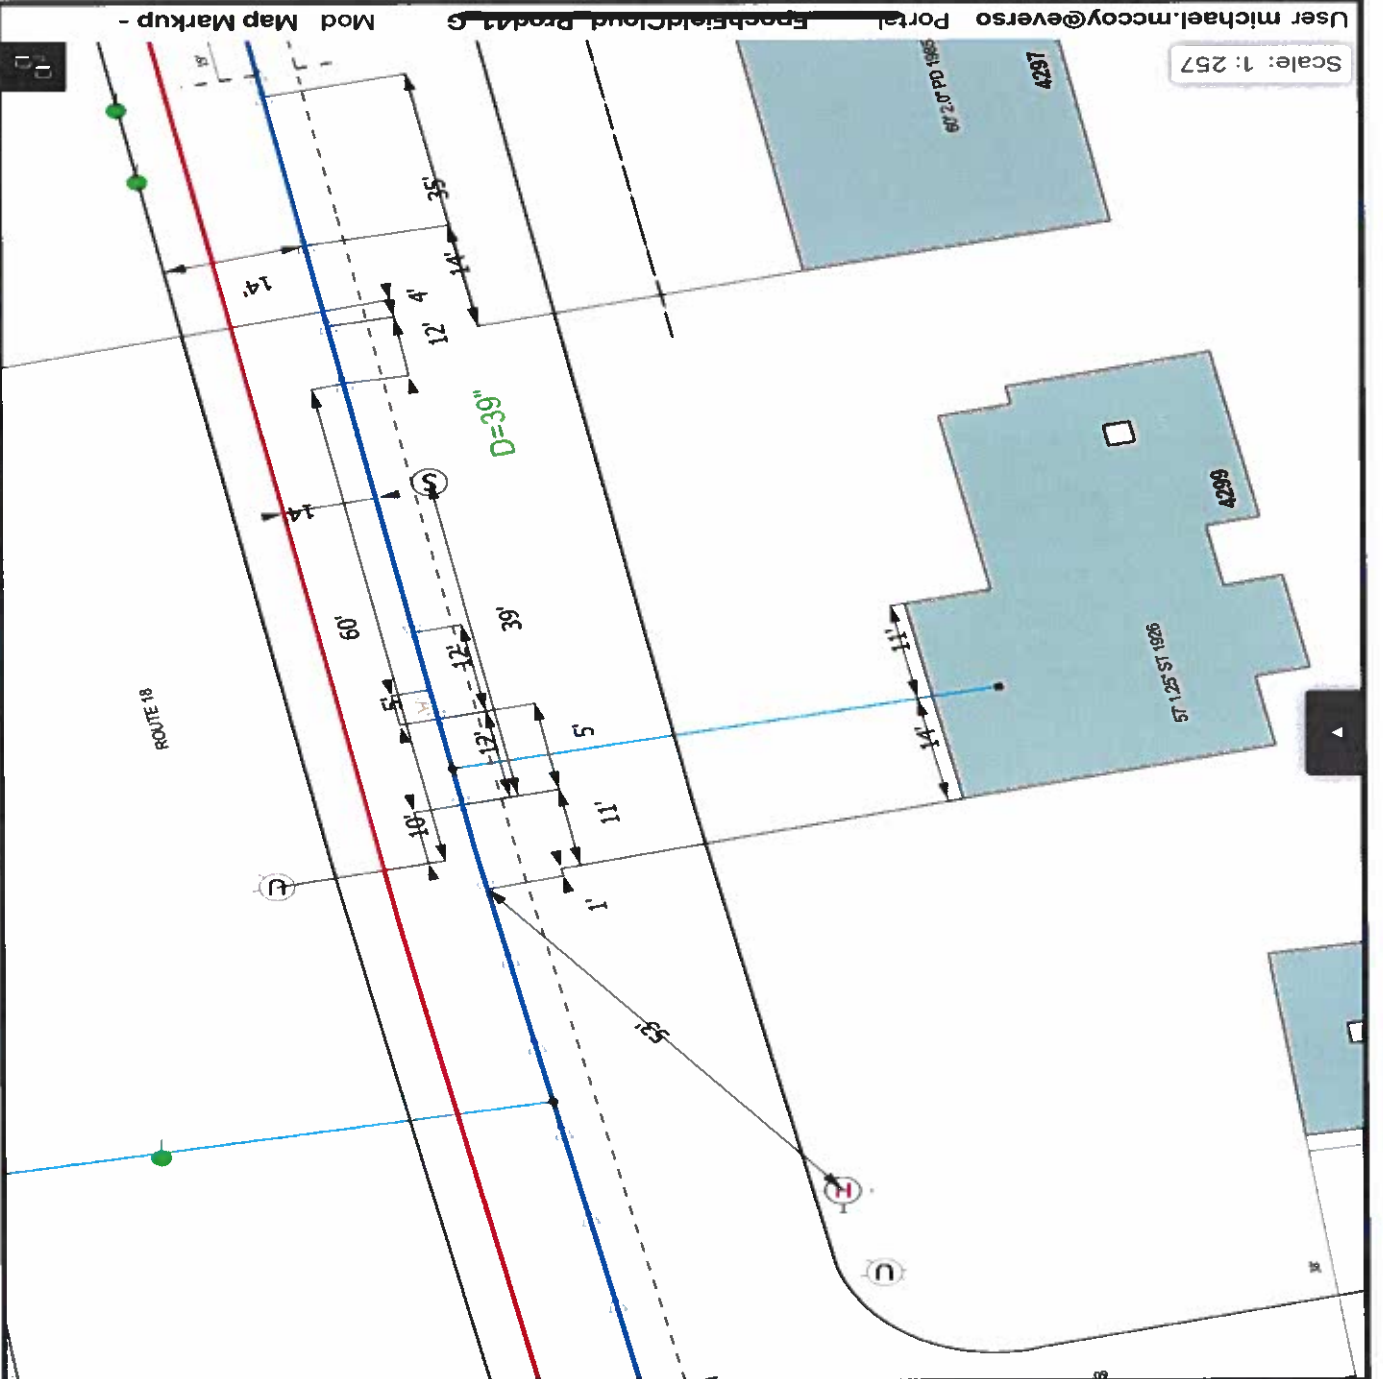

Scale: 1:257

User michael.mccoy@eversource.com

Mod Map Markup -