

APPLICATION/AGREEMENT

For Trench/Disturbance Permit within the City of New Bedford

Permit # 387 2022Dig Safe# 20220405702Date: 1/28/22

TO THE MAYOR AND CITY COUNCIL:

DISTURBANCE PERMIT/TRENCH SAFETY PERMIT

Permission is hereby requested to excavate the surface of: X City Property and/or X Private Property

Provide Sketch

Location of Work: 195 Brook St.Hathaway St. - Earle St.Emergency Gas Leak RepairWork will begin (weather permitting) on: January 28, 2022Applicant Name: Kevin O'Sullivan (ra)

Excavator(s) Name: _____

Company Name: Eversource

Hoisting Equipment License Number: _____

Grade: _____ Expiration Date: _____

Contact Number: 508-441-5817

Name & Contact Number of Insurer: _____

Competent Person on Work Site: ON FILEAPPROVED BY: Stephen Cupina DATE: 9-11-22TITLE: Asst City Engineer**This permit shall be posted at the work site, and shall remain until the work is completed. It is subject to inspection at all times.**Work completed prior to D.P.L. approval under
emergency work order for Class II LeakTrenches must be maintained
weekly until final paving is
completedROADWAY CLOSURES WILL REQUIRE
AUTHORIZATION FROM THE
COMMISSIONER OF PUBLIC
INFRASTRUCTURE. TRAFFIC MANAGEMENT
PLANS MAY BE REQUIRED.Permit only valid for three months
from date of approval

DAILY ACTIVITY REPORT


EVERSOURCE

DigSafe/ CBVD Number		20220405702		PERMIT#		PROJECT#		GAS-SRPRNL2Y		Unique ID : 7704961-10-[IN56]	
ADDRESS:		195 BROOK ST		TOWN:		NEW BEDFORD		DATE:		01/28/22	
SHEET 27 of 29		LEAK REPORT #		CONTRACTOR:		WAMFWO:		30286796		WAMCTE # 873092	
TYPE OF WORK:		GASCONSTR		ORDER-TASK:		7704961-10					
PIPE RETIREMENT FACILITY_TYPE PRESSURE LP VIN YR 2002 MATERIAL Plastic 1 SIZE 13 LENGTH PIPE INSPECTION No											
PIPE INSTALL FACILITY_TYPE Plastic 1" SIZE 11' LENGTH MATERIAL Plastic 1" SIZE 11' LENGTH PIPE INSTALL No											
PRESSURE TEST MEDIUM Air Service below 200 ft START TIME 2022-01-28 12:18:00 START PRESSURE(PSIG) 100 FINISH TIME 2022-01-28 12:40:00 FINISH PRESSURE(PSIG) 100 TEST DURATION 22min PERFORMED BY Jason arnuda SOAP TESTED Yes NOTES At all connections											
RESTORATION CONSTRUCTION MATERIAL Concrete LOCATION Sidewalk SURFACE FINISH Concrete EXISTING DEPTH 5 LENGTH 10'0" WIDTH 2'0" REQUIRED DEPTH 5" TEMPORARY REPAIR ACTION Compacted per O&M Standards COMPACTED % 100											
MATERIALS DESCRIPTION TYPE CATALOG ID SIZE Q.PLANNED Q.USED Unit of Measure SERIAL NUMBER											
DESCRIPTION OF WORK COMPLETED Installed 12' of 1" pi from valve to riser											
PERSONNEL FOREMAN / WORKING LEADER / INSPECTOR											
SIGNATURE:											

DigSafe/ CBYD Number	20220405702	PERMIT #		PROJECT #	GAS-SRPRNL2Y	Unique ID :	7704961-10- [IN56]
ADDRESS:	195 BROOK ST	TOWN:	NEW BEDFORD	DATE:	01/28/22	WORK ORDER-	7704961-10
URL:	https://CWV-CLKSOPR01/Repository/Files/cdy_photo_011_022022(weey2PWb).jpg						
SHEET 28 of 29	LEAK REPORT #	CONTRACTOR:		WAMFWO:	30286796	WAMCTE #	873092
	TYPE OF WORK:			CLASS			GASCONSTR

2:15 PM Fri Jan 28

LTE 47%

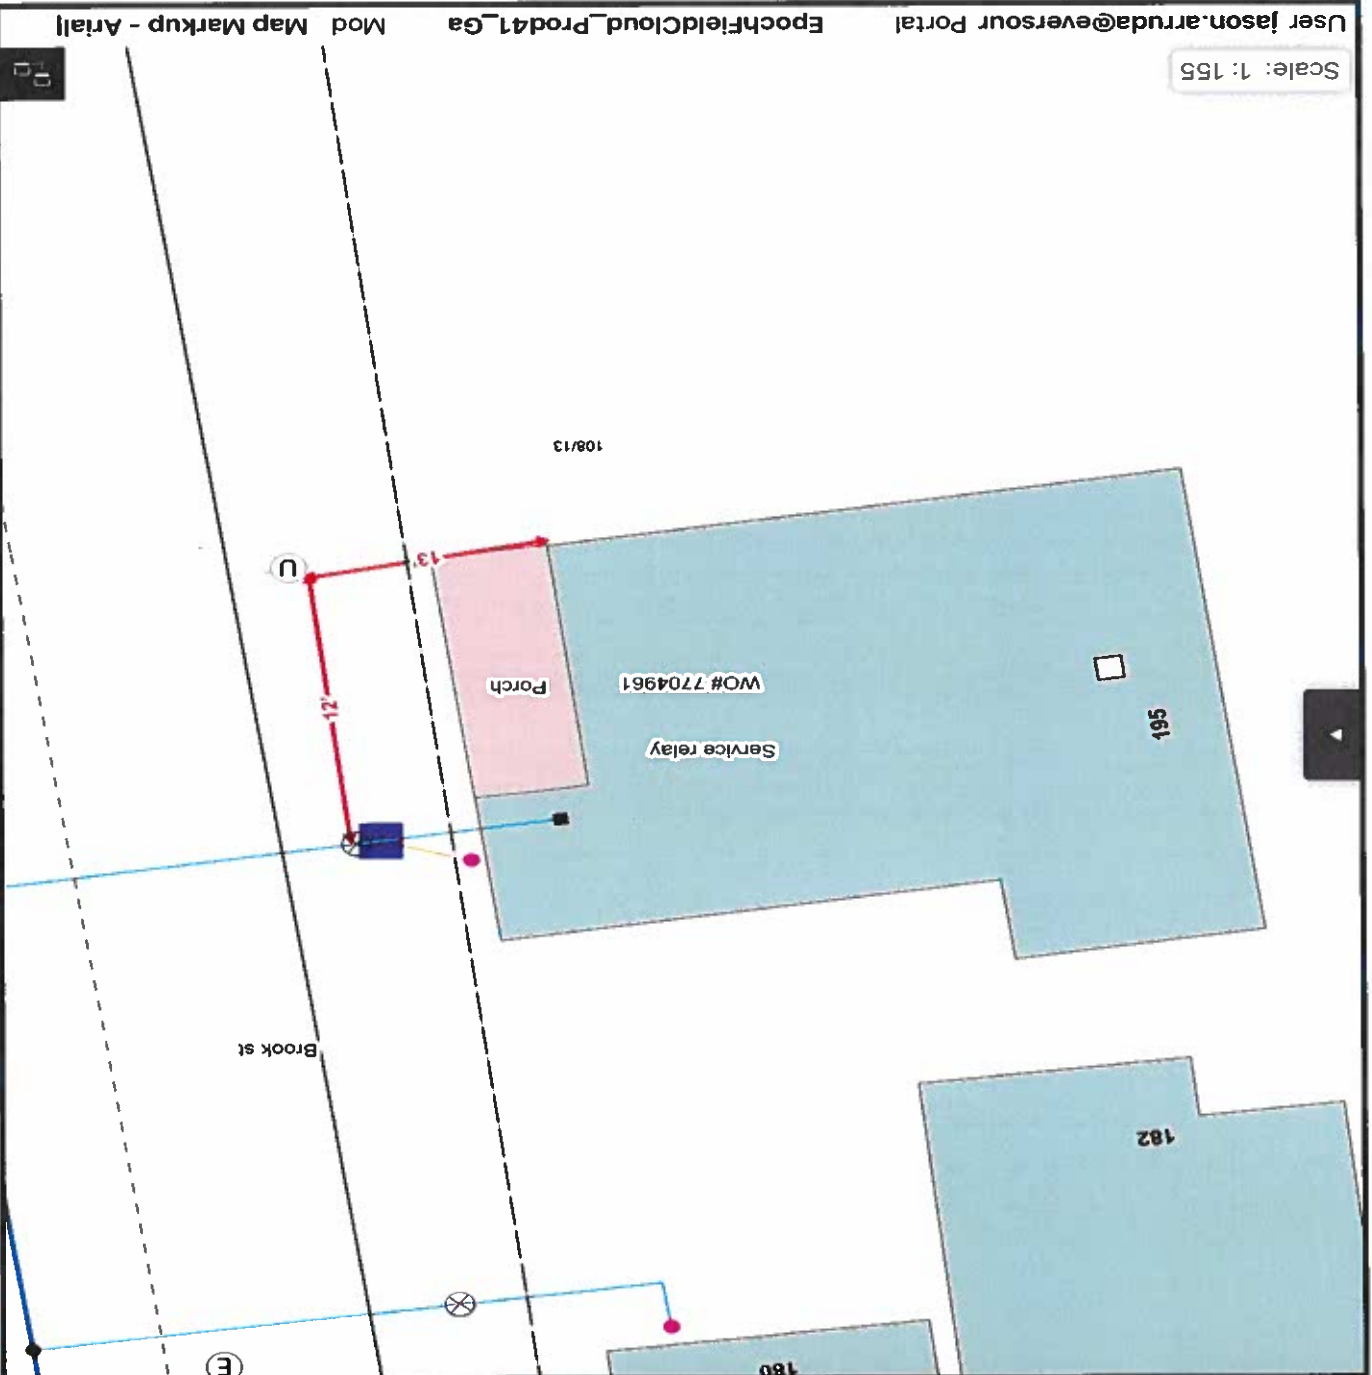

Scale: 1:155

User jason.arruda@eversour Portal

EpochfieldCloud_Prod41_Ga

Mod Map Markup - Aerial