



PERMIT NO.
25031

CITY OF NEW BEDFORD
SEWER AND/OR STORM DRAIN PERMIT

DATE 3-10-2003
Expire date: 3-10-2003

This certifies that permission is granted to

Property Owner MONIZ Holdings LLC P A Anthony Ter NB MA
Address 121 Pine Appleton St

To connect a sewer and/or storm drain located at NS 203 Ex Pine grove
Assessor's Plot 197E Lot 357, to the sewer and/or storm drain in Appleton St Street
4" 8" PVC sewer main

To be laid in accordance with the conditions in this application and the City of New Bedford ordinances.
TYPE OF USE: RESIDENTIAL COMMERCIAL INDUSTRIAL FLOW _____ G.P.D.

If applicant other than actual property owner, attach Letter of Authorization from Property Owner.
Name RT Contessa Tel 508 971-4911
Mailing Address _____
The Bonded Contractor/Drain Layer authorized to perform this work is:

Name _____ Address SDR 35 Ave Tel _____
Type of Pipe Required: 10"

PERMIT EXPIRES ONE YEAR AFTER DATE OF ISSUE

- Requires separate connections for sewage and storm drain where applicable. Storm water cannot be discharged to a sanitary sewer.
 - All work must be inspected and approved by a D.P.L. inspector before backfilling.
 - If this connection is to be part of a private service shared jointly with other building owners, attach copy of Recorded Joint Maintenance Agreement.
 - Permits can be issued to Industrial and/or Commercial Applicants only upon receipt and approval by the Commissioner of Public Infrastructure of required plans and supplemental information.
 - In addition, a City-issued Industrial User Discharge Permit and/or a Sewer Extension/Connection Permit issued by the Commonwealth of Massachusetts D.E.P. shall be required by the City for Industrial Discharge into the sewer system.
- Industrial User Discharge Permit No. _____ Date _____

Conn. Mass. Sewer Conn./Ext. Permit No. _____ Date _____
A Filing and Inspection Fee of \$ 450, plus an Entrance Fee of \$ _____ where applicable, must accompany this application.

Bank# BankBoston Check# 1630 Date 3-10-2003 Receipt# 3791293

Other requirements: Single - Family New Construction

Connection made to Sewer Part of jointly-shared private line YES ☐ NO ☒
Storm Drain

Applicant agrees to abide by the above terms, as well as all pertinent ordinances of the City of New Bedford, and such other special rules as the Commissioner of Public Infrastructure and/or City Engineer may deem necessary


Stephen Croft
Asst. City Engineer
Signature of Property Owner or Representative

INSPECTOR'S REPORT

INSPECTED BY: _____

DATE: _____

COMMENTS: _____

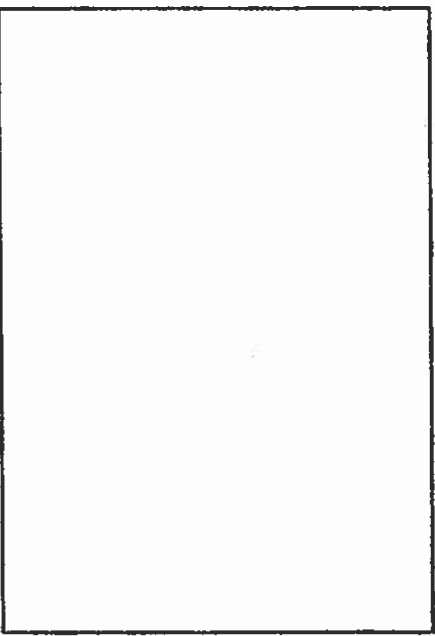

APPROVED _____ DISAPPROVED _____

SKETCH PLAN

SIGNATURE

MAP 127E LOT 370

MAP 127E LOT 372



S 78°37'30" E 80.43'

MAP 127E LOT 357
6,438 S.F.

MAP 127E LOT 411

MAP 127E LOT 261

N 11°04'30" E 80.05'

S 11°04'30" W 80.05'

MAP 127D LOT 176

N 78°37'30" W 80.43'

EXISTING
FOUNDATION
TOF: 99.26'

31.9'

11.0'

13.5'

22.1'

APPLETON

(PUBLIC - 50' WIDE)

STREET

AS-BUILT FOUNDATION PLAN

APPLETON STREET
IN
NEW BEDFORD, MA




I CERTIFY THAT THE FOUNDATION SHOWN
HEREON, AS BUILT, WAS LOCATED AS A
RESULT OF AN INSTRUMENT SURVEY.

Jonathan J. Pink
PROFESSIONAL LAND SURVEYOR 3-9-22 DATE

DATE: MARCH 9, 2022

SCALE: 1" = 20'

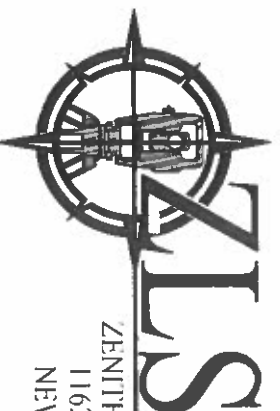

ZENITH LAND SURVEYORS, LLC
1162 ROCKDALE AVENUE
NEW BEDFORD, MA 02740
(508) 995-0100



FOUNDATION PERMIT

No. B-21-3287

MSBC Sect. 111.8 - Any permit issued shall be deemed abandoned and invalid unless the work authorized by it shall have been commenced within six (6) months after its issuance.

FEE PAID \$100.00

This certifies that Daniel MONIZ

owner/contractor has permission to:

NS-

APPLETON ST

127E-

357

on:

Foundations Only 1-2 Family - 100.00

Providing that the person accepting this permit shall in every respect conform to the terms of application therefore on file in this office; to the provisions of the statute of the Commonwealth and to the by-laws of the City of New Bedford relating to the inspection, erection, enlarging, altering, raising, moving, repairing, or tearing down of a building.

Permit is issued subject to the following special requirements: (Restrictions)



Wiring Inspector



Plumbing Inspector



Building Inspector

YOUR AREA INSPECTOR IS: Thomas Welch

Tel. (508) 979-1540 Between 8:00am - 9:00am

OCCUPANCY PERMIT REQUIRED BEFORE OCCUPANCY

No Building or Structure shall be used or occupied until the Certificate of Use and Occupancy shall have been issued by the Building Commissioner - MSBC, Sect. 120.1

NOTICE: NOTIFY INSPECTOR 48 HOURS IN ADVANCE OF APPLYING SHEATHING OR LATHING

This Card Must Be Displayed in a Conspicuous Place on the Premises and Not Torn Down or Removed Until Completion of Work

SUBJECT TO MASSACHUSETTS
STATE BUILDING CODE

Dan Moniz Jr

MISCELLANEOUS PAYMENT RECPT#: 3791293
City of New Bedford
Office of the Treasurer
133 William Street
New Bedford, MA 02740

DATE: 03/10/22 TIME: 05:39:33
CLERK: a450mmb DEPT: WATER
CUSTOMER#: 0

COMMENT:

CHK: DP1SEW OPT SEWER PERM1 450.00

REVENUE:	
1 63906000 422185	450.00
Sewer Permit Fee	
PERMIT 25031	
CASH:	
TW05 101009	450.00
WEB5537	

AMOUNT PAID: 450.00

PAID BY: MONIZ HOLDINGS
PAYMENT METH: CHECK
MR1630

REFERENCE:

AMT TENDERED: 450.00
AMT APPLIED: 450.00
CHANGE: .00