

APPLICATION/AGREEMENT  
For Trench/Disturbance Permit within the City of New Bedford

Permit # 100-2023  
Dig Safe# 20222100636  
Date: 05/23/2022

TO THE MAYOR AND CITY COUNCIL: DISTURBANCE PERMIT/TRENCH SAFETY PERMIT

Permission is hereby requested to excavate the surface of: X City Property and/or X Private Property  
Provide Sketch

Location of Work: 118 Locust St  
Between Richmond St & Cedar St. working in street and street to house.  
Emergency Gas Line Maintenance

Work will begin (weather permitting) on: May 23, 2022

Applicant Name: Steven Botelho (gk) Excavator(s) Name: \_\_\_\_\_

Company Name: Eversource Hoisting Equipment License Number: \_\_\_\_\_  
Grade: \_\_\_\_\_ Expiration Date: \_\_\_\_\_

Contact Number: 508-441-5817 Name & Contact Number of Insurer: \_\_\_\_\_  
\_\_\_\_\_

Competent Person on Work Site: ON FILE

APPROVED BY: Shirley J. J. J. J. DATE: 5-23-2023  
TITLE: program director - permit org

This permit shall be posted at the work site, and shall remain until the work is completed. It is subject to inspection at all times.

Trench repair: trench must go  
curb line to curb line the entire width  
of trench.

Trenches must be maintained  
weekly until final paving is  
completed

ROADWAY CLOSURES WILL REQUIRE  
AUTHORIZATION FROM THE  
COMMISSIONER OF PUBLIC  
INFRASTRUCTURE. TRAFFIC MANAGEMENT  
PLANS MAY BE REQUIRED.

Work completed prior to D.P.L. approval under  
emergency work order for Class III Leak

Permit only valid for three months  
from date of approval

DESCRIPTION	TYPE	CATALOG ID	SIZE	Q.PLANNED	Q.USED	Unit of Measure	SERIAL NUMBER
LG, TRACER WIRE CLIP/PROTECTOR, 50/BOX, GPI PART #TS125X6		587834		1		EA	
LOCK,EQUIPMENT, TAMPER PROOF, EXPANDABLE, 3 IN LG SHANK, W/ HEX HEAD SHEAR-OFF SCREW, ALUMOWELD RING	TAMPER PROOF	564930		1	1	EA	
RISER, PREFORMED, ANODELESS, PREBENT, FBE STEEL X HDPE, 1-1/4"-11-1/2NPTX1-1/4"CTS.090WALL, 36" TALL		591038		1	1	EA	
FITTING,COUPLING, METFIT, 1-1/4 IN CTS X 0.090 THK WALL SDR 15.3, ASTM F1924 , TO JOIN PE GAS DISTR PIPE AND TUBING, REPLACED IN 500835	METFIT	583759	1-1/4 IN CTS X 0.090 THK WALL SDR 15.3	3	3	EA	
VALVE,BLEED, EXCESS FLOW, BLACK, 1 IN IPS X 10 IN LG, #P32, PLASTIC, SDR 11, PE4710, SERIES 300	EXCESS FLOW, BLACK	603285	1 IN IPS X 10 IN LG	1		EA	
CABLE, INSULATED, MDP, #12 AWG, 7 STR, YELLOW, POLYETHYLENE-30, SOFT DRAWN CU, 500 FT/RL, FOR USED AS PIPE LOCATOR	INSULATED	513679		100	35	FT	
ANCHOR, EXPANSION, MASONARY, 3/8 IN, 1-7/8 IN LG, W/ BOLT, WASHER, FOR STABILIZER BRACKETS, 50/BOX	EXPANSION, MASONARY	535958	3/8 IN	2		EA	

#### DESCRIPTION OF WORK COMPLETED

Relay 1" plastic service

#### PERSONNEL


FOREMAN / WORKING LEADER / INSPECTOR

SIGNATURE:

DigSafe/ CBYD Number	20222100636	PERMIT#		PROJECT#	99958	Unique ID :	9107770-10- [UU69]
ADDRESS:	118 LOCUST ST	TOWN:	NEW BEDFORD	DATE:	05/23/22	WORK ORDER- TASK:	9107770-10
URL:	<a href="http://CWV-CLKSOPRD1/Repository/Files/cdv_photo_001_010828(xtuJwfU8).jpg">http://CWV-CLKSOPRD1/Repository/Files/cdv_photo_001_010828(xtuJwfU8).jpg</a>	LEAK REPORT #		LEAK CLASS		TYPE OF WORK:	GASCONSTR
SHEET 88 of 92		Contractor:		WAMFWO:	30347157	WAMCTE #	915367

1:07 PM Mon May 23

LTE VPN 74%

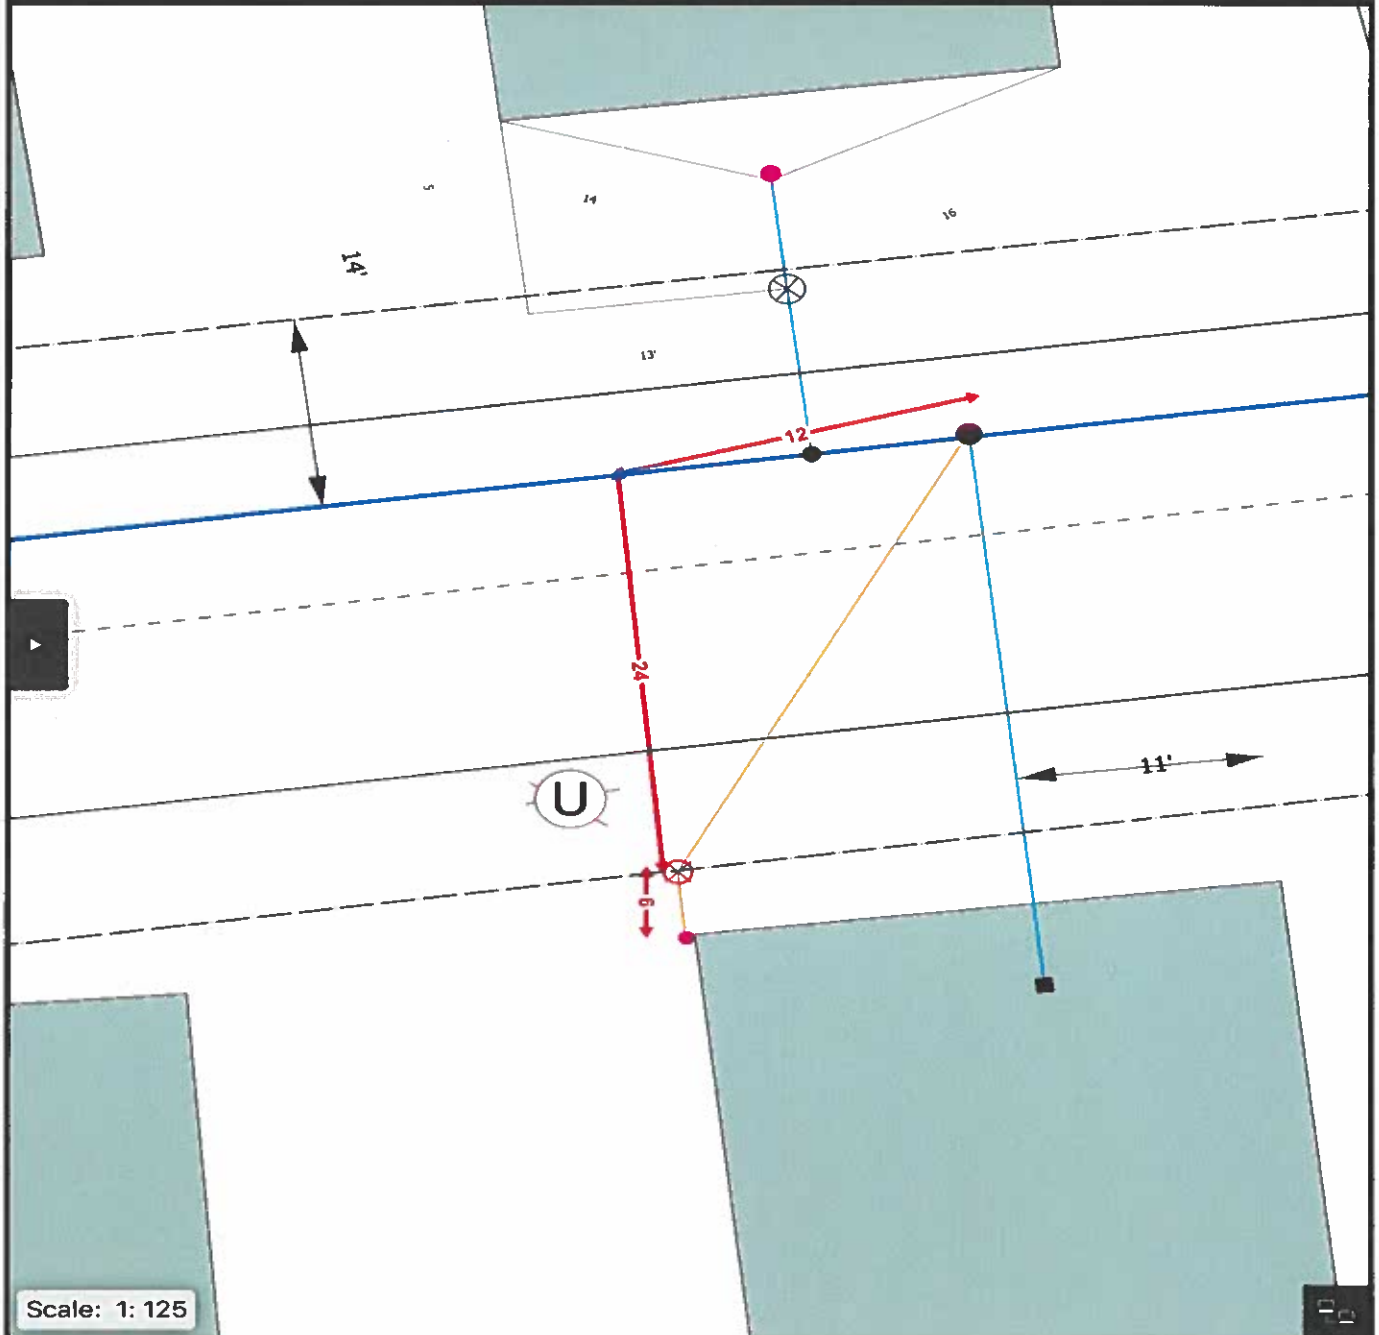

Scale: 1:125

Use thaddeus.makuch.1@evers Portal

EpochFieldCloud\_Prod41\_

Mod Map Markup -

DigSafe/ CBYD Number	20222100636	PERMIT#		PROJECT#	99958	Unique ID :	9107770-10-[UU69]
ADDRESS:	118 LOCUST ST	TOWN:	NEW BEDFORD	DATE:	05/23/22	WORK ORDER- TASK:	9107770-10
SHEET 86 of 92		LEAK REPORT #		LEAK CLASS		TYPE OF WORK:	GASCONSTR
		Contractor:		WAMFWO:	30347157	WAMCTE #	915367

## PIPE RETIREMENT

FACILITY_TYPE	MATERIAL	SIZE	LENGTH	PRESSURE	VIN YR
	Bare Steel	1	33	LP	1901

## PIPE INSPECTION

FACILITY TYPE	MATERIAL	SIZE	EXT PIPE COND	INT PIPE COND	EXT CORR COND	INT CORR COND	COATING	DEPTH OF COVER
Main	Cast Iron	4	Poor	NA	Poor	NA	Poor	3' 0"

## PIPE INSTALL

FACILITY TYPE	MATERIAL	SIZE	LENGTH	PRESSURE	METHOD	OVERALL PIPE LENGTH	INSTALLED/REPLACED	DEPTH OF COVER	CONNECTION AT MAIN	EFV INSTALLED	EFV SUBTYPE	EFV COMMENTS
Service	Plastic	1"	35'	LP	Direct Bury	60' or Less	Full Service	2' 0"	Mechanical Saddle	No		

## PRESSURE TEST

MEDIUM	TYPE	START TIME	START PRESSURE(PSIG)	FINISH TIME	FINISH PRESSURE(PSIG)	TEST DURATION	PERFORMED BY	SOAP TESTED	NOTES
Air	Service below 200 ft	2022-05-23 11:45:00	110	2022-05-23 12:00:00	110	15min	Makuch	Yes	Pass

## RESTORATION

CONSTRUCTION MATERIAL	LOCATION	EXISTING SURFACE FINISH	EXISTING DEPTH	LENGTH	WIDTH	REQUIRED DEPTH	TEMPORARY REPAIR ACTION	COMPACTION METHOD	% COMPACTED
Hot Asphalt	Street	Asphalt/Concrete	6	0' 0"	0' 0"	6"		Compacted per O&M Standards	100

## MATERIALS

DESCRIPTION	TYPE	CATALOG ID	SIZE	Q.PLANNED	Q.USED	Unit of Measure	SERIAL NUMBER
VALVE,METERING, INSULATING, LOCK-WING TAMPER PROOF, 1-1/4 X 1-1/4 IN, TUBE, BLACK FINISH, 5/BOX	INSULATING, LOCK-WING TAMPER PROOF	563160	1-1/4 X 1-1/4 IN	1		EA	
TEE,PIPE, NON-BLOWING, 3/4 IN X 1 IN IPS PLASTIC X 3/8 IN PERF SDR 11, WELD INLET X COMPRESSION OUTLET ENDS, LIGHT WALL, STEEL	NON-BLOWING	560685	3/4 IN X 1 IN IPS PLASTIC X 3/8 IN PERF SDR 11	1			
BRACKET, STABILIZER, W/CAP SCREW FOR METER BAR, FOR 3/4 - 1-1/4 IN PIPE	STABILIZER	541600		1		EA	
PIPE, 1-1/4 IN CTS X 0.090 IN THK WALL SDR 15.3, 1-3/8 IN OD, 500 FT LG COIL, POLYETHYLENE, PE3408/PE100		554021	1-1/4 IN CTS X 0.090 IN THK WALL SDR 15.3	100	35	FT	
	NON-BLOWING		3/4 IN X 1 IN IPS PLASTIC X 3/8 IN PERF SDR 11		1	EA	
COUPLING,PIPE, REDUCER, 1 IN IPS SDR 11 X 1-1/4 IN CTS 0.090 WALL, STAB ENDS, PLASTIC, PE4710	REDUCER	544457	1 IN IPS SDR 11 X 1-1/4 IN CTS 0.090 WALL	1		EA	
FITTING,SLEEVE, 1-1/2 X 18 IN, 100/BOX, NSTAR M-2501		578032	1-1/2 X 18 IN	1	1	EA	
VALVE,BALL, REDUCED PORT, 1-1/4 IN CTS 0.090 IN THK WALL, SDR 15.3, PE 4710, BUTT FUSE, POLYETHYLENE, BLACK FINISH. REPLACED IN 561837		604429	1-1/4 IN CTS 0.090 IN THK WALL, SDR 15.3	1	1	EA	
MANIFOLD,METER, BYPASS BAR, PRE-ASSEMBLED, W/O REGULATOR, SPC M-4, 2/BX	BYPASS BAR	592069		1		EA	
BOX VALVE, CURB, W/ 4-1/4 IN SQ COVER NON-LOCKING LID, FOR 1/2 , 3/4, 1 , 1-1/4 , CURB VALVES, PAVEMENT RISER RING IN 583489, 48/SKID	CURB	577812		1	1	EA	
CLIP,PIPE, UV STABILIZED PVC/ACRYLIC, FOR 1-1/4 IN PIPE, 6		587834		1		EA	