

APPLICATION/AGREEMENT

Permit # 48-30033

For Trench/Disturbance Permit within the City of New Bedford

Dig Safe#20221603883

Date: 04/19/2022

TO THE MAYOR AND CITY COUNCIL:

DISTURBANCE PERMIT/TRENCH SAFETY PERMIT

Permission is hereby requested to excavate the surface of: X City Property and/or X Private Property

Provide Sketch

Location of Work: 132 Central Ave.Emergency Gas Line MaintenanceWork will begin (weather permitting) on: April 19, 2022Applicant Name: Kevin O'Sullivan (gk)

Excavator(s) Name: _____

Company Name: Eversource

Hoisting Equipment License Number: _____

Grade: _____ Expiration Date: _____

Contact Number: 508-441-5817

Name & Contact Number of Insurer: _____

Competent Person on Work Site: ON FILEAPPROVED BY: Yvonne DupireDATE: 4-14-2023TITLE: program ductile - permits eng

This permit shall be posted at the work site, and shall remain until the work is completed. It is subject to inspection at all times.

Trench repair - final trench patch must go curbline to curbline for width of trenchWork completed prior to D.P.I. approval under
emergency work order for Class II LeakTrenches must be maintained
weekly until final paving is
completedPermit only valid for three months
from date of approvalROADWAY CLOSURES WILL REQUIRE
AUTHORIZATION FROM THE
COMMISSIONER OF PUBLIC
INFRASTRUCTURE. TRAFFIC MANAGEMENT
PLANS MAY BE REQUIRED.

For any work done on City Property the following additional regulations apply:

The applicant hereby specifically acknowledges and agrees to this permit, if granted, becomes a legally binding AGREEMENT, between said applicant and the City of New Bedford for permission to disturb/excavate the surface of City sidewalks and roadways, and as such is subject to all of the terms and conditions, including current bonding and surety deposit requirements, of the various sections of Chapter 22 of the Code of Ordinances of the City of New Bedford, all of which are incorporated herein and made a part of this APPLICATION/AGREEMENT, No permit shall be granted until said terms and conditions have been met.

In the event that this permit is granted, the following requirements shall also be met:

- a. That sufficient barriers, lights, and warning signs shall be erected and maintained by the Permittee in such a manner as to notify pedestrian and/or operators of motor vehicles properly approaching the work site of the hazard(s) occasioned by said work. One or more signs conveying the following message or its equivalent: "STREET CLOSED: PASS AT OWN RISK" OR "ROAD UNDER CONSTRUCTION, PASS AT OWN RISK" must be prominently displayed as directed by the Commissioner of the Department of Public Infrastructure.
- b. That the roadways and sidewalks shall not be unnecessarily obstructed and, so far as possible, safe and convenient ways for the use of foot travelers and vehicles shall be maintained.
- c. That the trenches or excavations shall be backfilled as directed by the Commissioner of the Department of Public Infrastructure, whose orders shall be final and conclusive.
- d. All pavement surfaces of roadways and sidewalks disturbed shall be restored by the permittee in accordance with approved City specifications of the Department of Public Infrastructure, and within such time limits set by the Commissioner.
- e. The applicant assumes full responsibility for maintenance of the pavement restoration for a period of three (3) years from the date the City considers the restoration to be completed.

The applicant shall hold the City of New Bedford harmless and indemnify it for any and all injury to loss, cost, damage, expense, (including reasonable attorney fees) and liability on account of the disturbance of said street surface and any work done in connection therewith.

Any permit for disturbance/excavation within the surface of the public right-of ways, as herein provided, may be revoked by the Mayor and City Council under the provision of law.

Permits for disturbing/excavating the surface of public right-of-ways shall be issued by the City Clerk, subject to ratification by the Mayor and City Council; said permits to be provisional until ratified as aforesaid. Any owner who has been refused a provisional permit shall have the right to a hearing before the Mayor and City Council.

Persons engaging in any trenching operation shall familiarize themselves with the federal safety standards promulgated by the Occupational Safety and Health Administration (OSHA) on excavations: 29 CFR 1926.650 et.seq., entitled Subpart P Excavations."



By applying for, accepting and signing this permit, the applicant attests to the following:

- a. that he has read and understood 520 CMR 14.00 promulgated by the Department of Public Safety with regard to trench safety;
- b. that he has read and understood the federal safety standards promulgated by the Occupational Safety and Health Administration on excavations: 29 CFR 1926.650 et.seq., entitled Subpart P "Excavations".

EVERSOURCE										DAILY ACTIVITY REPORT													
DigSafe/		20221603883		PERMIT #		PROJECT#		GAS-ATSCRAZY		Unique ID :		6309151-10-[0094]		WORK ORDER-6309151-10		TASK: 6309151-10		TYPE OF WORK: GASMAINTENANCE		WAMCITE # 900922			
ADDRESS:		132 CENTRAL AVE		TOWN:		NEW BEDFORD		DATE:		04/19/22													
SHEET 16		LEAK REPORT #		LEAK CLASS		WAMFWO: 30299582		WAMCITE # 900922															
PIPE RETIREMENT																							
No																							
PIPE INSPECTION																							
No																							
PIPE INSTALL																							
FACILITY TYPE		MATERIAL		SIZE		LENGTH		PRESSURE		METHOD		OVERALL PIPE LENGTH		INSTALLED/REPLACED		DEPTH OF COVER		CONNECTION AT MAIN		EFV SUBTYPE		EFV COMMENTS	
PRESSURE TEST																							
MEDIUM		TYPE		START TIME		START PRESSURE(PSIG)		FINISH TIME		FINISH PRESSURE(PSIG)		TEST DURATION		PERFORMED BY		SOAP TESTED		NOTES					
Air		Service below 200 ft		2022-04-19 12:34:00		100		2022-04-19 12:50:00		100		16min		Jason arruda		Yes		At all connections					
RESTORATION																							
CONSTRUCTION MATERIAL		LOCATION		EXISTING SURFACE FINISH		EXISTING DEPTH		LENGTH		WIDTH		REQUIRED DEPTH		TEMPORARY REPAIR ACTION		COMPACTION METHOD		% COMPACTED					
Hot Asphalt		Street		Asphalt		4		6'0"		5'0"		4"				Compacted per O&M Standards		100					
Concrete		Private Property		Concrete		4		6'0"		3'0"		4"											
Dirt		Treebelt		Grass				6'0"		6'0"													
MATERIALS																							
DESCRIPTION		TYPE		CATALOG ID		SIZE		Q.PLANNED		Q.USED		Unit of Measure		SERIAL NUMBER									
Valve		1								1													
Riser		1																					
DESCRIPTION OF WORK COMPLETED																							
Installed 45 feet of 1 inch plastic from Main to house... Used same hole from old tee whole hog entire service... Installed two bumper posts due to space limitations bumper posts are in line with face of meters not 8" off face due to space limitations																							
PERSONNEL																							
FOREMAN / WORKING LEADER / INSPECTOR																							
SIGNATURE:																							

DigSafe/ CBVD Number	20221603883	PERMIT #		PROJECT #	GAS-ATSCRAZY	Unique ID :	6309151-10- [Q994]
ADDRESS:	132 CENTRAL AVE	TOWN:	NEW BEDFORD	DATE:	04/19/22	WORK ORDER-	6309151-10
URL:	http://CWV-CLKSOPRDI/Repository/Files/cdy_photo_002_083117(KS9Yb1b).jpg	LEAK REPORT #		LEAK CLASS		TYPE OF WORK:	GASMAINTENANCE
SHEET 17 of 93		Contractor:		WAMFWO:	30299582	#	WAMCTE 900922

8:17 PM Tue Apr 19

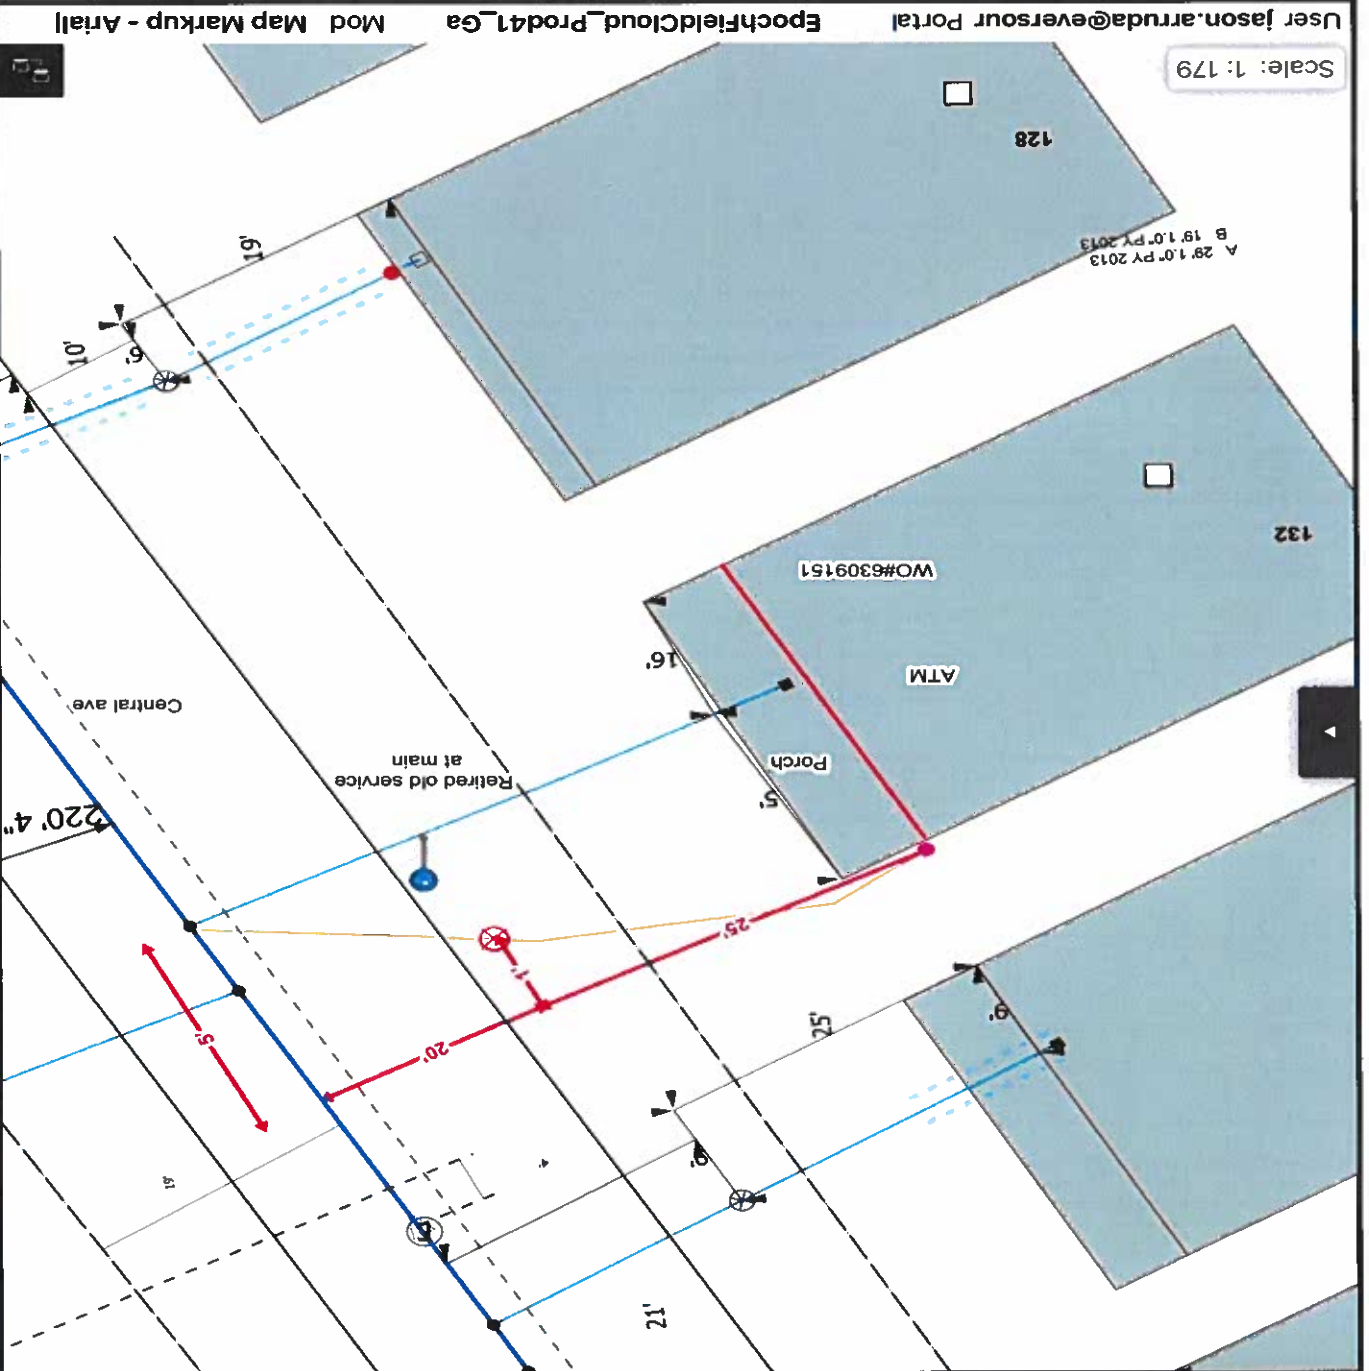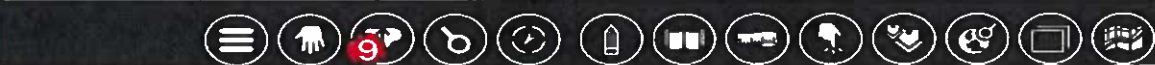

Scale: 1:179

User jason.arruda@eversour Portal

EpochFieldCloud_Prod41_Ga

Mod Map Markup - Aerial