

APPLICATION/AGREEMENT

Permit # 92-2023

For Trench/Disturbance Permit within the City of New Bedford

Dig Safe#20223102692

Date: 08/01/2022

TO THE MAYOR AND CITY COUNCIL:

DISTURBANCE PERMIT/TRENCH SAFETY PERMIT

Permission is hereby requested to excavate the surface of: X City Property and/or X Private Property
Provide SketchLocation of Work: 170 Dartmouth St
Corner property with Rockland St. Working in the street and street to house on Rockland St side.
Emergency Gas Line MaintenanceWork will begin (weather permitting) on: August 1, 2022Applicant Name: Steven Botelho (gk) Excavator(s) Name: _____Company Name: Eversource Hoisting Equipment License Number: _____

Grade: _____ Expiration Date: _____

Contact Number: 339-987-8010 Name & Contact Number of Insurer: _____Competent Person on Work Site: ON FILEAPPROVED BY: Amadeo J. J. J. DATE: 08-17-2023TITLE: program director eng permits

This permit shall be posted at the work site, and shall remain until the work is completed. It is subject to inspection at all times.

ROADWAY CLOSURES WILL REQUIRE
AUTHORIZATION FROM THE
COMMISSIONER OF PUBLIC
INFRASTRUCTURE, TRAFFIC MANAGEMENT
PLANS MAY BE REQUIRED.Work completed prior to D.P.I. approval under
emergency work order for Class II Leak


Trench repair: current trench left @ work
location is not to specification. Trench must
be backfilled to original line the width of trench

Trenches must be maintained
weekly until final paving is
completedPermit only valid for three months
from date of approval

DigSafe/ CBYD Number		PERMIT#		PROJECT#	99991	Unique ID :	9949143-20- [BB33]
ADDRESS:	170 DARTMOUTH ST	TOWN:	NEW BEDFORD	DATE:	08/02/22	WORK ORDER- TASK:	9949143-20
URL:	http://CWV-CLKSOPRD1/Repository/Files/cdv_photo_001_043307(7QhBXhlo).jpg	LEAK REPORT #		LEAK CLASS		TYPE OF WORK:	GASCONSTR
SHEET 109 of 112		Contractor:		WAMFWO:	30401068	WAMCTE #	947148

ClickMobile 4:32 PM Tue Aug 2

LTE VPN 39%

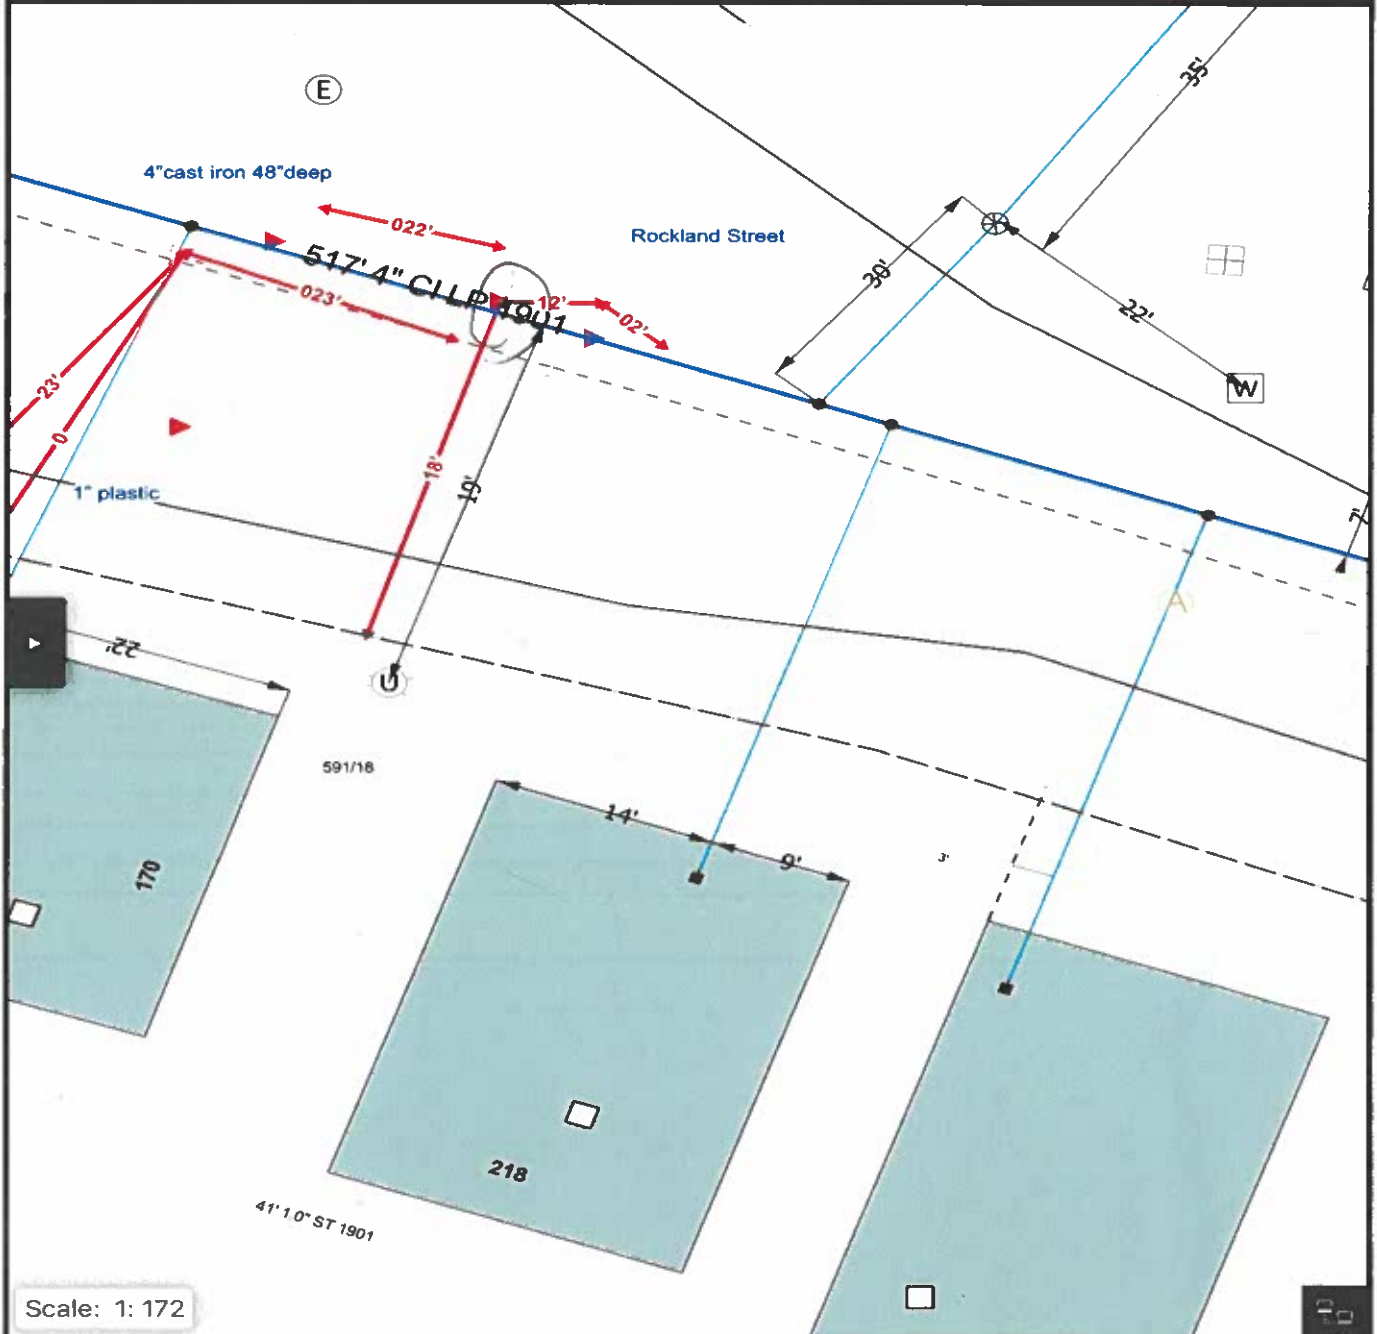

Scale: 1:172

Use christopher.sylvia@evers Portal

EpochFieldCloud_Prod41_G

Mod Map Markup -

DigSafe/ CBYD Number		PERMIT #		PROJECT #	99991	Unique ID :	9949143-20-[BB33]
ADDRESS:	170 DARTMOUTH ST	TOWN:	NEW BEDFORD	DATE:	08/02/22	WORK ORDER- TASK:	9949143-20
SHEET 108 of 112		LEAK REPORT #		LEAK CLASS		TYPE OF WORK:	GASCONSTR
		Contractor:		WAMFWO:	30401068	WAMCTE #	947148

PIPE RETIREMENT

No

PIPE INSPECTION

No

PIPE INSTALL

FACILITY TYPE	MATERIAL	SIZE	LENGTH	PRESSURE	METHOD	OVERALL PIPE LENGTH	INSTALLED/ REPLACED	DEPTH OF COVER	CONNECTION AT MAIN	EFV INSTALLED	EFV SUBTYPE	EFV COMMENTS
								0'0"				

PRESSURE TEST

No

RESTORATION

CONSTRUCTION MATERIAL	LOCATION	EXISTING SURFACE FINISH	EXISTING DEPTH	LENGTH	WIDTH	REQUIRED DEPTH	TEMPORARY REPAIR ACTION	COMPACTION METHOD	% COMPACTED
Hot Asphalt	Street	Asphalt	3	16'0"	5'0"	4"		Compacted per O&M Standards	100

MATERIALS

DESCRIPTION	TYPE	CATALOG ID	SIZE	Q.PLANNED	Q.USED	Unit of Measure	SERIAL NUMBER
PLCS Kit		4			2		
ENCAPSULATION KIT, 6 IN		577968	6 IN	2		EA	

DESCRIPTION OF WORK COMPLETED

Sylvia, Moniz, Timlin Drilled and probed opened best reading and found leaking bell joints 4" repaired and retook readings COMPLETE

PERSONNEL

FOREMAN / WORKING LEADER / INSPECTOR

SIGNATURE: