

TO THE MAYOR AND CITY COUNCIL: DISTURBANCE PERMIT/TRENCH SAFETY PERMIT

Permission is hereby requested to excavate the surface of: X City Property and/or X Private Property
Provide Sketch

Location of Work: 786 Belleville Ave.

Sylvia St - Howard Ave
Emergency Gas Line Maintenance

Work will begin (weather permitting) on: March 21, 2022

Applicant Name: Kevin O'Sullivan (ra) Excavator(s) Name: _____

Company Name: Eversource Hoisting Equipment License Number: _____
Grade: _____ Expiration Date: _____

Contact Number: 508-441-5817 Name & Contact Number of Insurer: _____

Competent Person on Work Site: ON FILE APPROVED BY: Monica Lupina DATE: 3.23.2023

TITLE: program directed - permit log.

This permit shall be posted at the work site, and shall remain until the work is completed. It is subject to inspection at all times.

General trench repair to go center line to curb line the width of trench & then to one of new pavement.


Trenches must be maintained
weekly until final paving is
completed

ROADWAY CLOSURES WILL REQUIRE
AUTHORIZATION FROM THE
COMMISSIONER OF PUBLIC
INFRASTRUCTURE. TRAFFIC MANAGEMENT
PLANS MAY BE REQUIRED.

DigSafe/ CBYD Number	20221200733	PERMIT#		PROJECT#	GAS-MLROTH2Y	Unique ID :	7822119-10-[RE70]
ADDRESS:	786 BELLEVILLE AVE	TOWN:	NEW BEDFORD	DATE:	03/21/22	WORK ORDER- TASK:	7822119-10
URL:	http://CWV-CLKSOPRD1/Repository/Files/cdv_photo_001_023553(Ba92TurH).jpg	LEAK REPORT #		LEAK CLASS		TYPE OF WORK:	GASMAINTENANCE
SHEET 19 of 20		Contractor:		WAMFWO:	30290541	WAMCTE #	887833

ClickMobile 2:31 PM Mon Mar 21

LTE VPN 100%

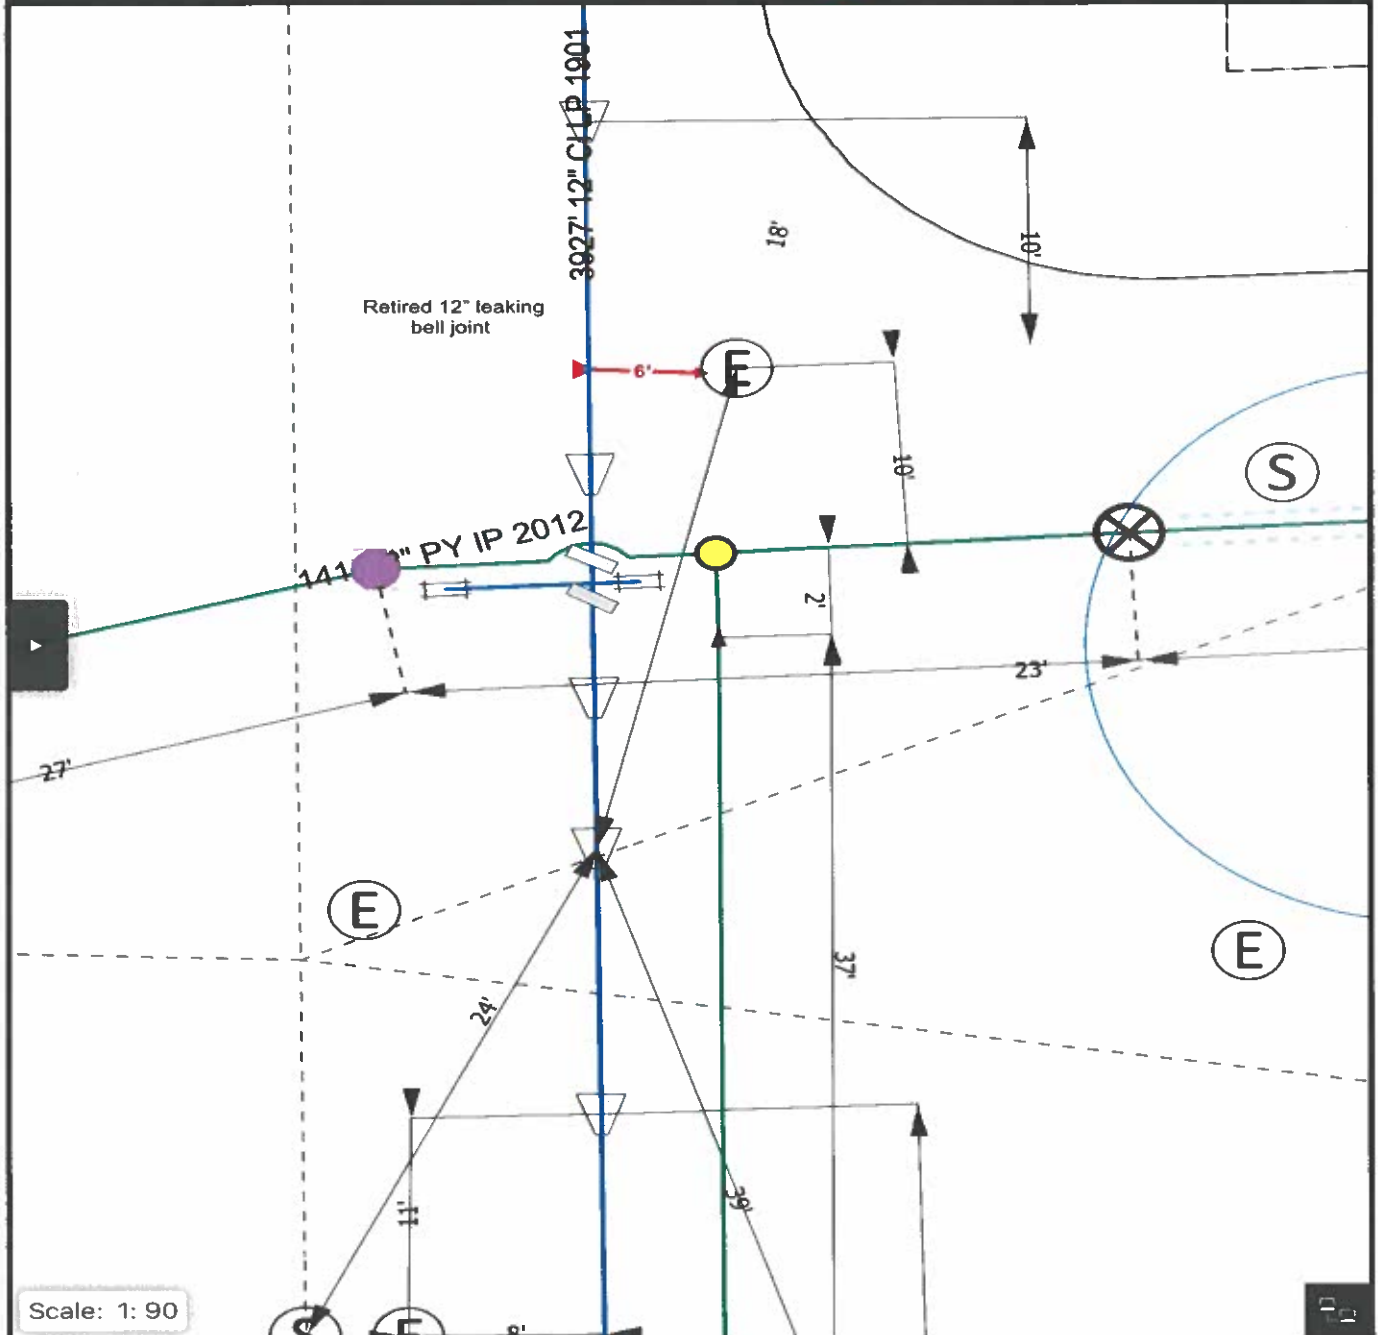

Scale: 1: 90

User william.sylvia@eversou Portal

EpochFieldCloud_Prod41_Ga

Mod Map Markup - Arial

DigSafe/ CBYD Number	20221200733	PERMIT#		PROJECT#	GAS-MLROTH2Y	Unique ID :	7822119-10-[RE70]
ADDRESS:	786 BELLEVILLE AVE	TOWN:	NEW BEDFORD	DATE:	03/21/22	WORK ORDER- TASK:	7822119-10
SHEET 18 of 20		LEAK REPORT #		LEAK CLASS		TYPE OF WORK:	GASMAINTENANCE
		Contractor:		WAMFWO:	30290541	WAMCTE #	887833

PIPE RETIREMENT

No

PIPE INSPECTION

FACILITY TYPE	MATERIAL	SIZE	EXT PIPE COND	INT PIPE COND	EXT CORR COND	INT CORR COND	COATING	DEPTH OF COVER
Main	Cast Iron	12	Fair	NA	Fair	NA	Fair	3' 0"

PIPE INSTALL

FACILITY TYPE	MATERIAL	SIZE	LENGTH	PRESSURE	METHOD	OVERALL PIPE LENGTH	INSTALLED/ REPLACED	DEPTH OF COVER	CONNECTION AT MAIN	EFV INSTALLED	EFV SUBTYPE	EFV COMMENTS
								0' 0"				

PRESSURE TEST

No

RESTORATION

CONSTRUCTION MATERIAL	LOCATION	EXISTING SURFACE FINISH	EXISTING DEPTH	LENGTH	WIDTH	REQUIRED DEPTH	TEMPORARY REPAIR ACTION	COMPACTION METHOD	% COMPACTED
Hot Asphalt	Street	Asphalt	4	7' 0"	5' 0"	4"		DCP	100

MATERIALS

No

DESCRIPTION OF WORK COMPLETED

Repair leaking 12" bell joints

PERSONNEL

FOREMAN / WORKING LEADER / INSPECTOR

SIGNATURE: