

APPLICATION/AGREEMENT
For Trench/Disturbance Permit within the City of New Bedford

Permit # 99.2023
Dig Safe#20223012601
Date: 07/28/2022

TO THE MAYOR AND CITY COUNCIL: DISTURBANCE PERMIT/TRENCH SAFETY PERMIT

Permission is hereby requested to excavate the surface of: X City Property and/or X Private Property
Provide Sketch

Location of Work: 41 Linden St
Cross street State Street. Working in the street and street to house.
Emergency Gas Line Maintenance

Work will begin (weather permitting) on: July 28, 2022

Applicant Name: Steven Botelho (gk) Excavator(s) Name: _____

Company Name: Eversource Hoisting Equipment License Number: _____
Grade: _____ Expiration Date: _____

Contact Number: 339-987-8010 Name & Contact Number of Insurer: _____

Competent Person on Work Site: ON FILE

APPROVED BY: Shirley J. J. J. J. DATE: 7/28/2023
TITLE: program director - permitting

This permit shall be posted at the work site, and shall remain until the work is completed. It is subject to inspection at all times.

*Final trench repair must be from center line
to curb line on center line at each
land trench. Current trench work not
at city construction standard.*

Work completed prior to D.P.L. approval under
emergency work order for Class II Leak

ROADWAY CLOSURES WILL REQUIRE
AUTHORIZATION FROM THE
COMMISSIONER OF PUBLIC
INFRASTRUCTURE. TRAFFIC MANAGEMENT
PLANS MAY BE REQUIRED.


Trenches must be maintained
weekly until final paving is
completed

Permit only valid for three months
from date of approval

DigSafe/ CBYD Number		PERMIT#		PROJECT#	GAS-EMGGAS2Y	Unique ID :	9904552-10-[XV40]
ADDRESS:	41-45 LINDEN ST	TOWN:	NEW BEDFORD	DATE:	07/28/22	WORK ORDER- TASK:	9904552-10
URL:	http://CWV-CLKSOPRD1/Repository/Files/cdy_photo_001_044328(x6hx7Y85).jpg	LEAK REPORT #		LEAK CLASS		TYPE OF WORK:	GASMAINTENANCE
SHEET 38 of 49		Contractor:		WAMFWO:	30397856	WAMCTE #	946274

4:32 PM Fri Jul 29

0 1 LTE (VPN) 55%

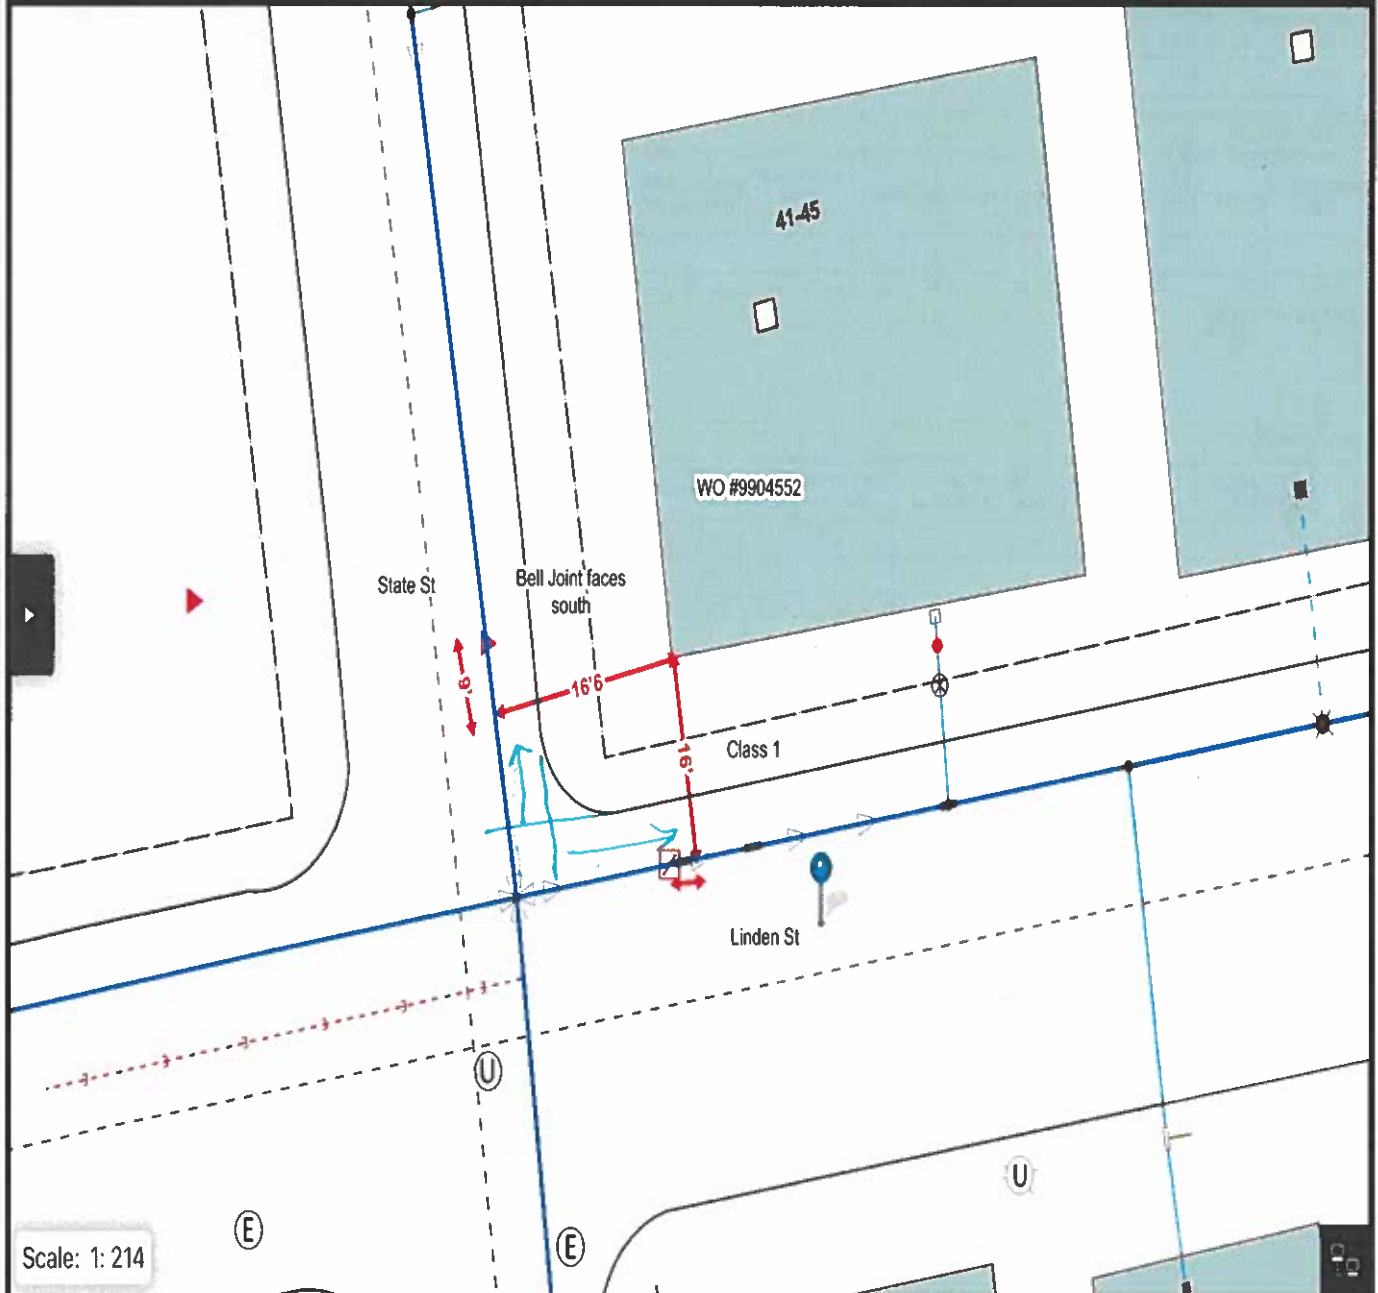

Scale: 1: 214


User: tyrone.edwards@eversource.com Portal Group: EpochFieldCloud_Prod41_GasDist-MA

Mode: Map Markup - Arial|Black 10 pt

DigSafe/ CBYD Number		PERMIT#		PROJECT#	GAS-EMGGAS2Y	Unique ID :	9904552-10-[XV40]
ADDRESS:	41-45 LINDEN ST	TOWN:	NEW BEDFORD	DATE:	07/28/22	WORK ORDER- TASK:	9904552-10
URL:	http://CWV-CLKSOPRD1/Repository/Files/cdv_photo_002_044338(fvKcijzm).jpg	LEAK REPORT #		LEAK CLASS		TYPE OF WORK:	GASMAINTENANCE
SHEET 39 of 49		Contractor:		WAMFWO:	30397856	WAMCTE #	946274

4:22 PM Fri Jul 29

LTE (VPN) Not Charging

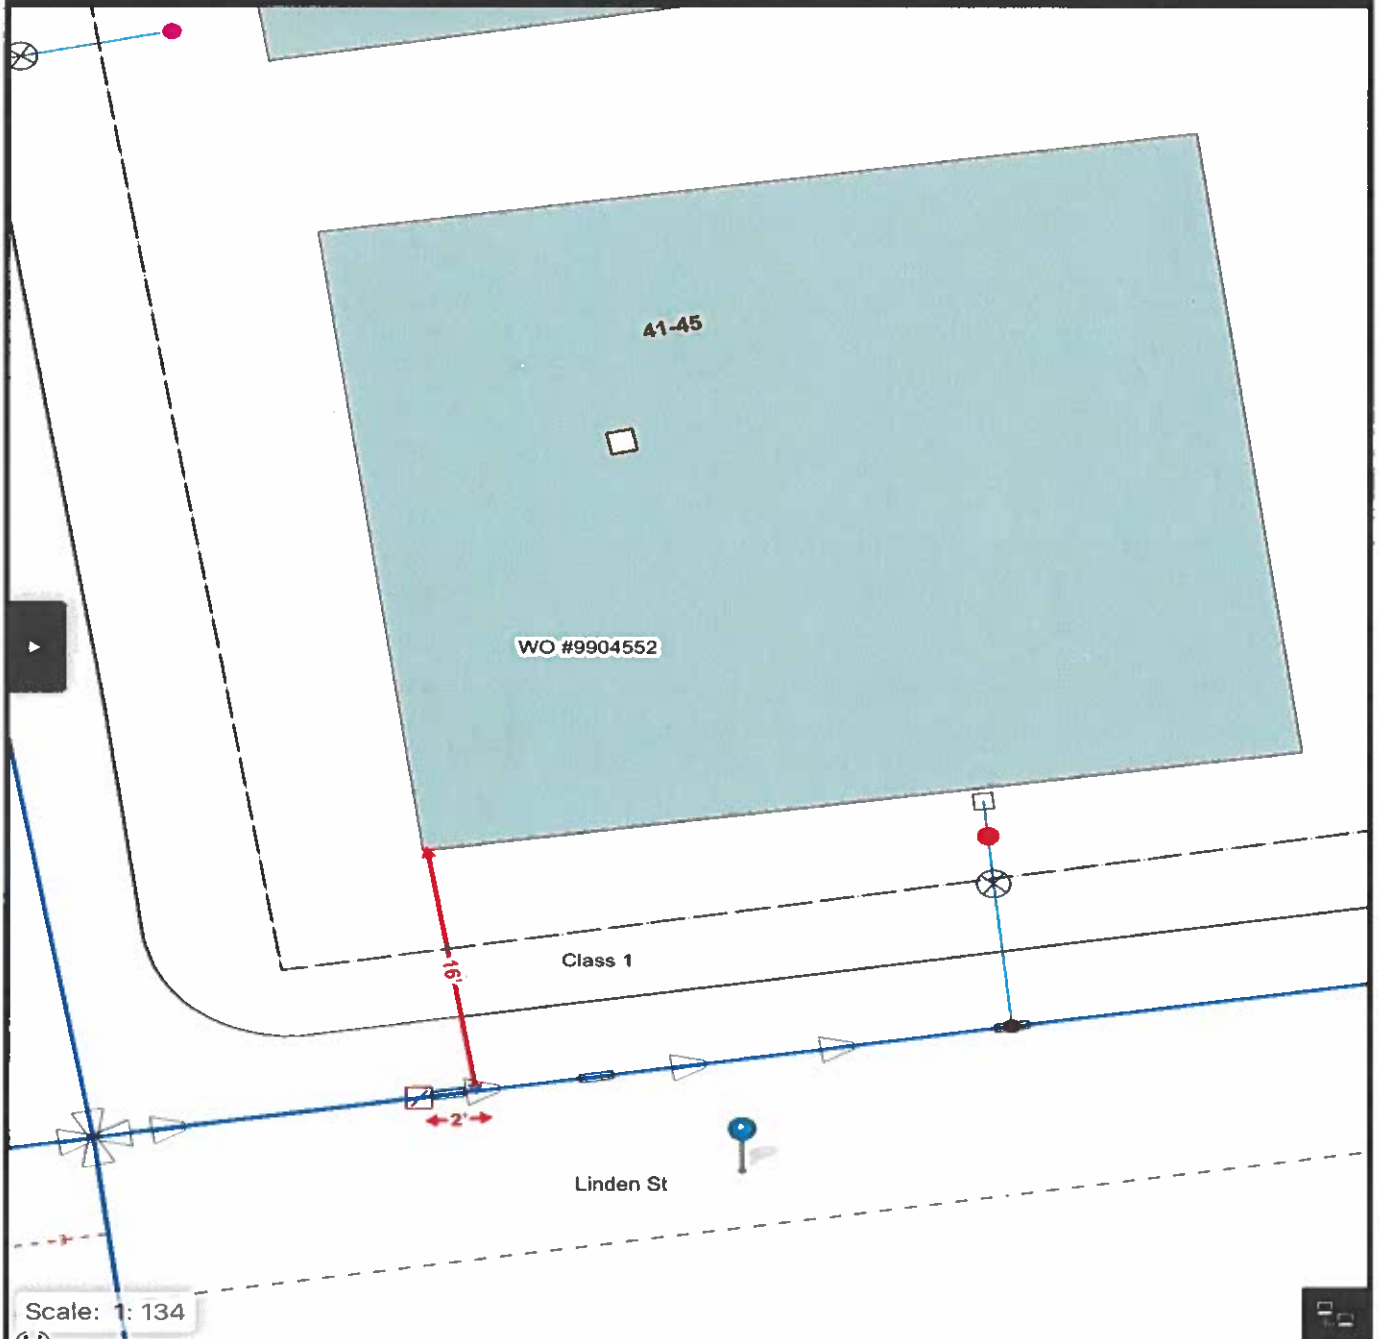

Use tyrone.edwards@eversource Portal

EpochFieldCloud_Prod41_G

Mod Map Markup - Arial