

C.K.

NOTICE TO SUPERINTENDENT OF STREETS.



10347

Drain Permit No. 10348

City of New Bedford,

OCT 8 1918

Office of City Clerk, 191

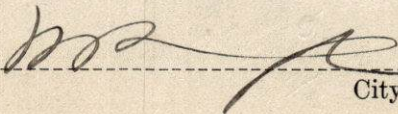
To Superintendent of Streets.

Permission has this day been issued to

Name E. J. Jarvis Address 166 Bullock St.

to lay drain from premises northeast corner of Athol
and Bullock Sts.

to connect with sewer in Bullock street.


City Clerk.

Return of Foreman.

Entered Oct 21 1918.

Time 1 P.M.

By Frank B. DeHolt

COST.

Labor	44 hours @ 41	17	88
	17 "	7	44
	6 "	3	75
	"	29	07
	"		
	"		
	"		
	"		
Stock	Cement		50
	Shovel & Trench		
	Churn & Barrels		
	Dirt Machine		
Carting			
Total Cost		29	57
Deposit		850	00
Balance due		20	43

Pieces pipe to curb-----

“ “ curb to house_____

Cut at Sewer.....

Cut at curb 6 1/2

Size of pipe ----- 6 in -----

Correct _____

Foreman.