

NOTICE TO SUPERINTENDENT OF STREETS.

Drain Permit No. 10400

City of New Bedford,

MAR 18 1919

Office of City Clerk, _____ 191

To Superintendent of Streets.

Permission has this day been issued to

Name

Jacob Genesky

Address

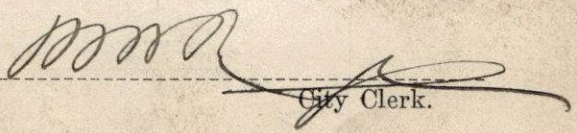
69 Russell St.

to lay drain from premises

N. E. corner Union
& Sixth Sts.

to connect with sewer in

Union street.


City Clerk.

Return of Foreman.

Entered April 21 191 9

Time 2 P.M.

By Frank C. Miller

COST.

Labor	70 1/2 hours @ 41	28 64
	48 " 44	21 00
	19 " 63	5 63
	"	55 27
	"	
	8 " 41	3 25
	8 " 44	3 50
	3 " 63	1 88
Stock		63 90
<u>Cement</u>		20
Carting		50
Total Cost		64 60
Deposit		20 —
Balance due		44 60

Pieces pipe to curb

" " curb to house 2

Cut at Sewer

Cut at curb 10 ft

Size of pipe 6 in

Correct

Frank C. Miller

Foreman.