

W.K

NOTICE TO SUPERINTENDENT OF STREETS.

Drain Permit No. 10550

City of New Bedford,

Office of City Clerk, _____

AUG 14 1919

191

To Superintendent of Streets.


Permission has this day been issued to

Name Tom Spencer Address 303 Brook St.

to lay drain from premises Thomas Spencer

east side Church St. near Queny St

to connect with sewer in Church street.

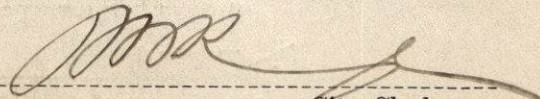

City Clerk.

Return of Foreman.

Entered Oct 1 191 9
 Time 1 P.M.
 By Frank H. DeHaller

COST.

Labor	44 hours @ 47	20 62
	16 " 50	8 00
	6 " 69	4 13
		<u>32 75</u>
Stock	<u>Comano</u>	25
	<u>Patrick Bodan</u>	
	<u>Harold Jamille</u>	
	<u>Dirt before</u>	
Carting		50
Total Cost		<u>33 50</u>
Deposit		35 00
Balance due		<u>1 50</u>

Pieces pipe to curb 2
 " " curb to house 2
 Cut at Sewer 2 ft
 Cut at curb 2 ft
 Size of pipe 6 in
 Correct

Frank H. DeHaller
 Foreman.