

O. R.

NOTICE TO SUPERINTENDENT OF STREETS.



Drain Permit No. 10561

City of New Bedford,

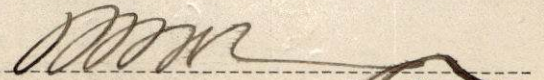
Office of City Clerk, AUG 23 1919 191

To Superintendent of Streets.

Permission has this day been issued to

Name Trade & Fernandes Address 73 Davis St.

to lay drain from premises of John Trade and Jacintho
Fernandes, on the southwest corner of Davis & Belleville Ave
to connect with sewer in Davis street.


City Clerk.

Return of Foreman.

Entered Oct 6 1919.

Time 11 A.M.

By Frank B. DeHelle

COST.

Labor	27 1/2 hours @ 47	12 90
	16 1/2 " 50	8 25
	5 " 69	3 44
	"	24 59
	"	
	"	
	"	
	"	
Stock	Cement	25
	Patience Gardner	
	Karl Jacinto	
	Water Board Roadman	
	12 - 2 1/2 ft	
Carting		50
	12 ft. x 3 ft. x 6.36 ft. x 4.11	10 36
Total Cost		35 70
Deposit		15 00
Balance due		20 70

Pieces pipe to curb 7

" " curb to house 2

Cut at Sewer 9 ft

Cut at curb 8 ft

Size of pipe 6 in

Correct

Frank B. DeHelle

Foreman.