

O.K.

NOTICE TO SUPERINTENDENT OF STREETS.

Drain Permit No. 10566
10567

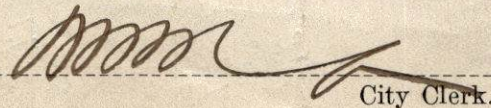
City of New Bedford,

Office of City Clerk, AUG 27 1919 191

To Superintendent of Streets.

Permission has this day been issued to

Name Joel Roy et al Address 1527 Acushnet Ave.
to lay drain from premises Joel Roy & Simon Besenovsky
n.e. cor. Acushnet Ave. & Eugenia St. (2 pipes)
to connect with sewer in Eugenia street.


City Clerk.

Return of Foreman.

Entered Oct. 25 1919.

Time Joseph Zmarier

By _____

COST.

Labor	hours @		
per day 3.75	16 $\frac{1}{2}$	" 047	7.24
" 4.00	31	" 050	15.50
" 5.50	5 $\frac{1}{2}$	" 069	3.78
			<u>26.55</u>
	9	" 047	4.21
	21	" 050	10.50
	4	" 069	2.75
Stock			<u>44.01</u>
<u>cement</u>			2.5
<u>14 ft. Tarnice</u>			14.22
Carting			60
Total Cost			<u>58.98</u>
Deposit			<u>35.00</u>
Balance due			<u>23.98</u>

Pieces pipe to curb 7 ft. 6 in

6 ft. 6 in curb to house

Cut at Sewer 10 ft 2

Cut at curb 0

Size of pipe _____

Correct _____

Joseph Zmarier

Foreman.