

O. R.
NOTICE TO SUPERINTENDENT OF STREETS.

Drain Permit No. 10598

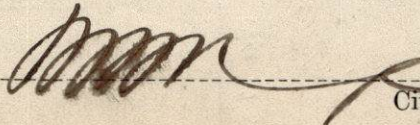
City of New Bedford,

Office of City Clerk, SEP 29 1911 191

To Superintendent of Streets.

Permission has this day been issued to

Name Peter Verhorne Address 36 Elm St. Fairhaven
to lay drain from premises of Peter Verhorne on the north
side of Aquidneck St. west of Brock Ave.
to connect with sewer in Aquidneck street.


City Clerk.

Return of Foreman.

Entered Nov 14 191 9

Time 1 P M

By Frank B De Kello

COST.

Labor	48 hours @ 50	24 00
	122 " 53	6 64
	6 " 69	4 13
		34 77
Stock	Cement	25
	Marl Jacinth	
	John Bruda	
	Distunfore	
Carting		50
Total Cost		35 52
Deposit		35 00
Balance due		52

Pieces pipe to curb 8

" " curb to house 1

Cut at Sewer 1 1/2 ft

Cut at curb 1 1/2 ft

Size of pipe 6 in

Correct

Frank B De Kello

Foreman.