

OK

NOTICE TO SUPERINTENDENT OF STREETS.

Drain Permit No. 10701

City of New Bedford,

Office of City Clerk,

DEC 10 1919

19

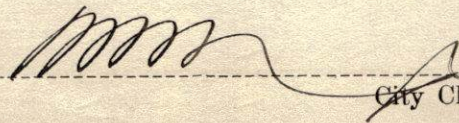
To Superintendent of Streets.

Permission has this day been issued to

Name John Borowicz Address 72 Kenyon St.

to lay drain from premises of John Borowicz, on the northwest
corner of Washburn & Bellville Ave.

to connect with sewer in Washburn street.


City Clerk.

Return of Foreman.

Entered Jan 5 1920
 Time 11 AM
 By Frank B DeMello

COST.

Labor	45 hours @ 50	22 50
	17 1/2 " 53	9 30
	6 " 69	4 13
	"	35 93
	"	
	"	
	"	
	"	
Stock	Cement	25
	Antoni L. Perrina	
	John J. Booy	
	Dirt surface	
Carting		
		36 18
Total Cost		
Deposit		35 00
Balance due		

Pieces pipe to curb 7
 " " curb to house 2
 Cut at Sewer 6 ft
 Cut at curb 4 ft
 Size of pipe 6 in
 Correct _____

Frank B DeMello
 Foreman.