

C. A.

NOTICE TO SUPERINTENDENT OF STREETS.

Drain Permit No. 11220

City of New Bedford,

AUG 15 1921

Office of City Clerk, _____ 19

To Superintendent of Streets.


Permission has this day been issued to

Name J. X Greiner Address 283 Sawyer St.

to lay drain from premises of J. X Greiner on the

south side of Whitman St. east of Hope St.

to connect with sewer in Whitman street;

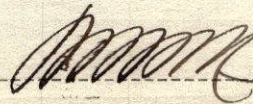


City Clerk.

Return of Foreman.

Entered August 23 1921.
 Time 11 AM
 By Frank H. DeMillo

COST.

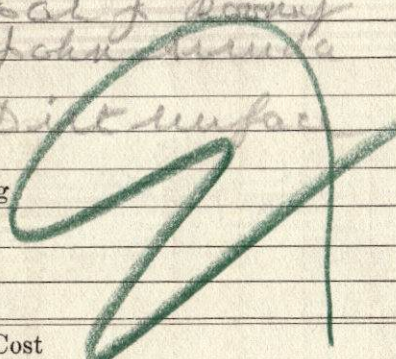Labor	21	hours @	59	12	47
	10	"	63	6	48
	2	"	78	1	56
		"		20	51
		"			
		"			
		"			
		"			
Stock	<u>basement</u>				50
	<u>for J. Downing</u>				
	<u>John Downing</u>				
	<u>Dirt surface</u>				
Carting					
				21	01
Total Cost					
Deposit				11	45
Balance due					

Pieces pipe to curb 7
 " " curb to house 6
 Cut at Sewer 8 ft
 Cut at curb 5 ft
 Size of pipe 6 in
 Correct

Frank H. DeMillo
 Foreman.