

6.R.
NOTICE TO SUPERINTENDENT OF STREETS.

Drain Permit No. 11647

City of New Bedford,

Office of City Clerk, MAY 10 1922 19

To Superintendent of Streets.

Permission has this day been issued to

Name

Joseph Lebeau

Address

106 Belleville Rd,

to lay drain from premises

Joseph Lebeau S.E. cor.

to connect with sewer in

Perry St. & Acushnet Ave
Perry street.

Requires separate entrance for sewage and roof water.

Rodolphus A Swan

City Clerk.

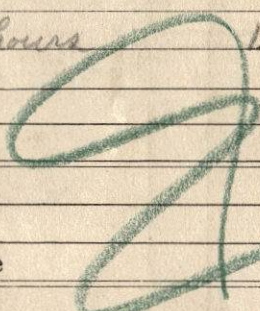
Return of Foreman.

Entered May 15 19 08

Time 3 P.M.

By John P. Daley

COST.

Labor	44	hours @	59	26	13
		"			
		"			
		"			
	2	"	78	1	56
		"			
		"		27	69
		"			
Stock	1/2 bag of cement			40	
	1 bag of sand			10	
	1.6 in cement cover			15	
Carting	2 hours	1 1/2	2	25	
				30	59
				60	00
				29	41
Total Cost					
Deposit					
Balance due					

Pieces pipe to curb 7

" " curb to house 7

Cut at Sewer 9

Cut at curb 6

Size of pipe 4 X 4 in

Correct

John P. Daley
Foreman.

Billed