

*C. R.*

**NOTICE TO SUPERINTENDENT OF STREETS.**

Drain Permit No. <sup>*11826*</sup>  
~~*11827*~~

City of New Bedford,

Office of City Clerk, *JUL 8 1922* 19

To Superintendent of Streets.

Permission has this day been issued to

Name *George H. Cornell* Address *988 Pleasant St*

to lay drain from premises *(Two lots) north side of Potter st.*  
*west of De Wolf st*

to connect with sewer in *Potter* street.

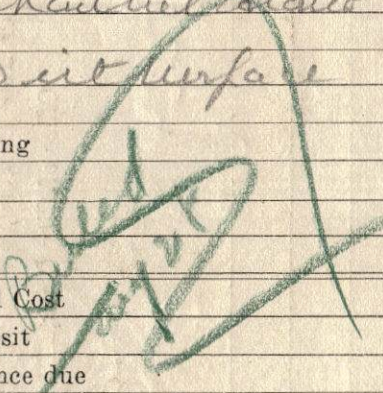
*James Dignam*  
City Clerk.

*Bureau Aug 21*

# Return of Foreman.

Entered August 22 19 22  
 Time 11 AM  
 By Frank C. DellaMolla

### COST.

Labor	254 hours @ 59	<del>14</del>	<del>25</del>
	82 " 63	5	31.
	2 " 78	1	56.
	"	<del>2</del>	<del>12</del>
	"	22	01
	"		
	"		
Stock	<u>6 cement</u>		50
	<u>Stone &amp; Reinforcing</u>		
	<u>Channel &amp; other</u>		
	<u>Dirt surface</u>		
Carting			50
			
Total Cost		23	01
Deposit		100	-
Balance due			

7699

Pieces pipe to curb 1  
 " " curb to house 1  
 Cut at Sewer 8 ft  
 Cut at curb 6 ft  
 Size of pipe 6 in  
 Correct

Frank C. DellaMolla  
 Foreman.