

NOTICE TO SUPERINTENDENT OF STREETS.

6.R.
Drain Permit No. 12033

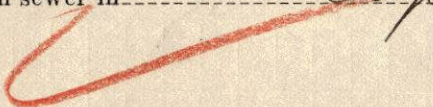
City of New Bedford,

Office of City Clerk, OCT 4 1922 19

To Superintendent of Streets.

Permission has this day been issued to

Name James F Griffiths Address 208 Hudson St.
to lay drain from premises of J F Griffiths on the north
side of Capitol St, west of Brock Ave.
to connect with sewer in Capitol street.


Rodolphus A Swan

City Clerk.

Return of Foreman.

Entered Nov 15 19 22
 Time 1 P.M.
 By Frank B. DeMillo

COST.

Labor	30 hours @ 59	17 81
	1 1/2 " 63	4 69
	3 " 78	2 34
	"	24 84
	"	
	"	
	"	
	"	
Stock	Cement	50
	Cement Gasolene	
	Thor O'Donnell	
	Dirt surface	
Carting		50
Total Cost		25 84
Deposit		60 00
Balance due	Griffiths	34 16

Pieces pipe to curb 18
 " " curb to house 7
 Cut at Sewer 8 ft
 Cut at curb 6 ft
 Size of pipe 6 in
 Correct _____

Frank B. DeMillo
 Foreman.