

NOTICE TO SUPERINTENDENT OF STREETS.

Drain Permit No. 12429

City of New Bedford,

Office of City Clerk, MAY 11 1923 19

To Superintendent of Streets.

Permission has this day been issued to.

Name Alfred E. Rainford Address 88.7 Rockdale Ave

to lay drain from premises south side Milton west
of Rockdale Ave.

to connect with sewer in Milton street.

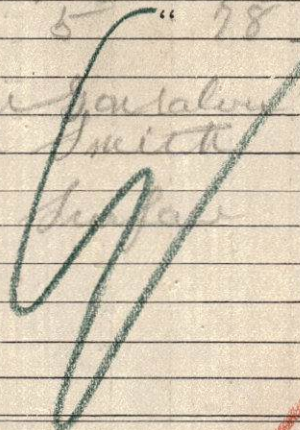
Rodolphus A. [Signature] City Clerk.

Carroll 6/11

Return of Foreman.

Entered June 22 1923
 Time 11 AM
 By Frank B. DeMilla

COST.

Labor	8	hours @	59	4	75
	2	"	63	1	25
	1	"	78		78
		"		6	78
		"			
	3 1/2	"	59	18	71
	1 1/2	"	63	7	19
	5	"	78	3	91
Stock				36	59
					
Carting					50
Total Cost				37	09
Deposit				60	
Balance due					

Pieces pipe to curb 7
 " " curb to house 6
 Cut at Sewer 8 ft
 Cut at curb 6 ft
 Size of pipe 6 in
 Correct _____

Frank B. DeMilla
 Foreman.