

P.K.
NOTICE TO SUPERINTENDENT OF STREETS.

Drain Permit No. *12352*

City of New Bedford,

Office of City Clerk, *JUL 6 1923* 19

To Superintendent of Streets.

Requires separate entrance for sewage and roof water
Permission has this day been issued to

Name *George E. Tremblay* Address *89 Sylvia St.*

to lay drain from premises *of Geo. E. Tremblay, on the north side*

of Sylvia St. betw. River Rd. & Belleville Av.

to connect with sewer in *Sylvia* street.

Rodolphus A. [Signature]
City Clerk.

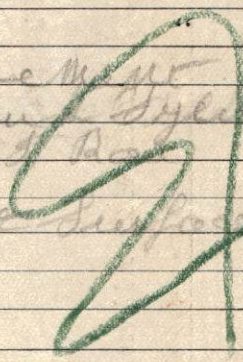
Return of Foreman.

Entered August 17 1923

Time 3 P.M. Frank B. DeHelle

By Frank B. DeHelle

COST.

Labor	62	hours @	59	36	81
	13	"	63	8	38
	5	"	78	3	13
		"		48	91
		"			42
		"			80
		"			
		"			
		"			
Stock					50
Carting					50
Total Cost					49 85
Deposit					60
Balance due	Tremblay.				10 15

Pieces pipe to curb 7

" " curb to house 7

Cut at Sewer 8 ft

Cut at curb 2 ft

Size of pipe 6 in

Correct

Frank B. DeHelle
Foreman.