

OK.

NOTICE TO SUPERINTENDENT OF STREETS.

Drain Permit No. 12797

City of New Bedford,

OCT 17 1923

Office of City Clerk, -----19

To Superintendent of Streets.

Permission has this day been issued to

Name Angelina Grasseler Address 410 Wood St.

to lay drain from premises east side of Baylies street
north of Wood street.

to connect with sewer in Wood street.

Jennet Dignam
Asst. City Clerk.


Return of Foreman.

Entered Nov 24 1903
 Time 7 1/2 AM
 By _____

COST.

Labor	89 1/4 hours @ 59	53	14
	52 " 63	32	50
	27 1/4 " 78	21	48
	"	107 1/2	
	"		
Stock			
2 Bags Cement		2	00
Surface 9' of Penn Macadam			
2 ft. 12 ft			
12 ft. pen mac to 1.11			
3.32 + 5.00		18	32
Carting			
Total Cost		127	44
Deposit		125	00
Balance due	City	2	44

Pieces pipe to curb 7
 " " curb to house 53
 Cut at Sewer 8 ft 11 in
 Cut at curb 7 ft 3 in
 Size of pipe 6 in
 Correct _____

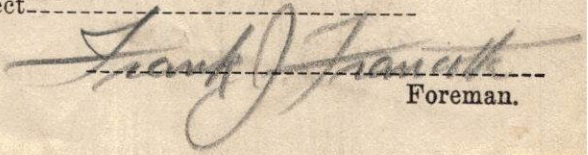

 Foreman.