

NOTICE TO SUPERINTENDENT OF STREETS.

Drain Permit No. 13034

City of New Bedford,

Office of City Clerk,

Handwritten: MAY 9 - 1924

19

To Superintendent of Streets.

Permission has this day been issued to

Name

Benj. A. Gomes

Address

466 Mayfield

to lay drain from premises

Benj. A. Gomes, 466 Mayfield

St. W. Liberty St.


to connect with sewer in

Mayfield

street;

Rodolphus A. Swan

City Clerk.

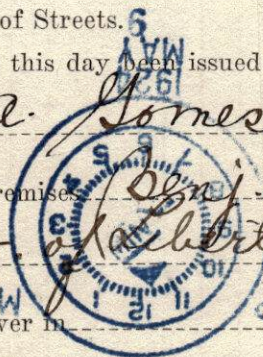

Handwritten: Paid

Return of Foreman.

Entered May 14 19 24
 Time 1 P.M.
 By Frank B. De Mello

COST.

Labor	34½ hours @ 59	20	48
	12 " 63	7	50
	4 " 78	3	13
	"	31	11
	"		
	"		
	"		
	"		
Stock	6 cement		50
	Frank's Sylex		
	Wm. Fr. Hall		
	Dirt surface		
Carting			50
Total Cost		321	1
Deposit		60	=
Balance due		27	89

Pieces pipe to curb 7
 " " curb to house 4
 Cut at Sewer 7 ft
 Cut at curb 6 ft
 Size of pipe 6 in
 Correct _____

Frank B. De Mello
 Foreman.