

NOTICE TO SUPERINTENDENT OF STREETS.

Drain Permit No. 13273

City of New Bedford,

Office of City Clerk,

AUG 19 1924 19

To Superintendent of Streets.

Permission has this day been issued to

Name Bronislaw Mogelnicki Address 269 Wood street


to lay drain from premises Bronislaw Mogelnicki, S. S. Branscomb
street, between Conduit and Felton

to connect with sewer in Branscomb street;

Rodolphus A. Swan
City Clerk.

Requires separate entrance for sewage and roof water

Card O. H.
Aug. 19, 1924

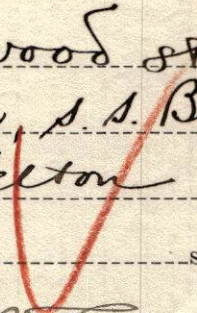

Return of Foreman.

Entered Sept. 3rd 19 24
Time 2 p.m.
By John P. Dulan

COST.

[illegible]

Stock	1/2 bag of cement 1 bag of sand	50
-------	------------------------------------	----

Carting	3 hours	3	00
---------	---------	---	----

Total Cost	91	10
------------	----	----

Deposit	14	60	—
---------	----	----	---

Balance due	28.90
Pieces nine to curb	

Pieces pipe to curb--4-----

“ “ curb to house 6-----

Cut at Sewer 8.25

Cut at curb 60 1/2 ft

Size of pipe—6 X 4"

Correct_____

John P. Daley
Foreman.