

NOTICE TO SUPERINTENDENT OF STREETS.

Drain Permit No. 13280

City of New Bedford,

Office of City Clerk, AUG 21 1924 19

To Superintendent of Streets.

Permission has this day been issued to

Name Abbott P. Smith Address 95 Hawthorn St.


to lay drain from premises A. P. Smith, e. s. Meriam St.,

n. of Bedford St.

to connect with sewer in Meriam street;

Rodolphus Swan
City Clerk.

Card O. K.
Aug. 21, 1924

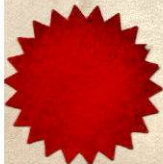


Return of Foreman.

Entered Aug 25 19 28
 Time 1:30 PM
 By _____

COST.

Labor	11 hours @ 59	6 53
	"	
	20 " 63	12 50
	"	
	5 " 78	3 91
	"	
	"	22 94
	"	
Stock		
	1/2 Bag Cement	50
	Earth Dm. face	
Carting		
Total Cost		23 44
Deposit		45
Balance due		21 56

Pieces pipe to curb
 " " curb to house
 Cut at Sewer
 Cut at curb
 Size of pipe
 Correct

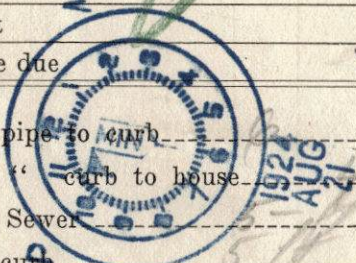

L. J. Hamilton
 Foreman.