

NOTICE TO SUPERINTENDENT OF STREETS.

Drain Permit No. 13296

City of New Bedford,

Office of City Clerk, AUG 27 1924 19

To Superintendent of Streets.

A Permission has this day been issued to

Name Victoria C. Durand

Address 23 Baylies st.

to lay drain from premises Victoria C. Durand, n. s. Branscomb
st. west of Felton street

to connect with sewer in Branscomb street;

James Dignam
City Clerk.

Requires separate entrance for sewage and roof water.


1924
AUG
27



Return of Foreman.

Entered Sept 4th 19 21
 Time 9 a. m
 By John P. Daley
 COST.

Labor	38	hours @	59	22	56
	6	"	63	3	75
	4	"	78	3	13

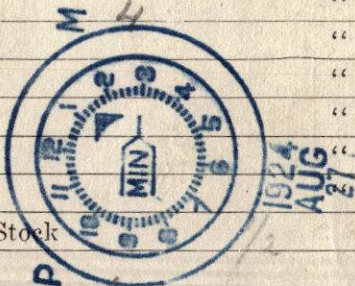

Stock

1/2 bag of cement
1 bag of sand

Carting	2 hours	2	00
---------	---------	---	----

Total Cost	31	94
Deposit	\$ 60	-
Balance due	28	06

Pieces pipe to curb 6
 " " curb to house 7
 Cut at Sewer 8
 Cut at curb 6 1/2
 Size of pipe 6 X 4 in
 Correct

John P. Daley
 Foreman.