

NOTICE TO SUPERINTENDENT OF STREETS.

Drain Permit No. 13423

City of New Bedford,

Requires separate entrance for sewage and roof water

Office of City Clerk, NOV 15 1924 19

To Superintendent of Streets.

Permission has this day been issued to

Name Frauk D. Leger


Address 103 Central Ave

to lay drain from premises of Frauk D. Leger S. S. Shaw

betw Codding & Acushnet ave

to connect with sewer in Shaw street;

Rodolphus Swan
City Clerk.

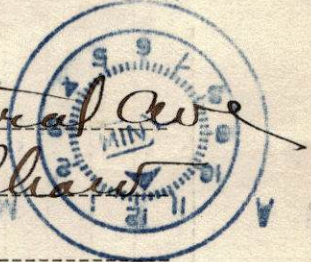

Return of Foreman.

Entered Dec 3 19 24
 Time 4 P.M.
 By Frank B De Mello

COST.

Labor	53 1/2	hours @	59	31	77 1/2
	13 1/2	"	63	8	44
	6	"	78	4	69
		"		44	90
		"			
		"			
		"			
		"			
Stock	<u>be more</u>				50
	<u>Antony J. Pereira</u>				
	<u>Chas Smith</u>				
	<u>Dirt Surface</u>				
Carting					50
Total Cost				45	90
Deposit				60	—
Balance due				14	10

Pieces pipe to curb 7
 " " curb to house 8
 Cut at Sewer 7 ft
 Cut at curb 7 ft
 Size of pipe 6 in
 Correct _____

Frank B De Mello
 Foreman.