

NOTICE TO COMMISSIONER OF PUBLIC WORKS

Drain Permit No. **16312**

City of New Bedford,

Office of City Clerk, *Feb. 26, 1953*

To Commissioner of Public Works.

Permission has this day been issued to

Cecilia V. Roczatek
Property owner


2112 Acushnet Ave.
Address

By _____

Address

to lay drain from the premises of

Cecilia V. Roczatek
e.s. of Pleasant St, 140' n. of Austin St.
to connect with the sewer in *Pleasant* street.

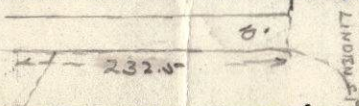

Charles W. De...
City Clerk.

~~Requires separate entrance for sewage and roof water~~

RETURN OF FOREMAN

Entered 3/3/ 19 53

Time 2:00 P.M.

By Peter J. Hodgins

COST

Labort	HODGINS, P.-	33 hours @ 1.40	46 20
	CARDOLA, G.-	33 " 1.21	39 93
	MARTIN, G.-	33 " 1.21	39 93
	Feliciano, F.-	33 " 1.21	39 93
	"	"	165 99
	"	"	
	"	"	
	"	"	
Stock	5 cement		63
	2 lbs putty		49
	1 sand		07
	Tek		3 00
Trucking	1/2 Compactor		3 00
	Rep - 300 yds gravel @ 3.		9 00
	Rep - 22 ft Bit conc		
	222 + 5		53 84
Total Cost			236.02
Estimate—cost of laying drain		125 00	
Entrance charges			
Total deposit		125 00	
Balance due	City		61 02

Pieces. pipe to curb 13

" " curb to house 8 Bit conc.

Cut at sewer 24 x 2 Pen. Trac.

Cut at curb 2 4 x 4 Heavy Squares

Size of pipe 6"

Correct

Peter J. Hodgins
Foreman