

Billed 11/14/63

40

NOTICE TO COMMISSIONER OF PUBLIC WORKS

2 pipe system

Drain Permit **Nº 18129**

City of New Bedford,

~~Office of City Clerk~~

Office of City Clerk, July 16, 1963

To Commissioner of Public Works.

Permission has this day been issued to

Henry J. Valais
Property owner

984 Fox St
Address

By

.....
Address

to lay drain from the premises of Henry J. Valais
ns. side Lucy St. 38' e. of Bartlett St.

to connect with the sewer in Lucy Charles W. Deary street.

Charles W. Deary
City Clerk.

lower depth
9'

7.12.63

83

(ab)

From main in street to iron pipe in property.

Requires separate entrance for sewage and roof water

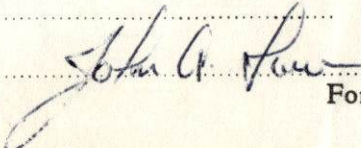
RETURN OF FOREMAN

Entered Oct. 3RD 19 63
 Time
 By

COST

Labor <u>Jan, J - 3 hours @ 2.00</u>	8	.600
<u>Amaral, M - 8 "</u>	1.80	14.40
<u>Orlowski - 8 "</u>	1.50	12.00
<u>Medeiros, E - 8 "</u>	1.80	14.40
<u>Rothwell, J - 1 "</u>	1.80	1.80
" "		48.60 ✓
" "		
Stock <u>1/2 BAG - CEMENT @ 1.42</u>		71 ✓
<u>100 LBS - SAND @ .0725 wt</u>		08 ✓
<u>1 HA #29 - TRUCK</u>		
Trucking <u>2 hrs @ 60¢</u>		1.20
<u>1 HA #39 - TRUCK</u>		
<u>7432 #32 - CITY - BARRAGE @ 5.40</u>		39.80 ✓
Total Cost		88.39
Estimate-cost of laying drain	242 -	
Entrance charges <u>Assessed</u>		
Total deposit	242 -	
Balance due <u>Value</u>		153.61

Refund 8-15-14-1-3 FT-4 IN
 Pieces pipe to curb 1-10 FT-1 1/2 FT-6 IN
 " " curb to house 2-10 FT-1-5 FT-6 IN
 Cut at sewer 9 FT.
 Cut at curb 8 1/2 FT.
 Size of pipe EX 4-IN - TRANSLITE - PIPE
 Correct


 Foreman

OWNED - SUPPLIED - MADE