

NOTICE TO COMMISSIONER OF PUBLIC WORKS

70

Length of drain 43

Filed 10/19/67 

Sewer depth 7 1/2

1 pipe system

Surf. drain —

Drain Permit **N^o 18775**

City of New Bedford,

Office of City Clerk, 8-8-67

To Commissioner of Public Works.

Permission has this day been issued to

JOHN FLAHERTY
Property owner

31 STONE ST.
Address

By —

—
Address

to lay drain from the premises of JOHN FLAHERTY

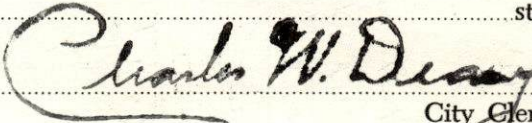
W. SIDE BURNS ST., 260' ± N. OF ALLEN ST.

to connect with the sewer in BURNS ST. street.

Laid from main in street to iron pipe in property.

Owner agrees to supply all necessary

TRANSIT pipe.


City Clerk.

Requires separate entrance for sewage and roof water



RETURN OF FOREMAN

Entered.....OCT-5TH.....1967

Time.....

By.....John A. Law

COST

Labor	hours	@	
Thibault, J. -	6 "	2.40	\$14.38
Howard, J. -	6 "	2.22	13.29
Pinette, J. -	6 "	2.24	13.44
Rivard, A. -	6 "	2.19	13.14
			\$54.25 ✓

Stock 1/2 BAG CEMENT @ 1.40	70 ✓
100 LBS SAND	09 ✓
REPAIR - 10 FT x 2 FT - B-C-ON-ROAD	
@ 2.22 + 5	27 20

2 WAS # 33 BACKHOE

Trucking

1 HD # 21 - COMPRESSOR	3 35 ✓
2 HD # 29 - TRUCK @ 60¢	1 20
3 HD # 32 - BACKHOE @ 51.85	29 25 ✓

Total Cost

Estimate-cost of laying drain

Entrance charges ASSESSED

Total deposit

Balance due

Pieces pipe to curb 1-10 FT-1-2 FT- 6-IN

" " curb to house 2-10 FT-1-8 FT 6-IN

Cut at sewer 8 FT

Cut at curb 7 1/2 FT

Size of pipe 6-IN-TRANSITE-PIPE

Correct

Foreman

OWNER - SUPPLIED - VINE