 
CITY OF NEW BEDFORD

APPLICATION FOR LAYING DRAIN

Application Nº 19037	Board of Health Permit No
	New Bedford, Mass., July 28, 1969
To the Mayor and City Council: I hereby request that a drain be laid fro	om the premises of Mrs Lilly Thorps
es, Worcester St. 60	nof Tarkels I tell Rd.
to connect with the sewer inthe same to be laid in the street and the su Works.	Street, urface repaired as directed by the Commissioner of Public
I hereby agree to pay at the office of the manner specified, in excess of the depositive work.	e City Treasurer all cost of performing the above work in sit made herewith, within 10 days after the completion of
payment of the cost of performing the worl be returned to me by the City Treasurer.	leposit made with this application shall be applied to the k done, and that any excess of deposit over the cost shall
Witness K Rodereck	Property owner
	Address
Ву	Lily Thorpe
Requires separate entrance for roof water	Lily Thorpe 569 Tartilu Hill Rd. Address
Consent of (Owner of Private Drain
To the Mayor and City Council:	New Bedford, Mass.,
through the private drain owned by me con	necting with sewer in
	street.
	Owner
Estimate an	d Deposit Requirement
	Commissioner of Public Works,
My estimate of the cost of laying the dr	rain described in the above application is
Assessed Entrance charges \$15.00	Total deposit required
	Commissioner of Public Works
Cer	tificate of Issue
	Office of City Clerk,
The above application, accompanied by	City Treasurer's receipt presented this day; whereupon
-	ued, and the Commissioner of Public Works notified of the
same.	Grades VV. Denny
Laid from main in street to iron pipe in property.	City Clerk
Owner agrees to supply all necessary	\bigvee



NOTICE TO COMMISSIONER OF PUBLIC WORKS	
Length of drain 20 Billed 192469 (2)	
Sewer depthpipe system	
Surf. drain	
Drain Permit No. 19037 City of New Bedford,	
To Commissioner of Public Works. Office of City Clerk, July 28, 1969	
Permission has this day been issued to	
Mrs. Lely Thorse 569 Jarkela Hill. Rd	1
Property owner Address	
By same Same	
to lay drain from the premises of Mrs Lelly Thorse:	,
es Worcester St. 60 hof Tarkela delle Rd	
to connect with the sewer in Worcestie street.	
Owner agrees to supply all necessary	
Viangete pipe. City Clerk	
Partition compared automorphism and uniformity	

6/75 RETURN	OF	FOI	REMAI	N	
Entered SE	P.T	18 ^{TI}	1	19	69
Time		A			
Ву	Jo A	uly	Low	_	
	COS		J-TAVI		
Labor		hours	@		
Cavares, J	5	"	2.65	\$13	.25
llfonso, J	5	"	2.50	12	.50
Jardin, J	5	"	2.35	11	75
Botelho, E	5	"	2.40	11	.00
imbra, J	0	"	2.46	-	25
		"		\$61	.79~
Stock /2 BAC-CO	er Ci	" EMER	TQ15	1	79
COXBS-SAND				-	070
EPLACE-10FTX2 FT	B-C-	on -R	VAD	-	
(e) 2.	22	- 		0	20
Trucking	te .				60
HES # 10 TRUCK	0		,	3	31
125 14-COMPRESSO	-),6	10	54	100
CJ-BACKHOE	0	2.0	L.	F.	0 5
Total Cost		. 11	ali	110	1121
Estimate-cost of lay	ing dra	ain	1500	-	
Total deposit	-		111	-	
Balance due	ty.		5 / 1	22	20
Pieces pipe to curb	1/16.1	9-1-	-2FT-(/N	
" " curb to	house	1-10F	T-1-3-F	1-6-1	N
Cut at sewer		and the same of th			
Cut at curb	7.11		,	3 0	
Size of pipe	(T.R.A	NSITE	-PIPE		
Correct		0 /			
	SA	hu	CR. :	Lucy	_
***************************************	//			Foren	nan