

CITY OF NEW BEDFORD
APPLICATION FOR LAYING DRAIN

Application **Nº 19103** permit # 19172
08/20/1970 Board of Health Permit No. Dec 4, 1969
New Bedford, Mass.,

To the Mayor and City Council:

I hereby request that a drain be laid from the premises of U.S. Invest & Development Corp
200 Coggeshall St. 200' E of Myrtle St.

to connect with the sewer in Coggeshall street,
the same to be laid in the street and the surface repaired as directed by the Commissioner of Public Works.

I hereby agree to pay at the office of the City Treasurer all cost of performing the above work in the manner specified, in excess of the deposit made herewith, within 10 days after the completion of the work.

It is understood and agreed that the deposit made with this application shall be applied to the payment of the cost of performing the work done, and that any excess of deposit over the cost shall be returned to me by the City Treasurer.

Witness L. Roderick U.S. Development & Development Corp
Property owner
Cranston R.I.
Address
By Joseph Francis
P.O. Box 57 Warren, R.I.
Address

Requires separate entrance
for roof water

Consent of Owner of Private Drain

New Bedford, Mass.,

To the Mayor and City Council:

I hereby grant to
the privilege of draining premises

through the private drain owned by me connecting with sewer in
street.

Owner

Estimate and Deposit Requirement

Office of Commissioner of Public Works,

My estimate of the cost of laying the drain described in the above application is

\$ 301.00

Assessed
~~Entrance charges~~

Total deposit required \$ 301.00

Edmund J. Loomis
Commissioner of Public Works


Certificate of Issue

Office of City Clerk,

The above application, accompanied by City Treasurer's receipt presented this day; whereupon
Permit No. 19103 was issued, and the Commissioner of Public Works notified of the same.

mtl
Laid from main in street to iron pipe in property.
Owner agrees to supply all necessary
transit pipe.

Frank W. Deary
City Clerk

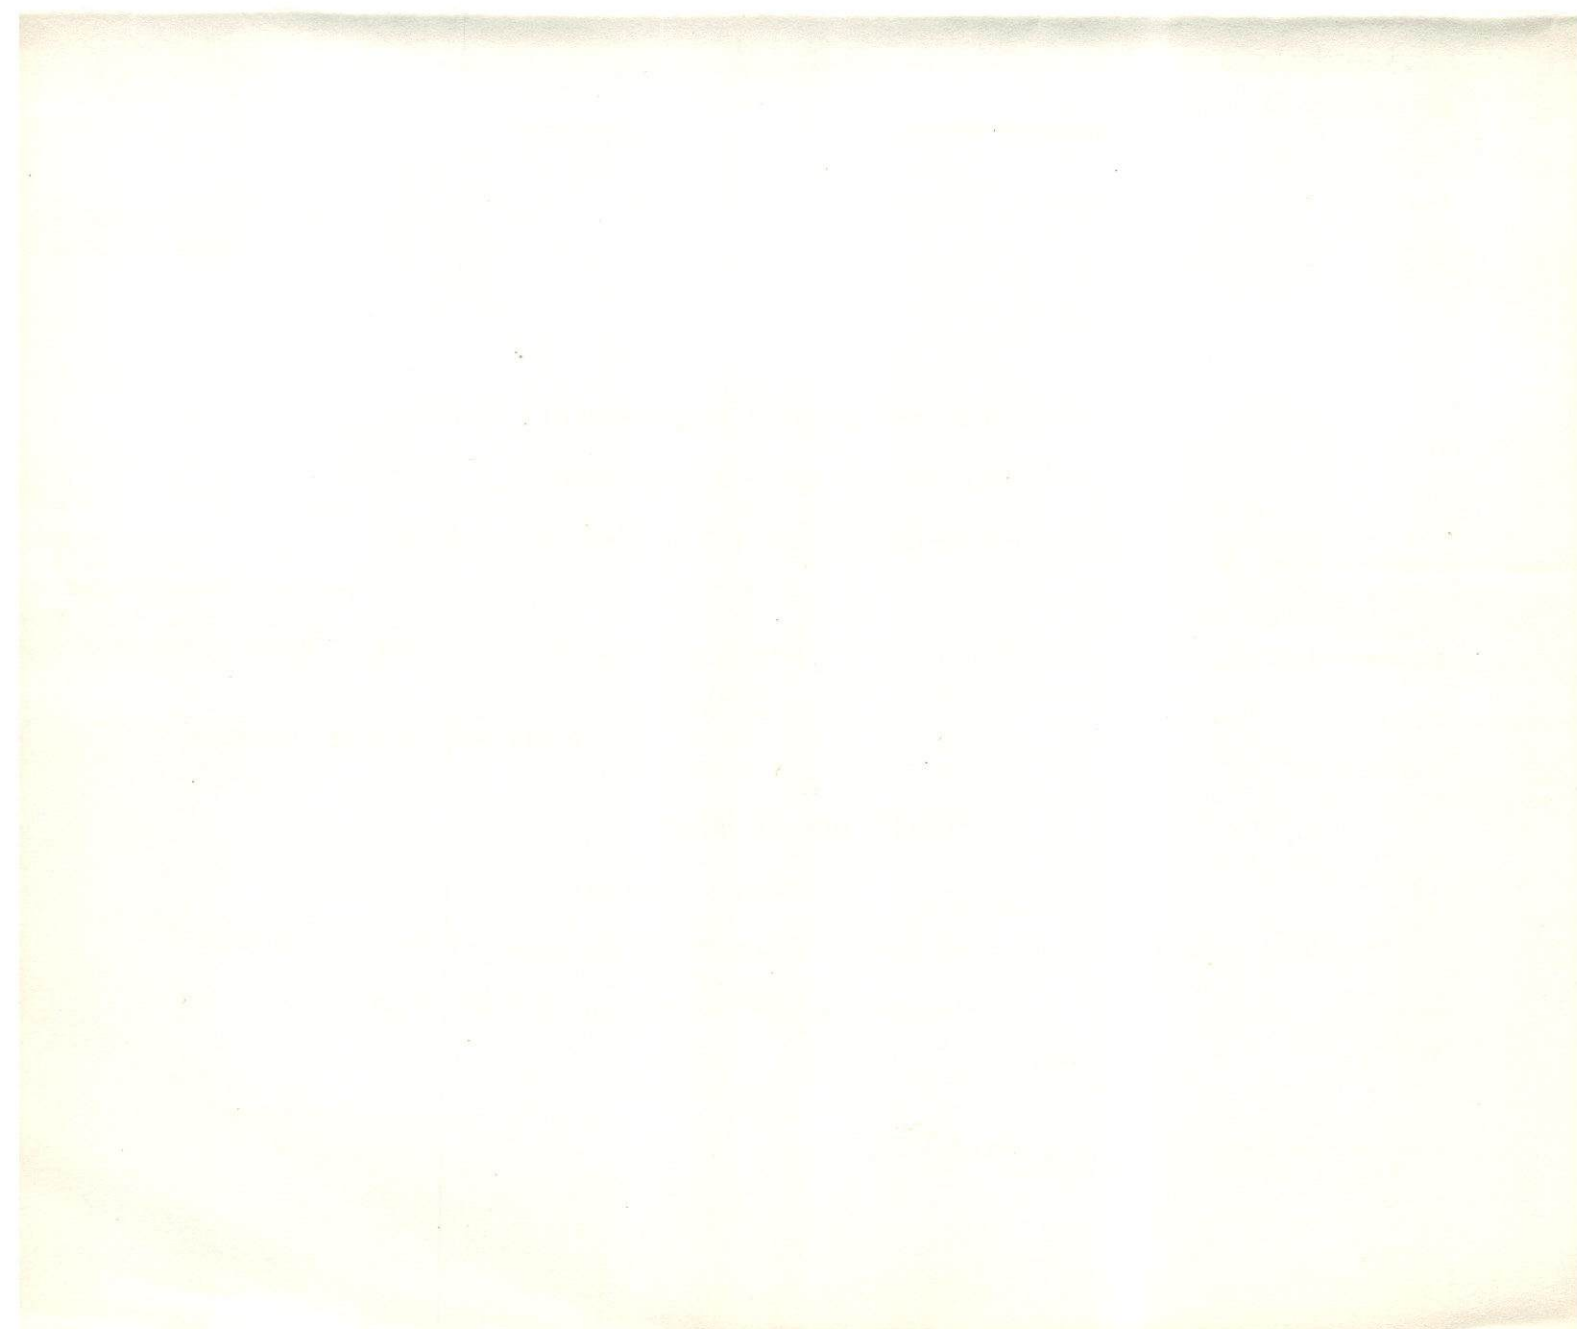

NOTICE TO COMMISSIONER OF PUBLIC WORKS

Billed 12/30/69 (2)

Length of drain.....60'

Sewer depth.....8'

Surf. drain.....-

.....1 pipe system

Drain Permit **Nº 19103**

City of New Bedford,

Office of City Clerk,

Dec 4, 1969

To Commissioner of Public Works.

Permission has this day been issued to

U.S. Investment & Development Corp. Cranston, R.I.

Property owner

Address

By Fairlawn Excavating Inc. P.O. Box 57 Warren, R.I.

U.S. Investment & Development Corp.

Address

to lay drain from the premises of N.S. Coggeshall St.

200' e. Myrtle St.

to connect with the sewer in Coggeshall street.

✓ Laid from main in street to iron pipe in property.

✓ Owner agrees to supply all necessary

transite

pipe.

City Clerk.

Requires separate entrance for sewage and roof water

Laid

mm

RETURN OF FOREMAN

Entered DEC-10TH 19 69
 & Dec. 12
 Time
 By John P. Law

COST

Labor	hours	@	
Thibault, J. - 4	"	2.50	\$10.00
Alfonso, J. - 12	"	2.50	30.00
Botelho, E. - 12	"	2.40	28.80
Ambra, J. - 12	"	2.46	29.40
Tavares, J. - 8	"	2.65	21.20
Reedy, J. - 8	"	2.39	19.10
			<u>\$138.50</u> ✓

Stock <u>1/2 BAG-CEMENT @ 1.57</u>	79	✓
<u>100 LBS-SAND</u>	09	✓
<u>REPLACE-12 FT X 3 FT B-C-ON-ROAD</u>		
<u>@ 2.22 + 5</u>	3164	

Trucking

1 <u>WASH 44-COMPRESSOR</u>	3	35	✓
2 <u>WASH 10-TRUCK @ 6.00</u>	1	20	
3 <u>WASH 65-BACKHOE @ 6.10</u>	48	80	✓
Total Cost		<u>224.40</u>	

Estimate-cost of laying drain

301-

Entrance charges Assess

-

Total deposit

301-

Balance due

Lawson

7660

Pieces pipe to curb 1-10 FT-1-2 FT-8-IN

" " curb to house 4-10 FT-1-5 FT-8-IN

Cut at sewer 8 1/2 FT

Cut at curb 8 FT

Size of pipe 8-IN-TRANSITE-PIPE

Correct

John P. Law
 Foreman